
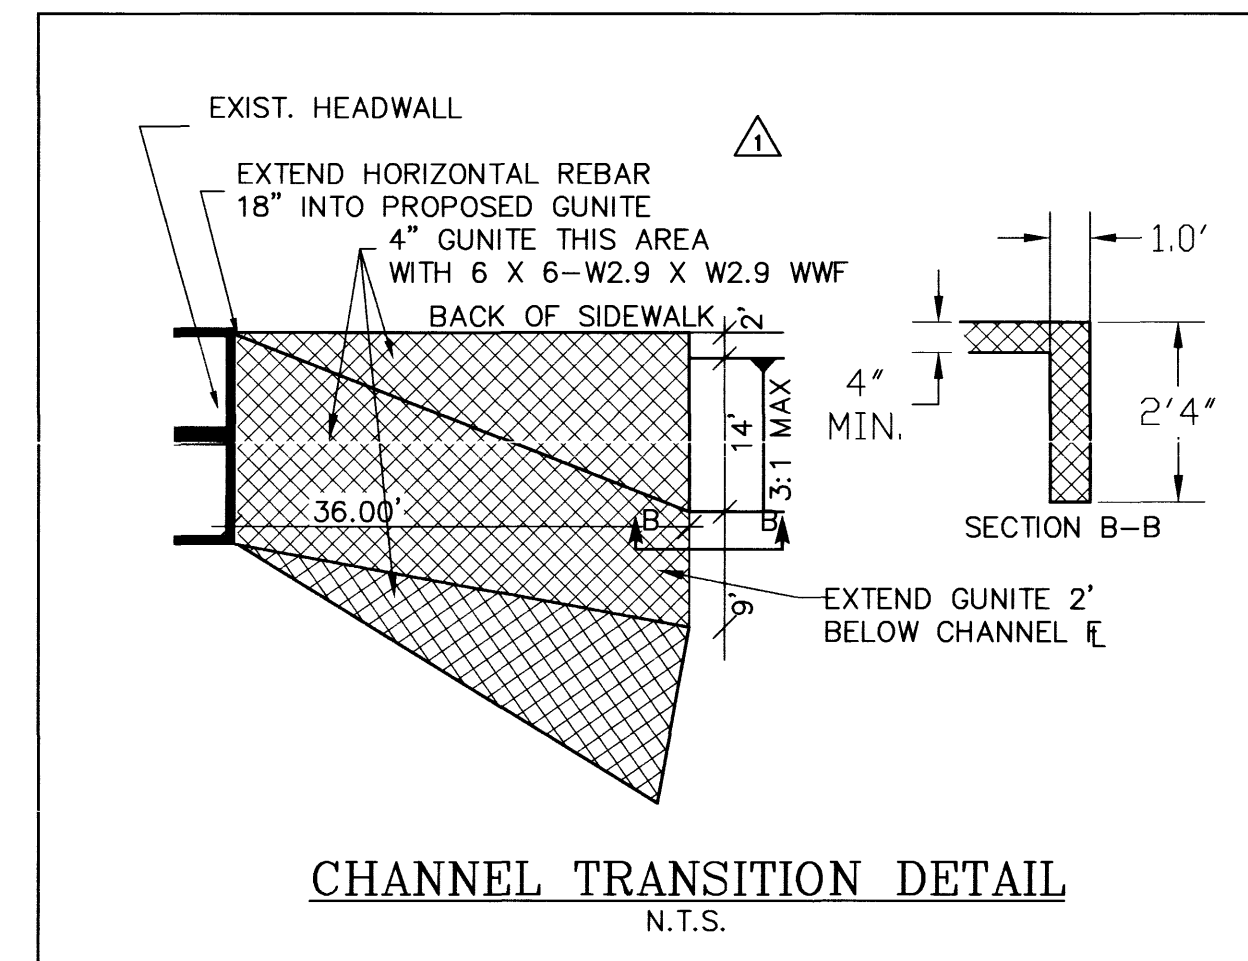
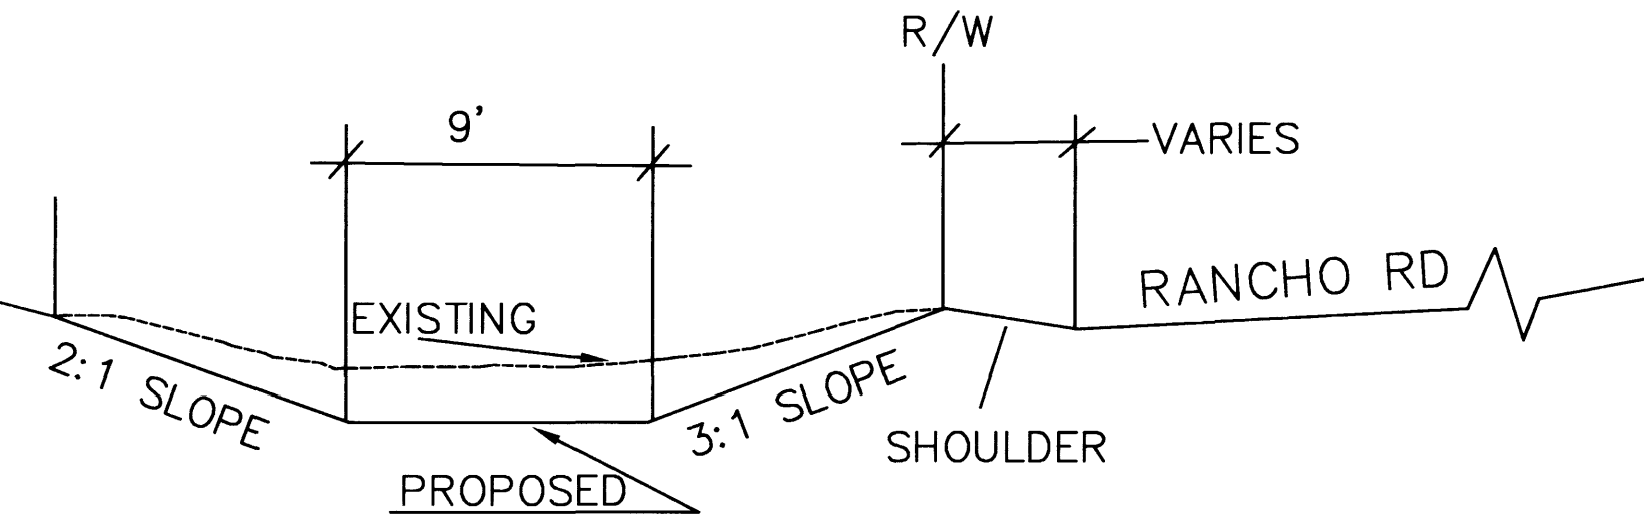
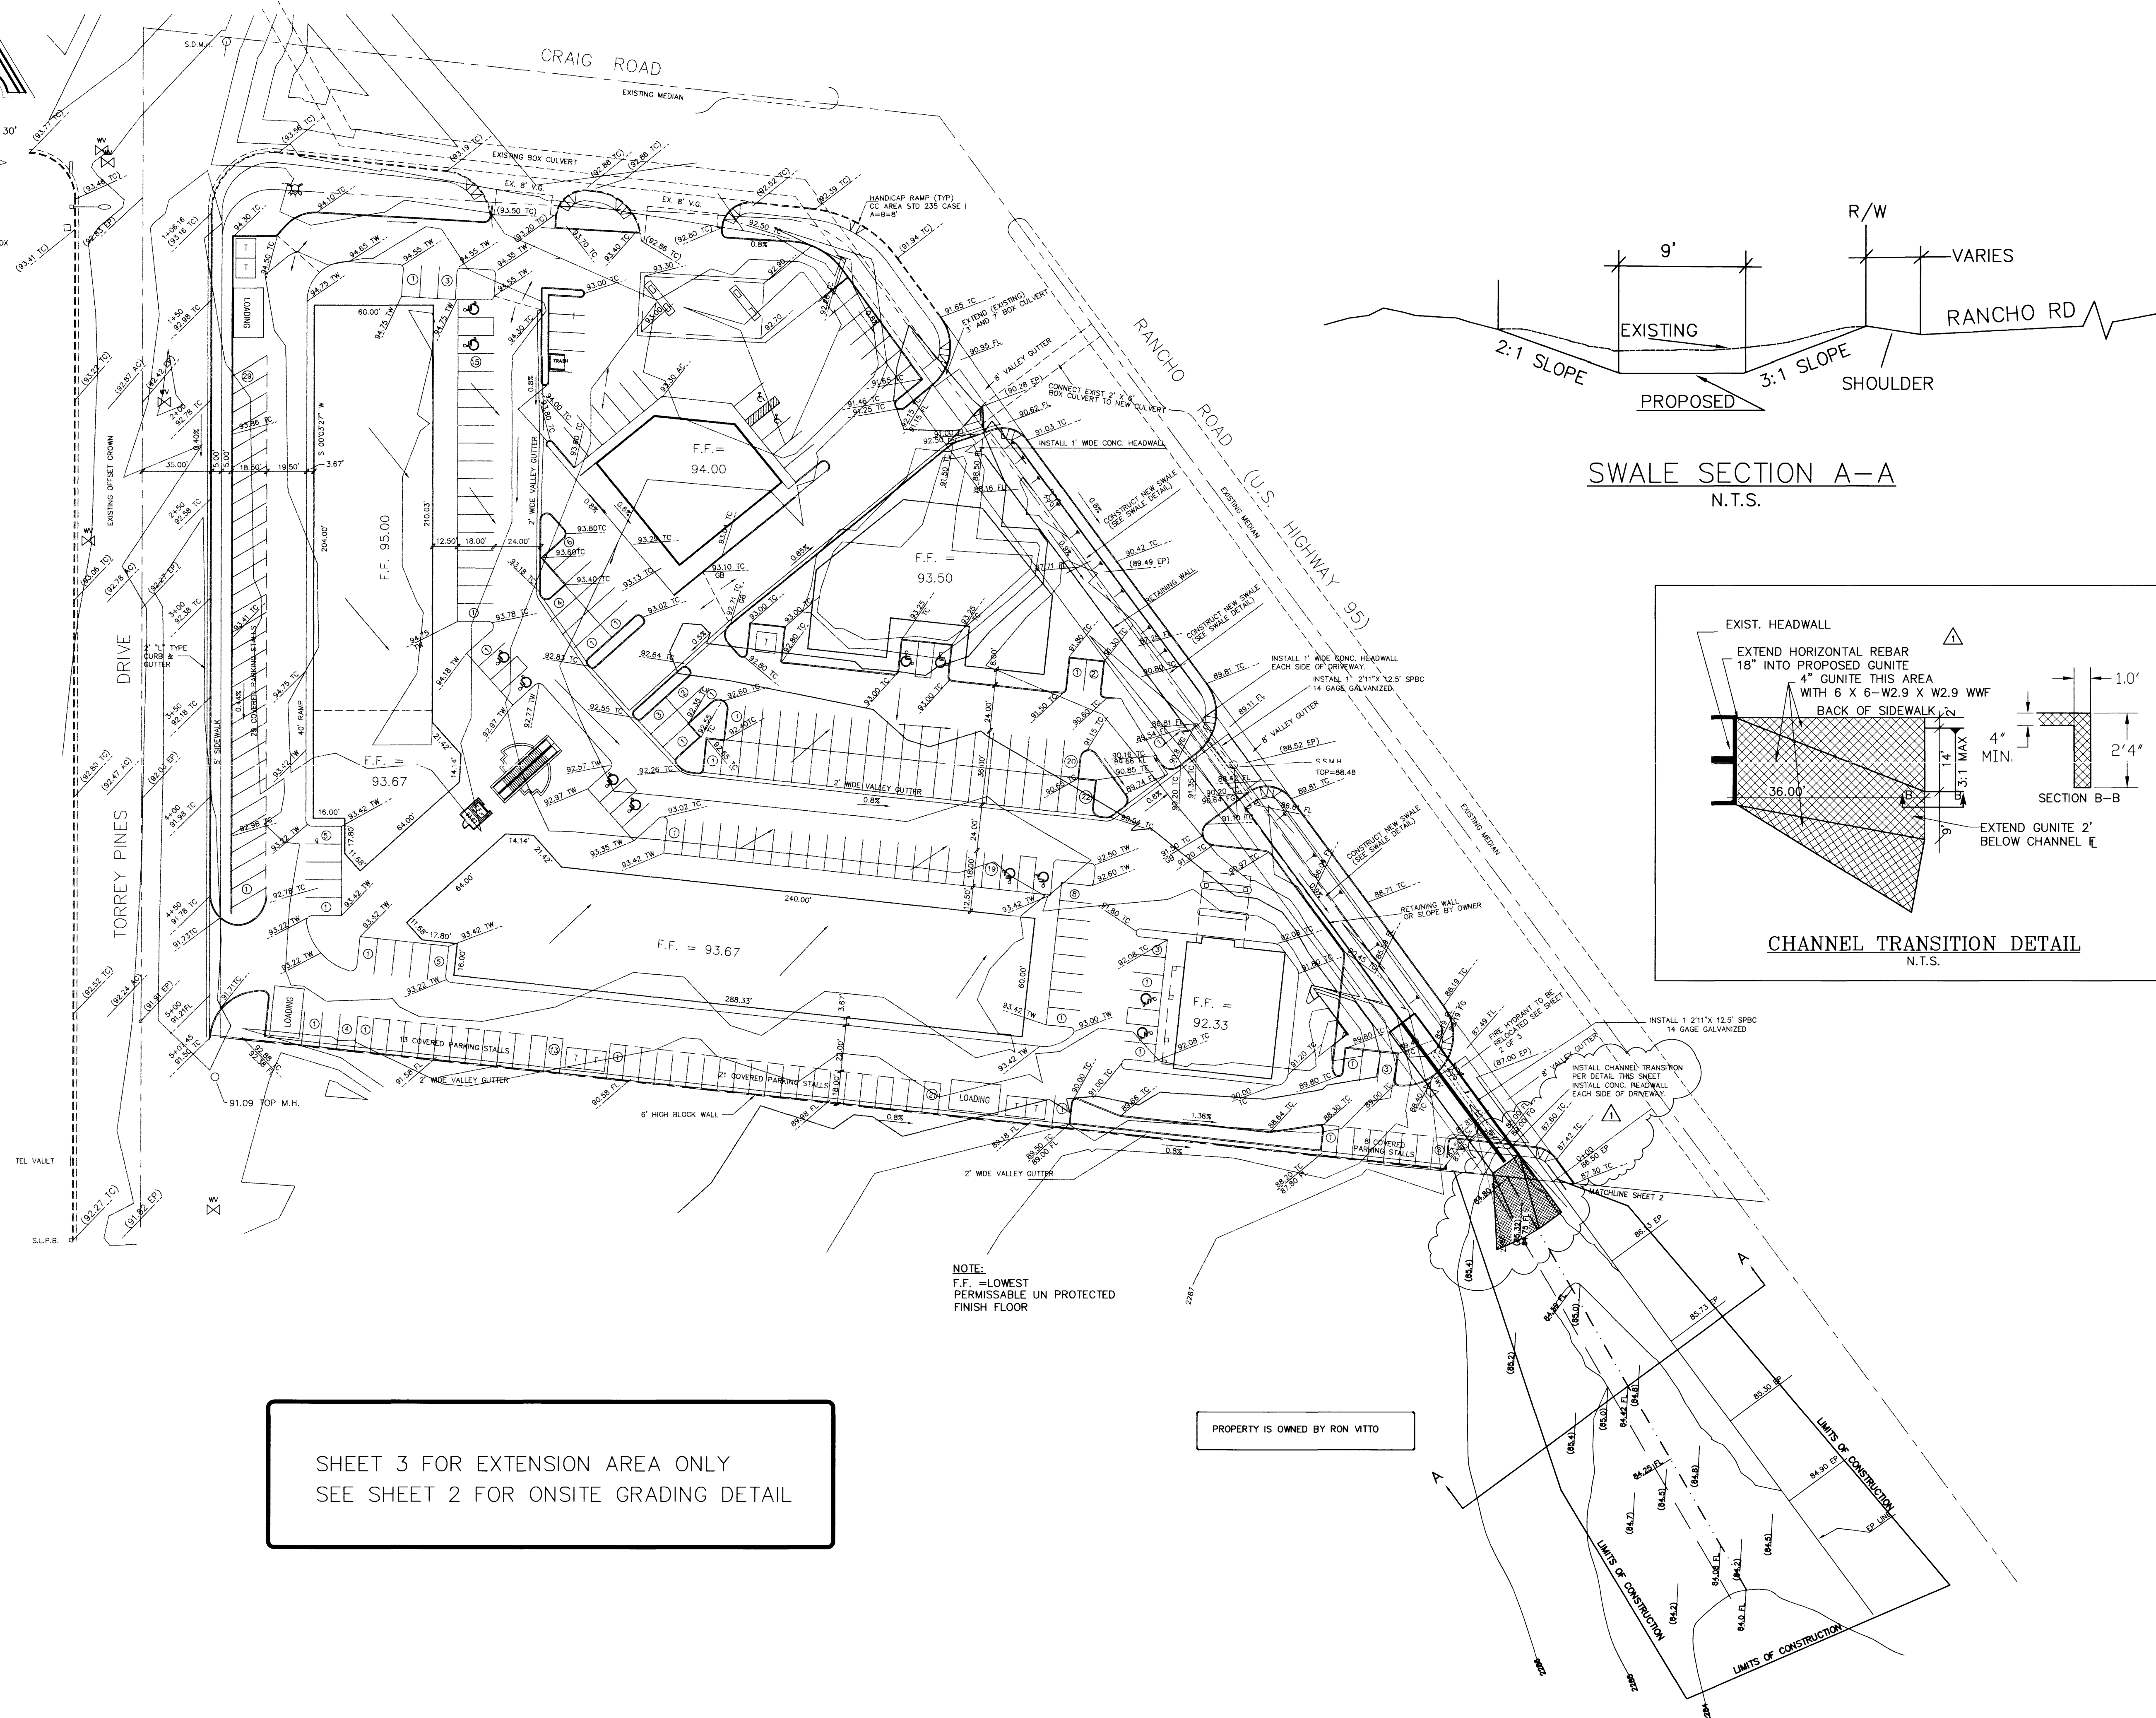


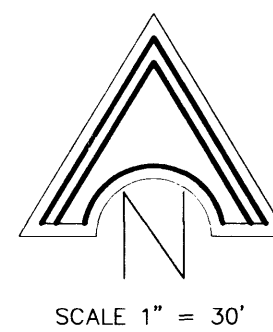

SHEET 3 FOR EXTENSION AREA ONLY  
SEE SHEET 2 FOR ONSITE GRADING DETAIL

NOTE:  
F.F. = LOWEST  
PERMISSABLE UN PROTECTED  
FINISH FLOOR

PROPERTY IS OWNED BY RON VITTO

DRAINAGE PLAN  
EXTENSION ONLY

| DATE     | 7/28/94 | REVISION                         |  |
|----------|---------|----------------------------------|--|
| JOB #    | 2503065 | Δ 8/29/97 ADD CHANNEL TRANSITION |  |
| SCALE    | 40      |                                  |  |
| DRAWN BY | B.H.    |                                  |  |

SHEET #  
DP  
3 OF 7



DESIGN ENGINEERING ASSOCIATES  
OF NEVADA, INC. 104  
2880 MEADE AVE., SUITE 104  
LAS VEGAS, NEVADA 89102  
(702) 871-9069

LIDO PLAZA  
CRAIG ROAD & RANCHO ROAD  
LAS VEGAS, NEVADA

THE CONTRACTOR SHALL CHECK AND VERIFY ALL DIMENSIONS AND REPORT ALL ERRORS TO THE ENGINEER PRIOR TO COMMENCING WORK. THESE DRAWINGS ARE NOT TO BE SCALED. ALL DIMENSIONS, SPECIFICATIONS AND NOTES ARE TO BE USED ONLY WITH RESPECT TO THIS PROJECT AND ARE NOT TO BE USED ON ANY OTHER PROJECT WITHOUT THE WRITTEN CONSENT OF THE ENGINEER. ANY USE OF THESE DRAWINGS IN WHOLE OR IN PART BY ANY MEANS WHATSOEVER, IS STRICTLY PROHIBITED EXCEPT WITH WRITTEN CONSENT OF THE ENGINEER.