
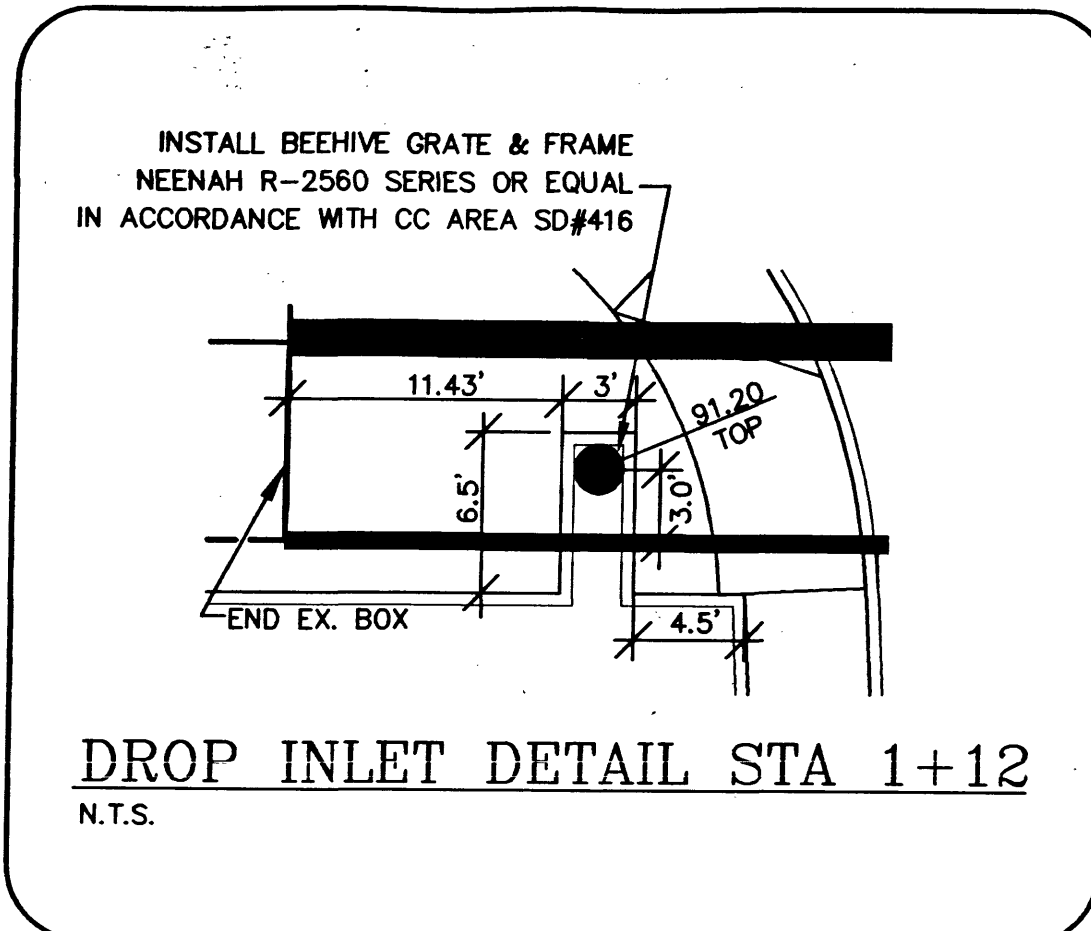
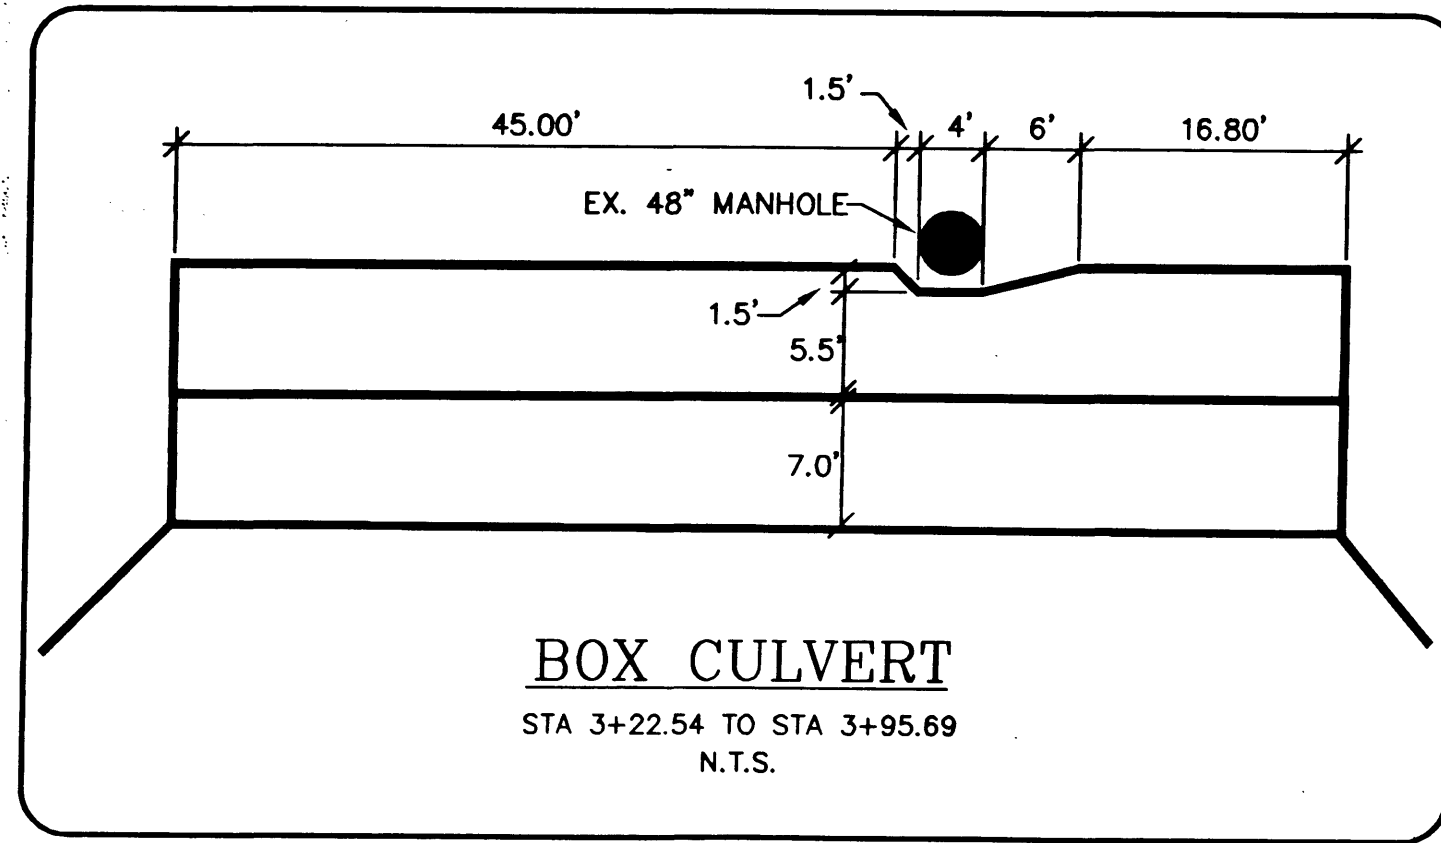


24093

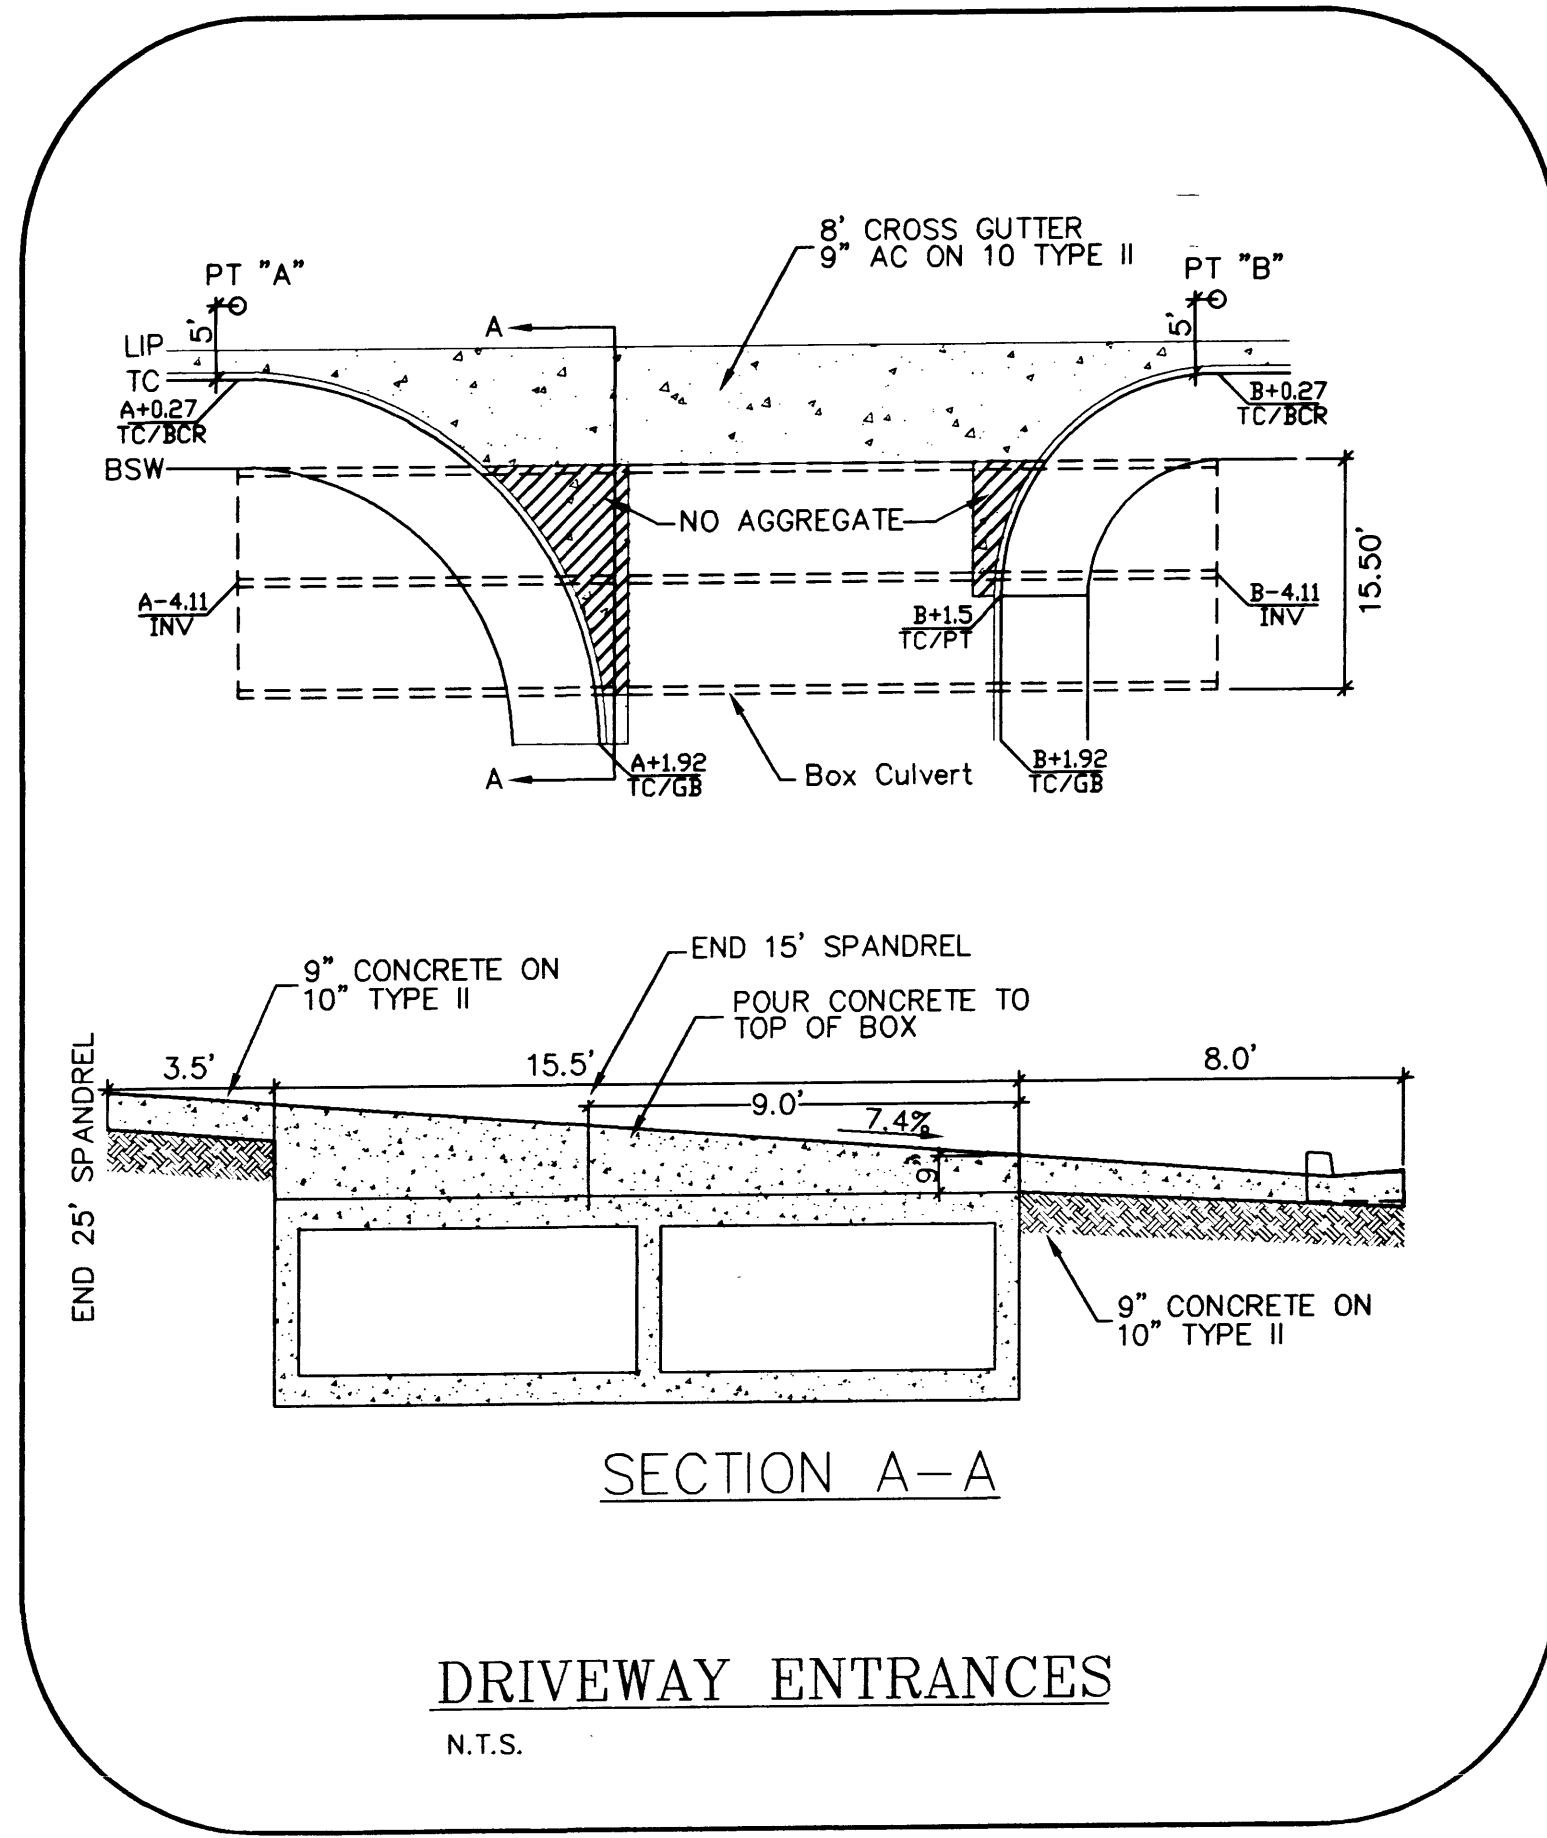

NOTE:
SHEET 5A OF 7 ADDED TO APPROVED SET OF PLANS
TO DETAIL CHANGES ON SHEET 5 OF 7






RANCHO ROAD
NDOT CULVERT DETAILS

DATE: 4/29/94
JOB #: 2593065
SCALE: 1" = 30'
DRAWN BY: B.H.

REVISION:
Added sheet 5A of 7

SHEET #
CUL
5A OF 7