
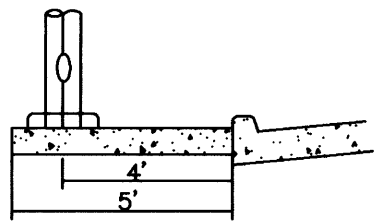
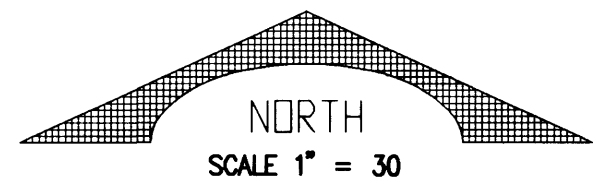


RED NOV 15 15:09:45 1994

Avoid cutting underground
utility lines. It's costly.
Call
before you
Dig.
1-800-227-2600
UNDERGROUND SERVICE (USA)

24031

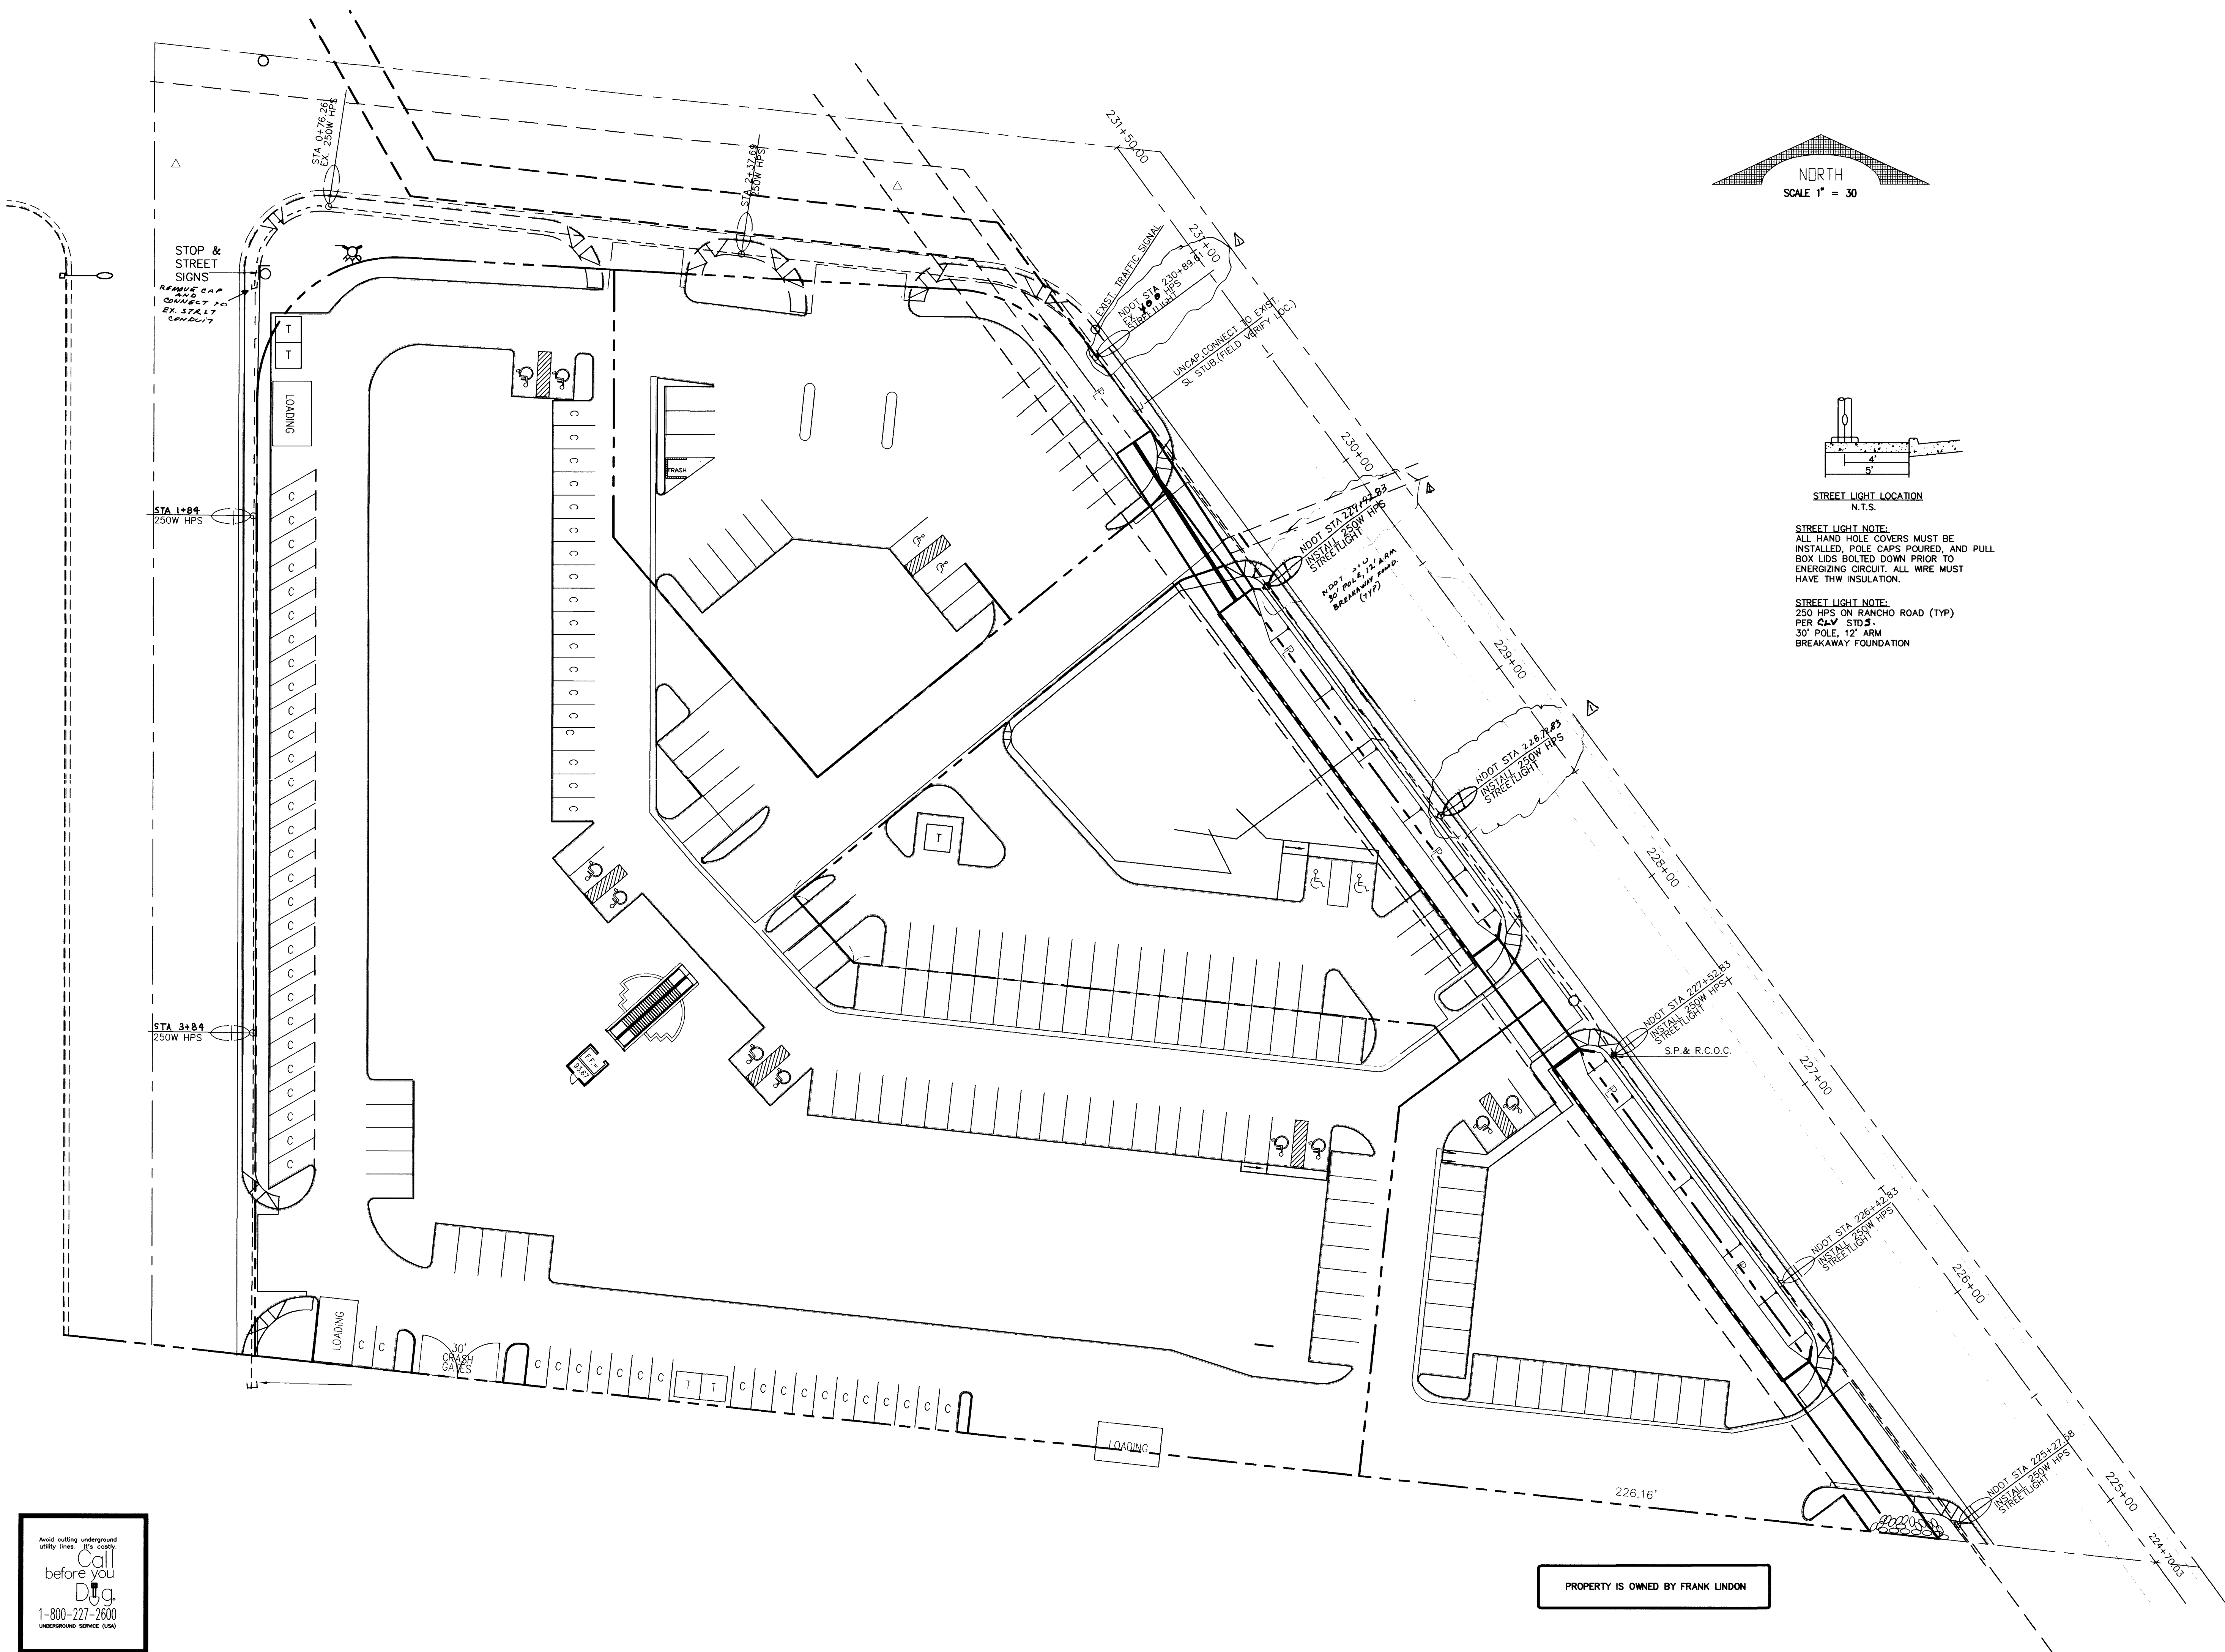

STREET LIGHT LOCATION
N.T.S.

STREET LIGHT NOTE:
ALL HAND HOLE COVERS MUST BE
INSTALLED, POLE CAPS POURED, AND PULL
BOX LIDS BOLTED DOWN PRIOR TO
ENERGIZING CIRCUIT. ALL WIRE MUST
HAVE THW INSULATION.

STREET LIGHT NOTE:
250 HPS ON RANCHO ROAD (TYP)
30' POLE, 12' ARM
BREAKAWAY FOUNDATION

PROPERTY IS OWNED BY FRANK LINDON



DEA
DESIGN ENGINEERING ASSOCIATES
OF NEVADA, INC.
2880 MEADE AVE., SUITE 104
LAS VEGAS, NEVADA 89102
(702) 871-9069

LIDO PLAZA
CRAIG ROAD & RANCHO ROAD
LAS VEGAS, NEVADA


STREET LIGHT PLAN	
DATE :	11/16/94
JOB # :	2532065
SCALE :	1" = 30'
DRAWN BY :	B.H.
REVISION :	
REV 2532065	11/16/94

SHEET #
UP1
7 OF 7
207-V2290