



APPROXIMATE QUANTITIES - THIS SHEET

ITEM	DESCRIPTION	UNIT	QUANTITY
201.1	EXCAVATION UNCLASSIFIED	C.Y.	1494
302.1	TYPE I GRAVEL BASE	C.Y.	331
302.2	" II "	C.Y.	257
334.4	2" ASPH. CONC. PAVEMENT	S.Y.	1662
340.2	CONST. 18" "L" TYPE CURB & GUTTER	L.F.	1215
340.3	" 6' SIDEWALK	S.F.	3806
340.5	" VALLEY GUTTER & APRONS	S.F.	484
333.1	BITUMINOUS FOG SEAL COAT	S.Y.	1662

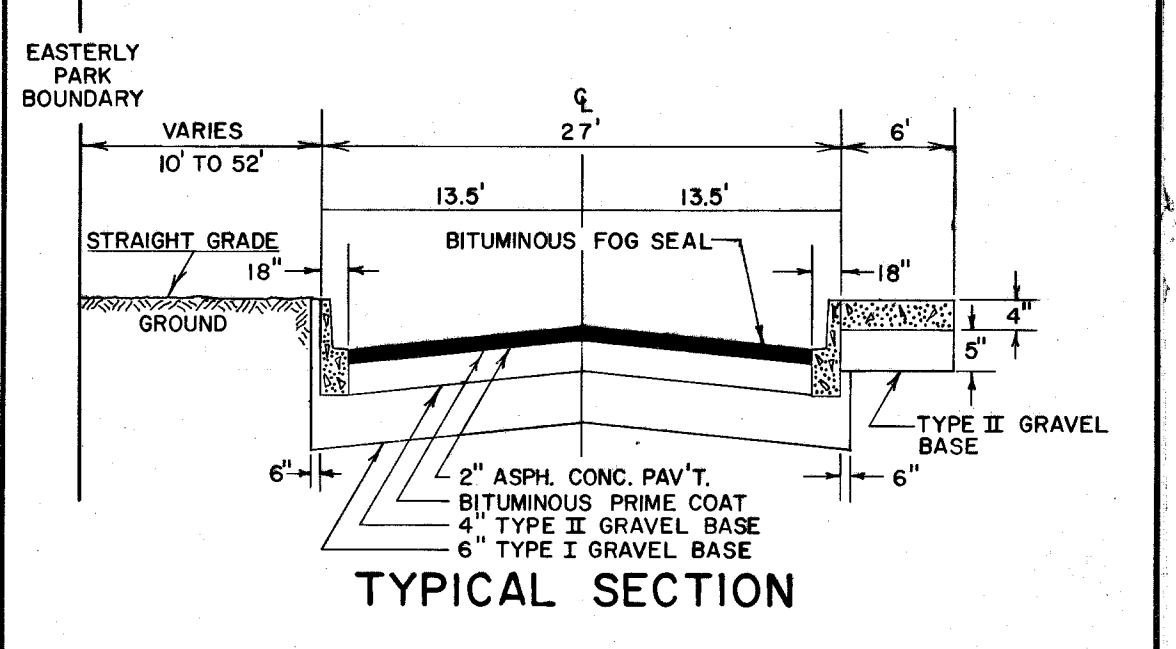

CLV Bench Mark No. 06129B20  
Northwesterly Corner Washington Ave.  
And Magnolia Ave. Elev. 2102.49

*VOID*  
*3/30/74*  
*JRS*  
*See 650-19-25*

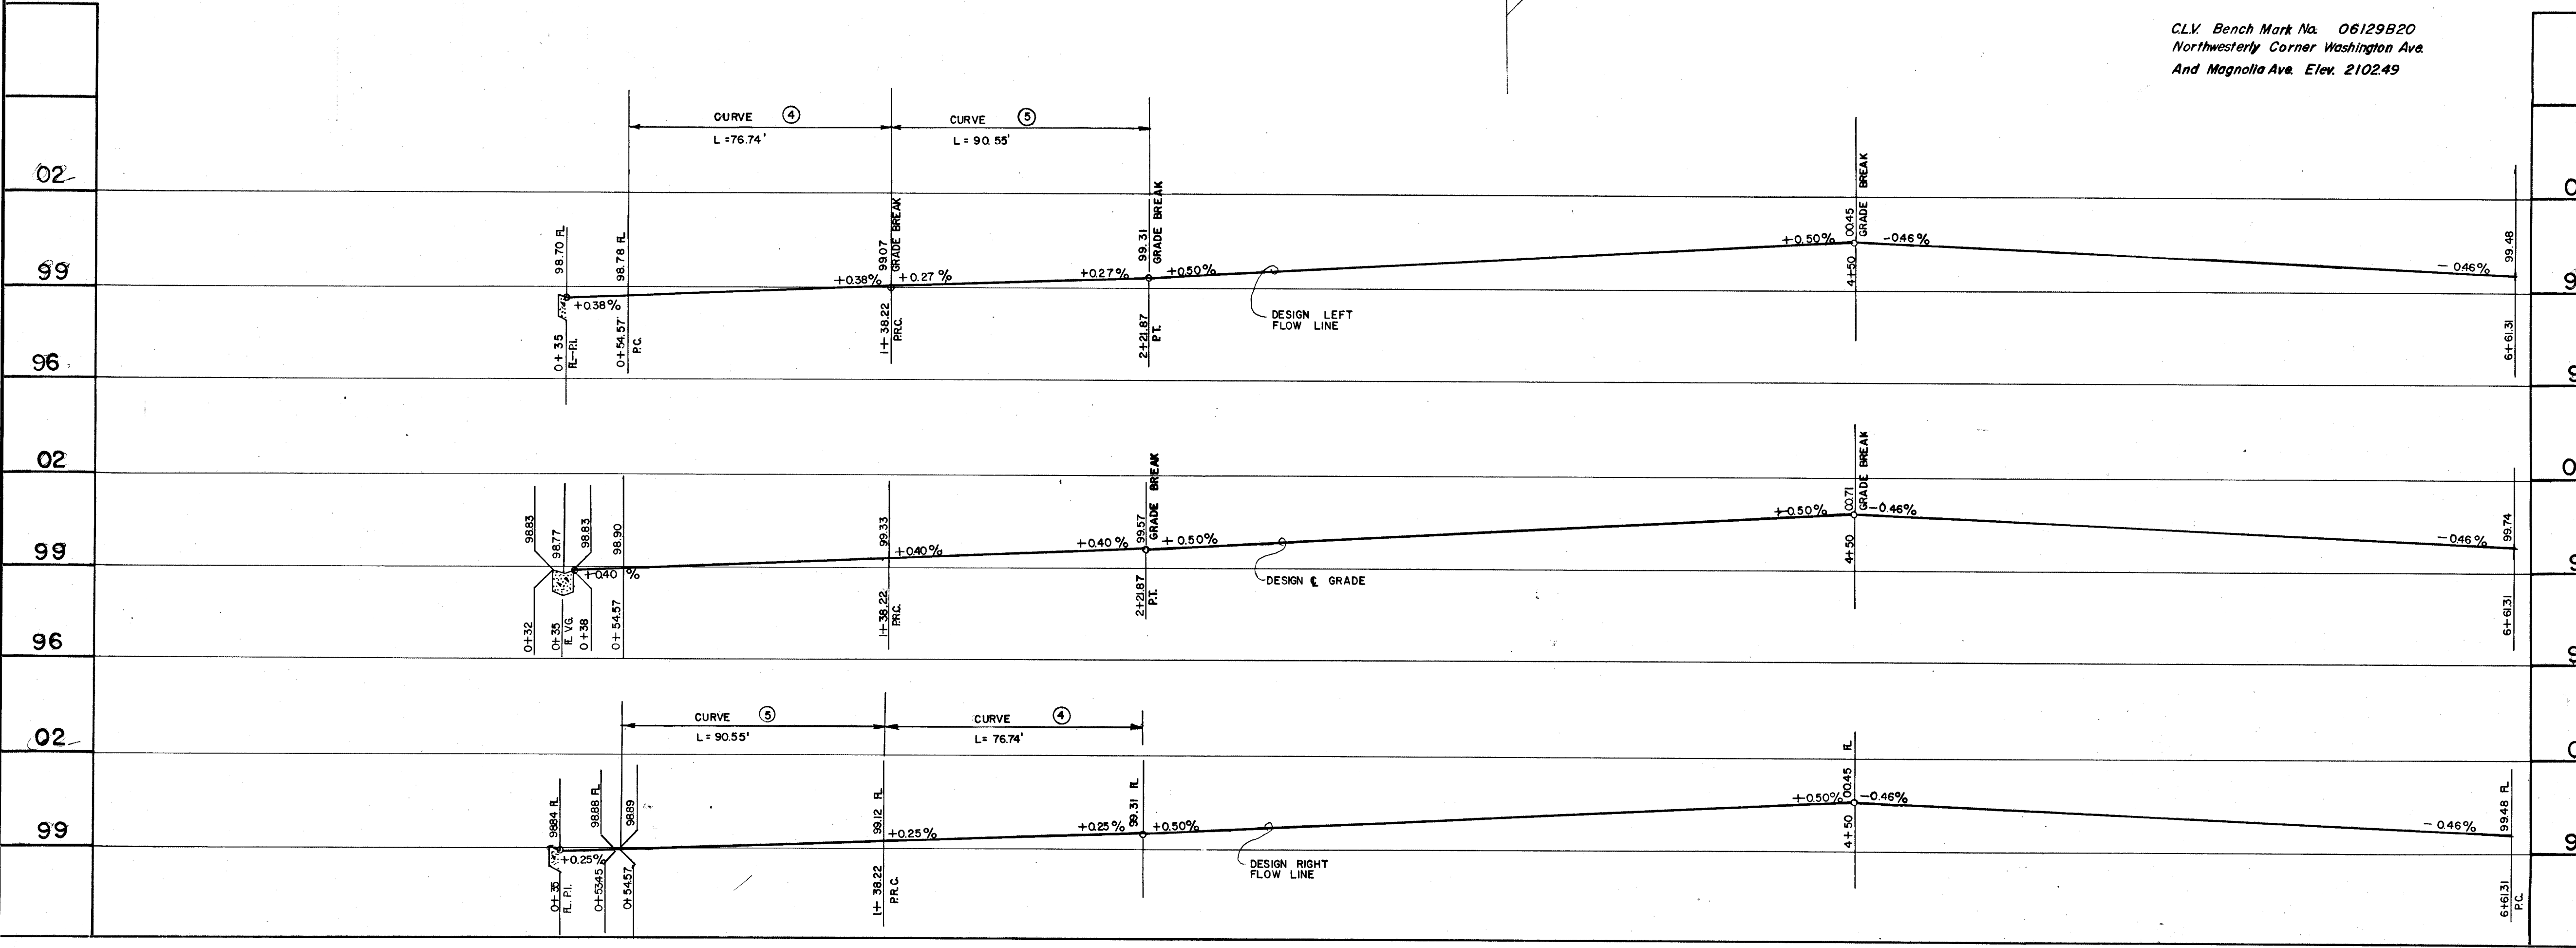

CURVE DATA

NO.	DELTA	RADIUS	TANGENT	LENGTH	LOCATION
1	90°57'16"	20.00'	20.34'	31.75'	B.C.
2	89°02'44"	20.00'	19.67'	31.08'	B.C.
3	29°18'47"	16.350'	42.76'	83.65'	B.C.
4	29°18'47"	15.000'	39.23'	76.74'	B.C.
5	29°18'47"	17.000'	46.29'	90.55'	B.C.

REVISION NO.	DESCRIPTION	BY	DATE	APPROVAL

**CITY OF LAS VEGAS NEVADA**  
DEPARTMENT OF PUBLIC WORKS  
SERVICES DIVISION

**LORENZO PARK  
PARKING LOT NO. 1 ACCESS ROAD**

W.O. NO.	F.BK. NO.	DATE	DRAWING NO.
SC. (H) 1"=30'	SC. (V) 1"=30'	10-2-69	650-19-10C
DES. LOUVIERE			FILE NO.
DR. R. GLOUNER			
APPROVED BY DIRECTOR OF PUBLIC WORKS			

SHEET 1 OF 3