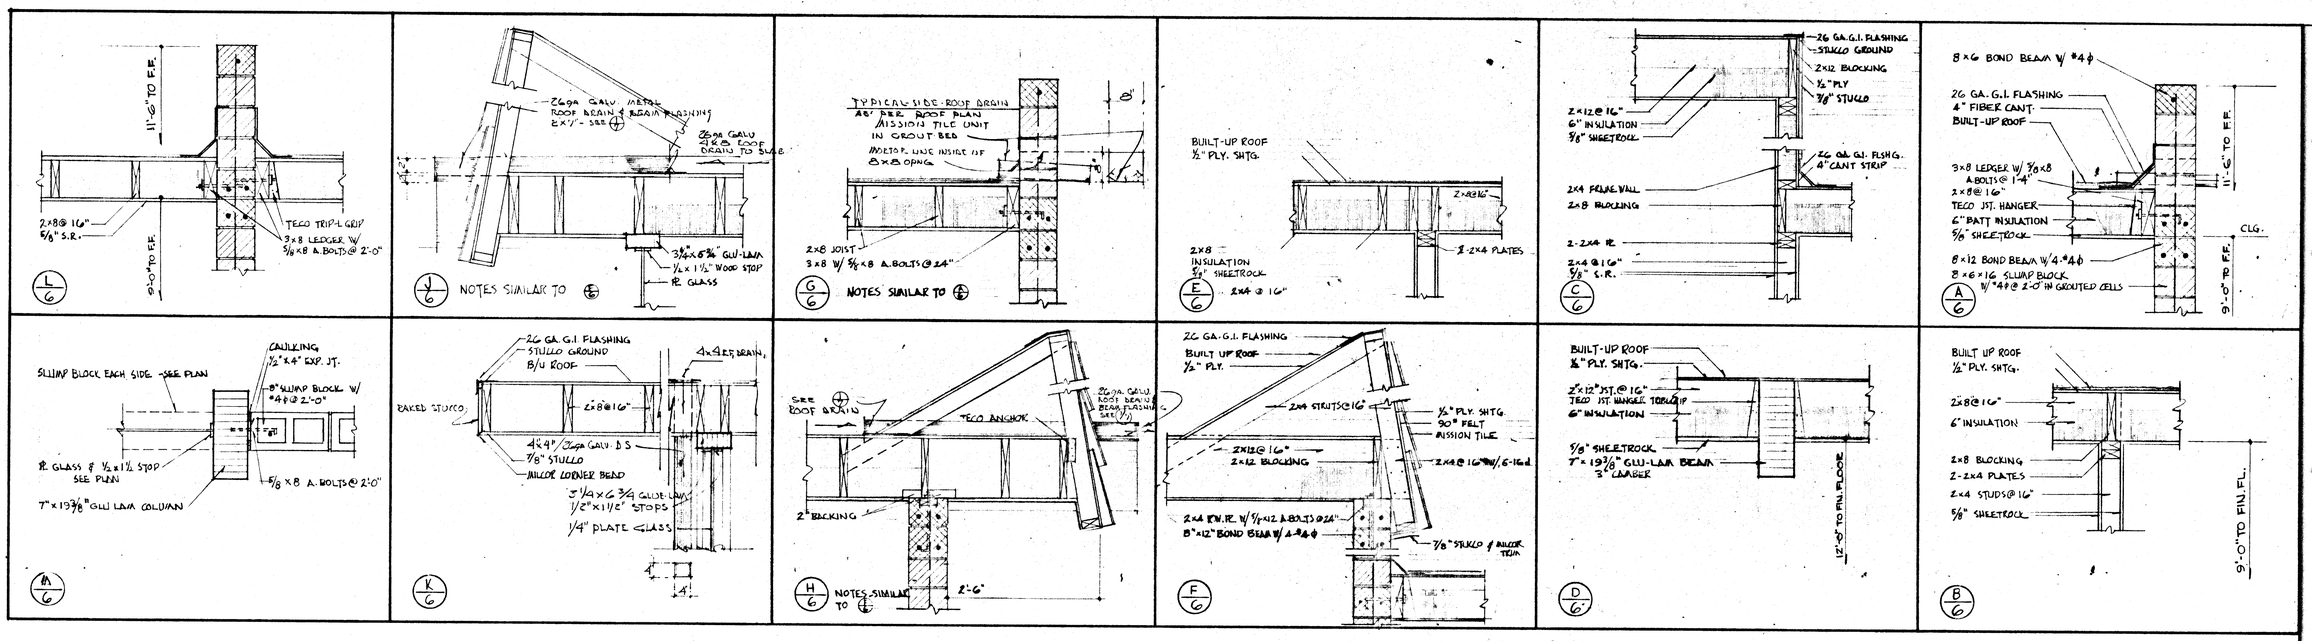

ROOF FRAMING PLAN
SECTIONS
DETAILS

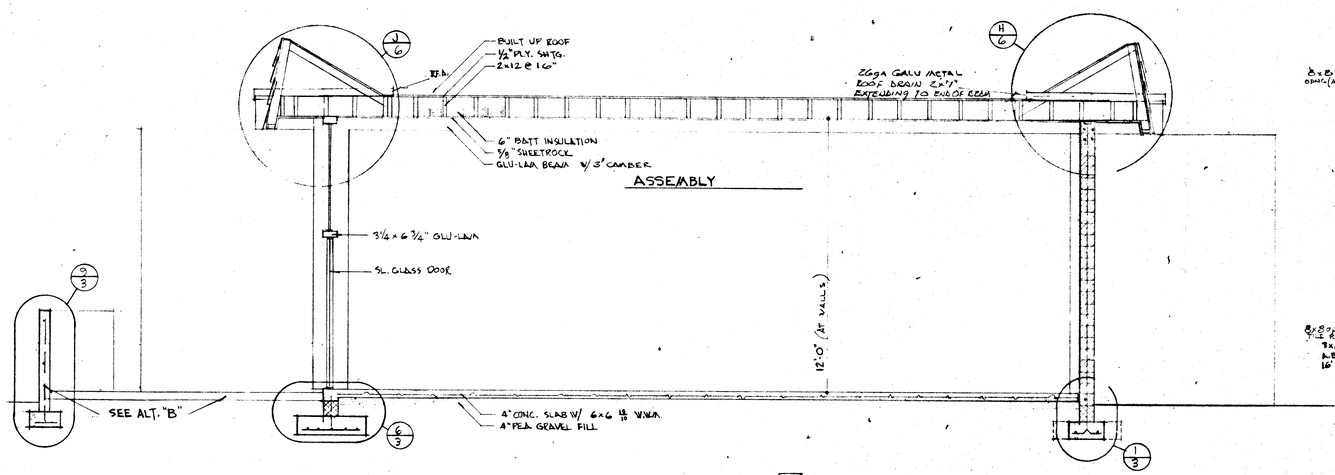

SECTION B/6
3/8" = 1'-0"

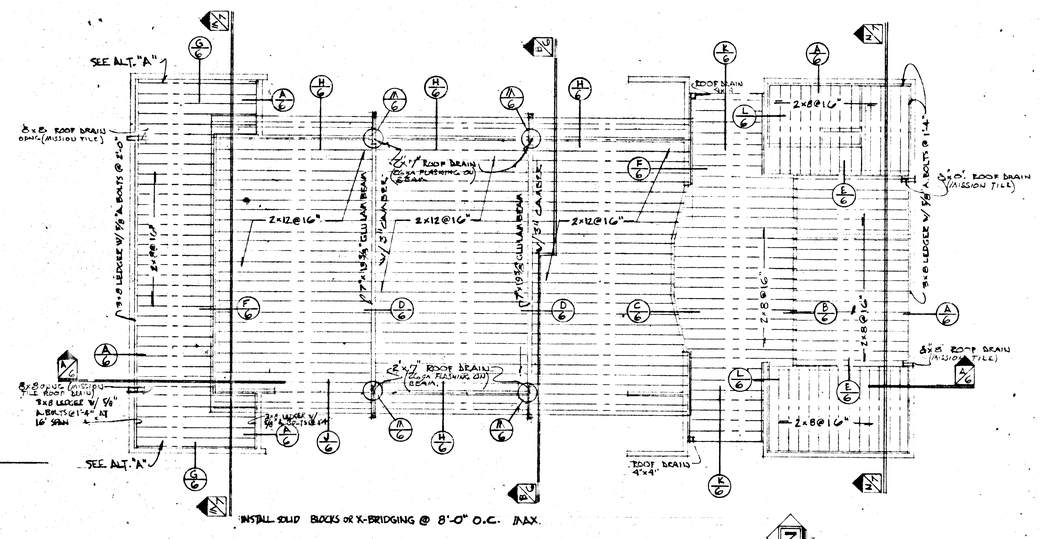

ROOF FRAMING PLAN
1/8" = 1'-0"

INTERIOR LINTEL SCHEDULE	
SPAN (MAXIMUM)	LINTEL SIZE
2'-6"	2—2×4
4'-0"	2—2×6
6'-0"	2—2×8
8'-0"	2—2×10

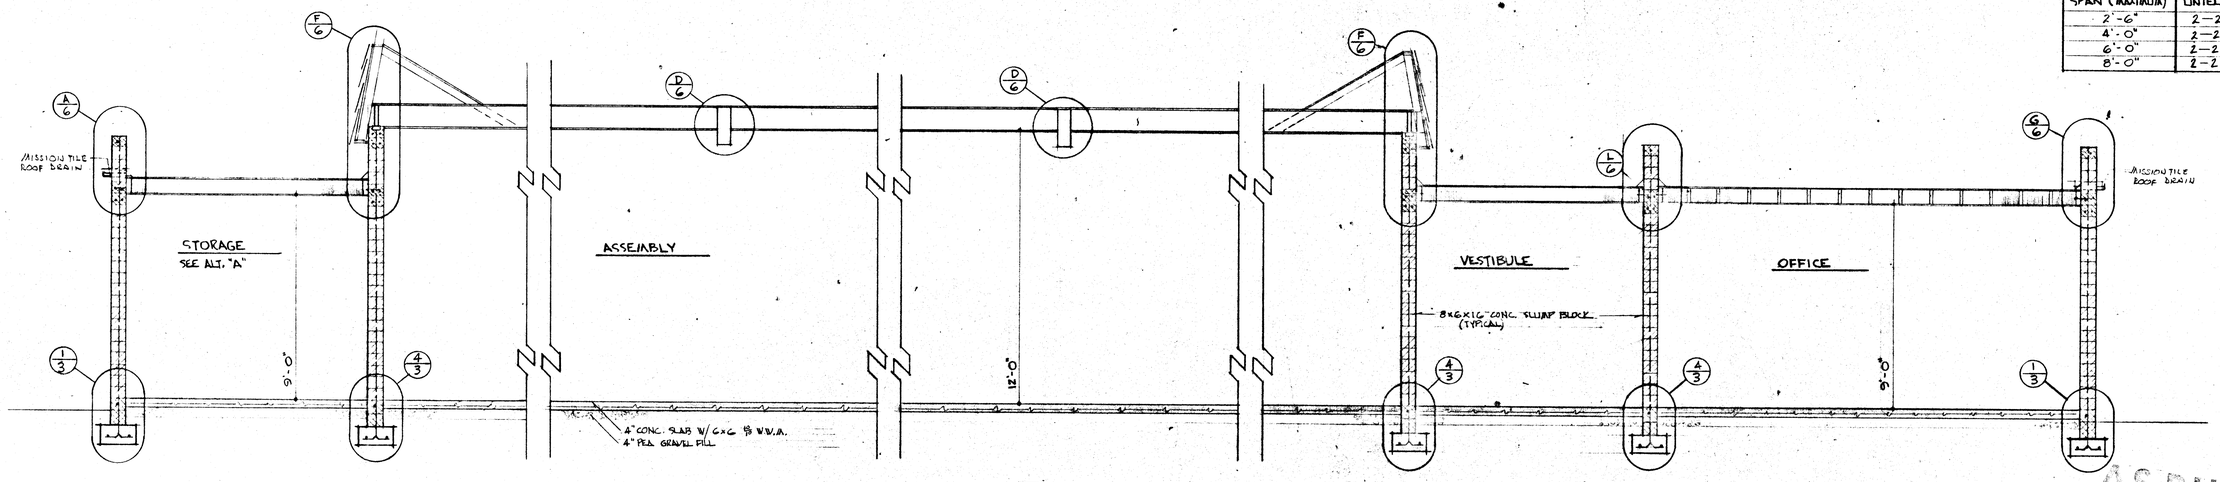

SECTION B/6
3/8" = 1'-0"

AS BUILT

3842

65c.19-12 (Rev 7-11, #3-2c)

J. WILLIAM SIMPSON ARCHITECT 217 GARCER LAS VEGAS

GARDEN CLUB BUILDING LOPENZI PARK

DATE: 11-11-68

6820

SHEET 6 OF 10