




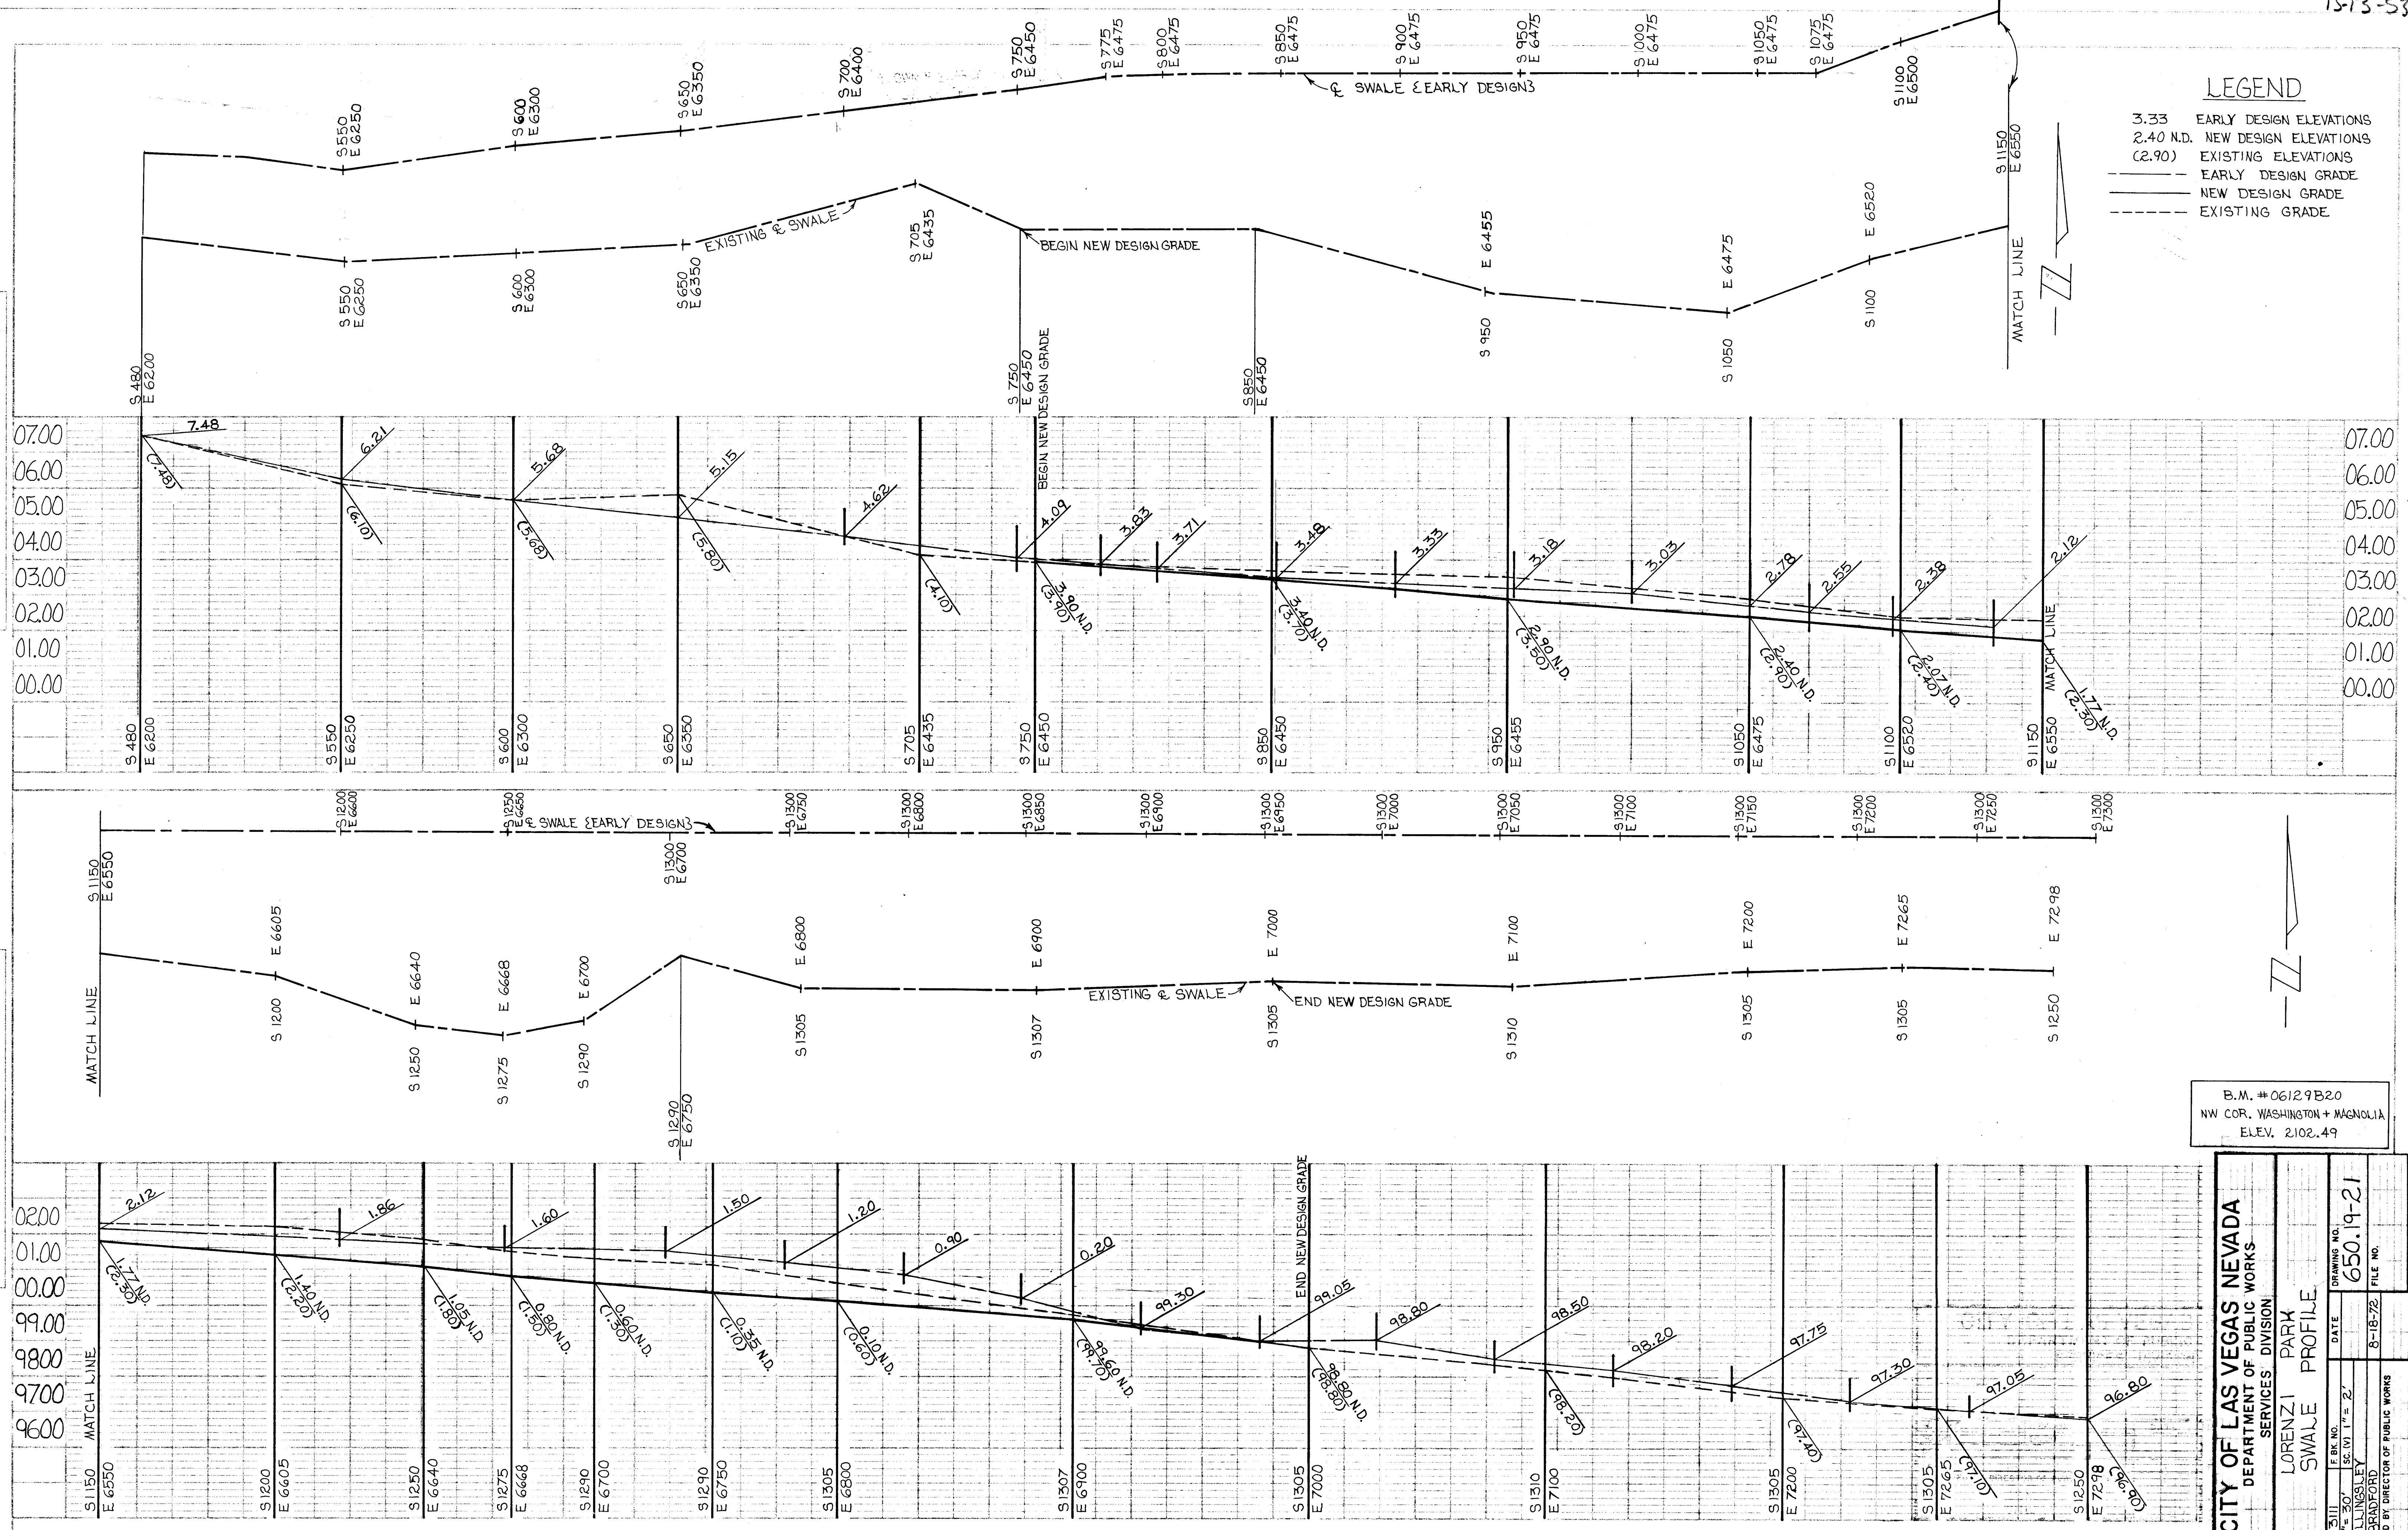

B.M. #06129B20
 NW COR. WASHINGTON + MAGNOLIA
 ELEV. 2102.49

CITY OF LAS VEGAS NEVADA		DEPARTMENT OF PUBLIC WORKS	
SERVICES DIVISION		LORENZI PARK SWALE PROFILE	
W.O. NO. 3111	E.B.K. NO.	DATE	DRAWING NO.
SC (H) 1" = 30'	SC (V) 1" = 2'		650-19-21
DES. BILLINGSLEY		FILE NO.	
DR. L. BRADFORD		8-18-72	
APPROVED BY DIRECTOR OF PUBLIC WORKS			