




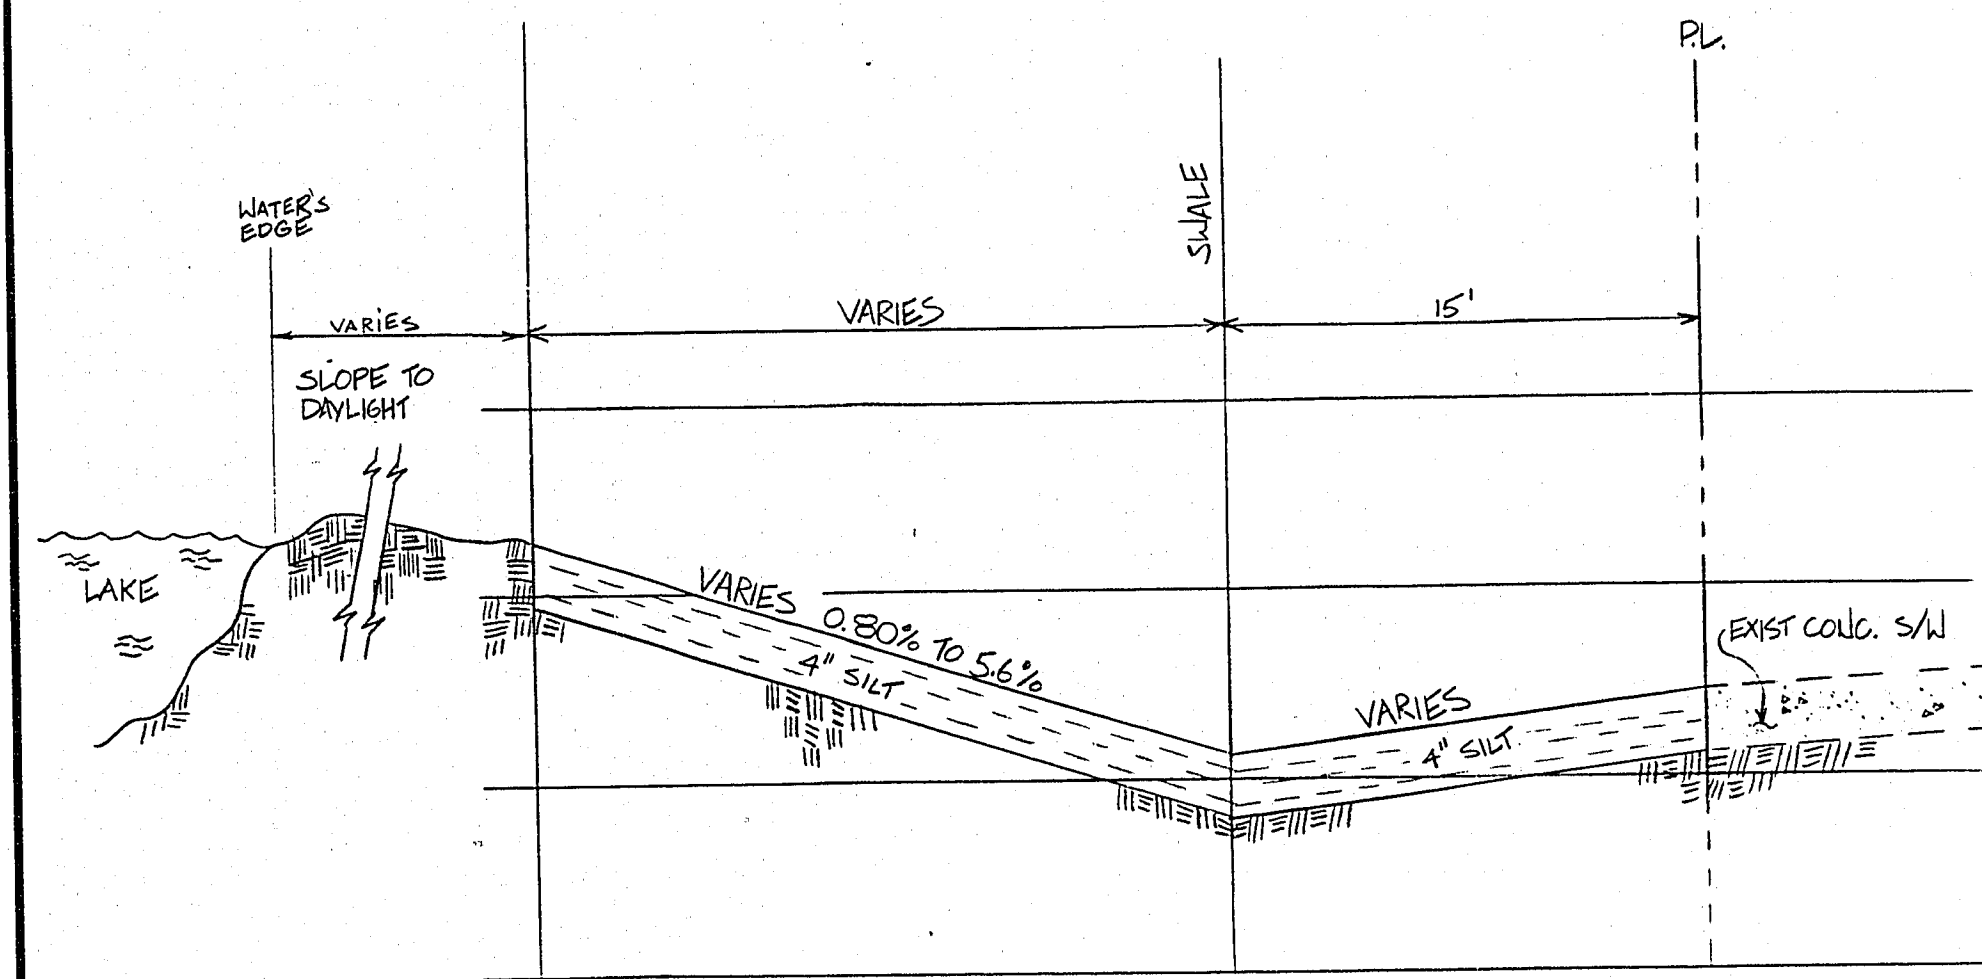


TYPICAL SWALE DETAIL
STA. 2+75 TO 4+00
1/2" SCALE

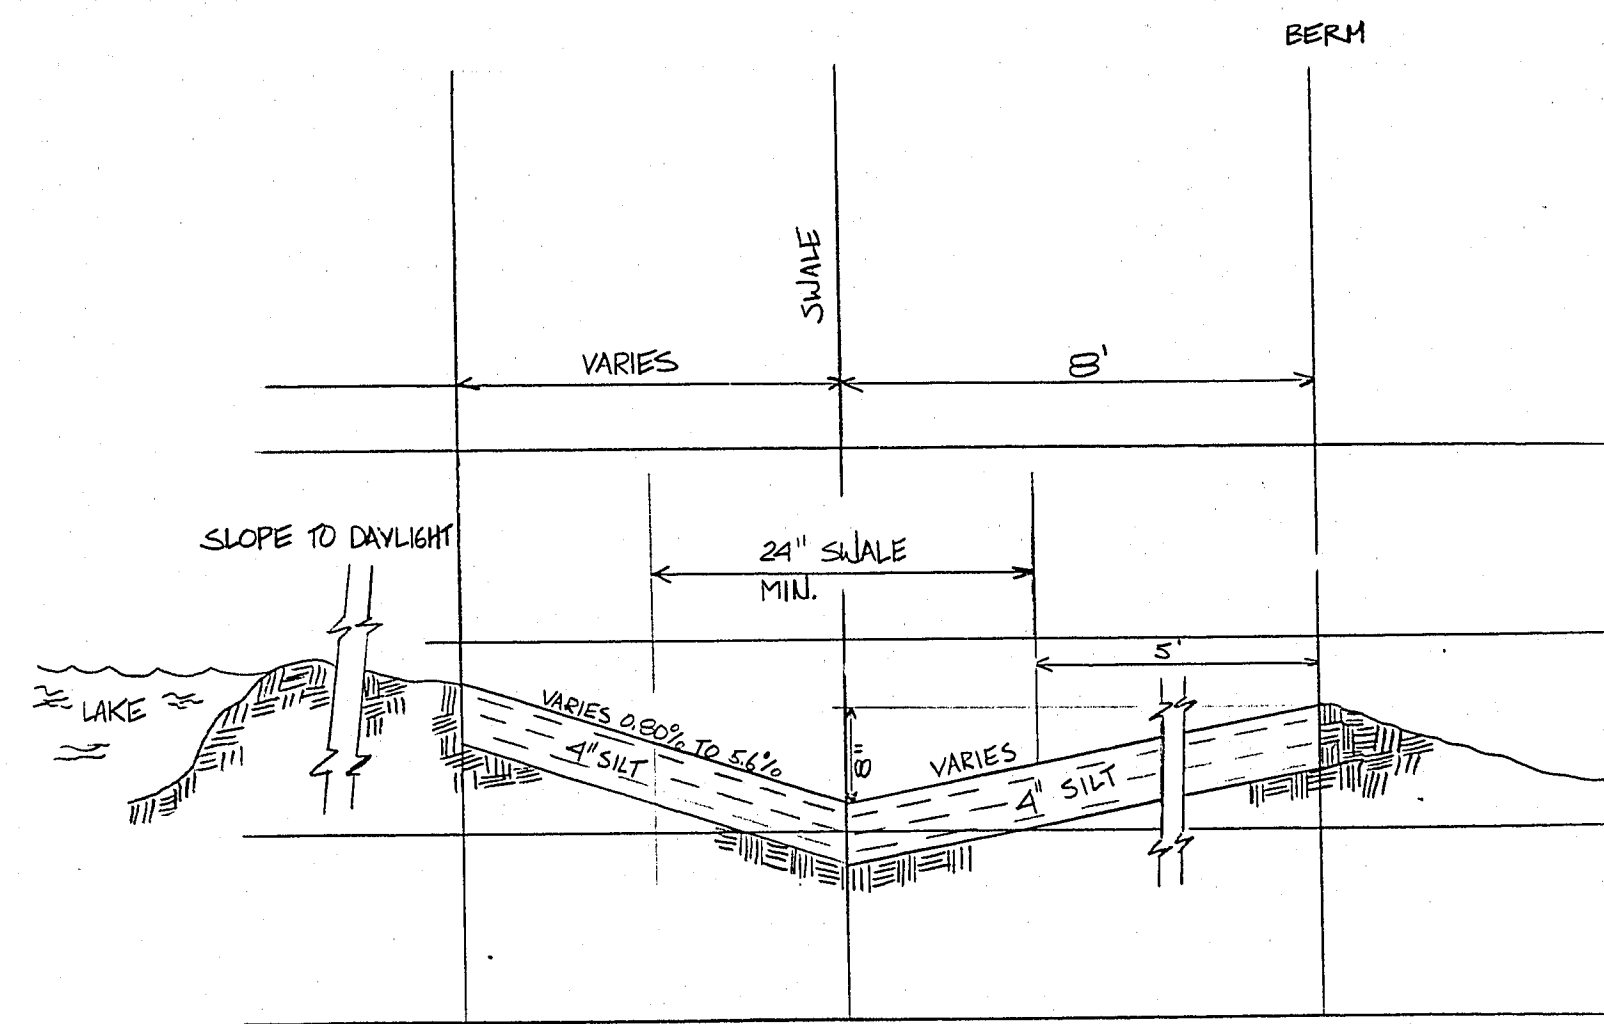

TYPICAL SWALE DETAIL
STA. 4+00 TO 5+00
NO SCALE

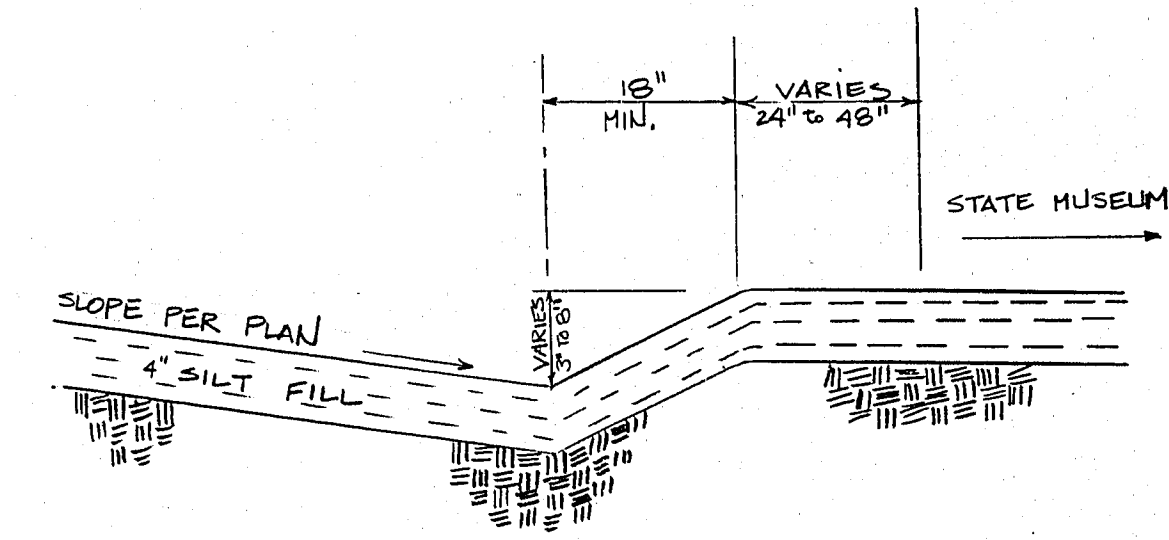

SWALE DETAIL
STA. 5+00 TO 5+75
NO SCALE

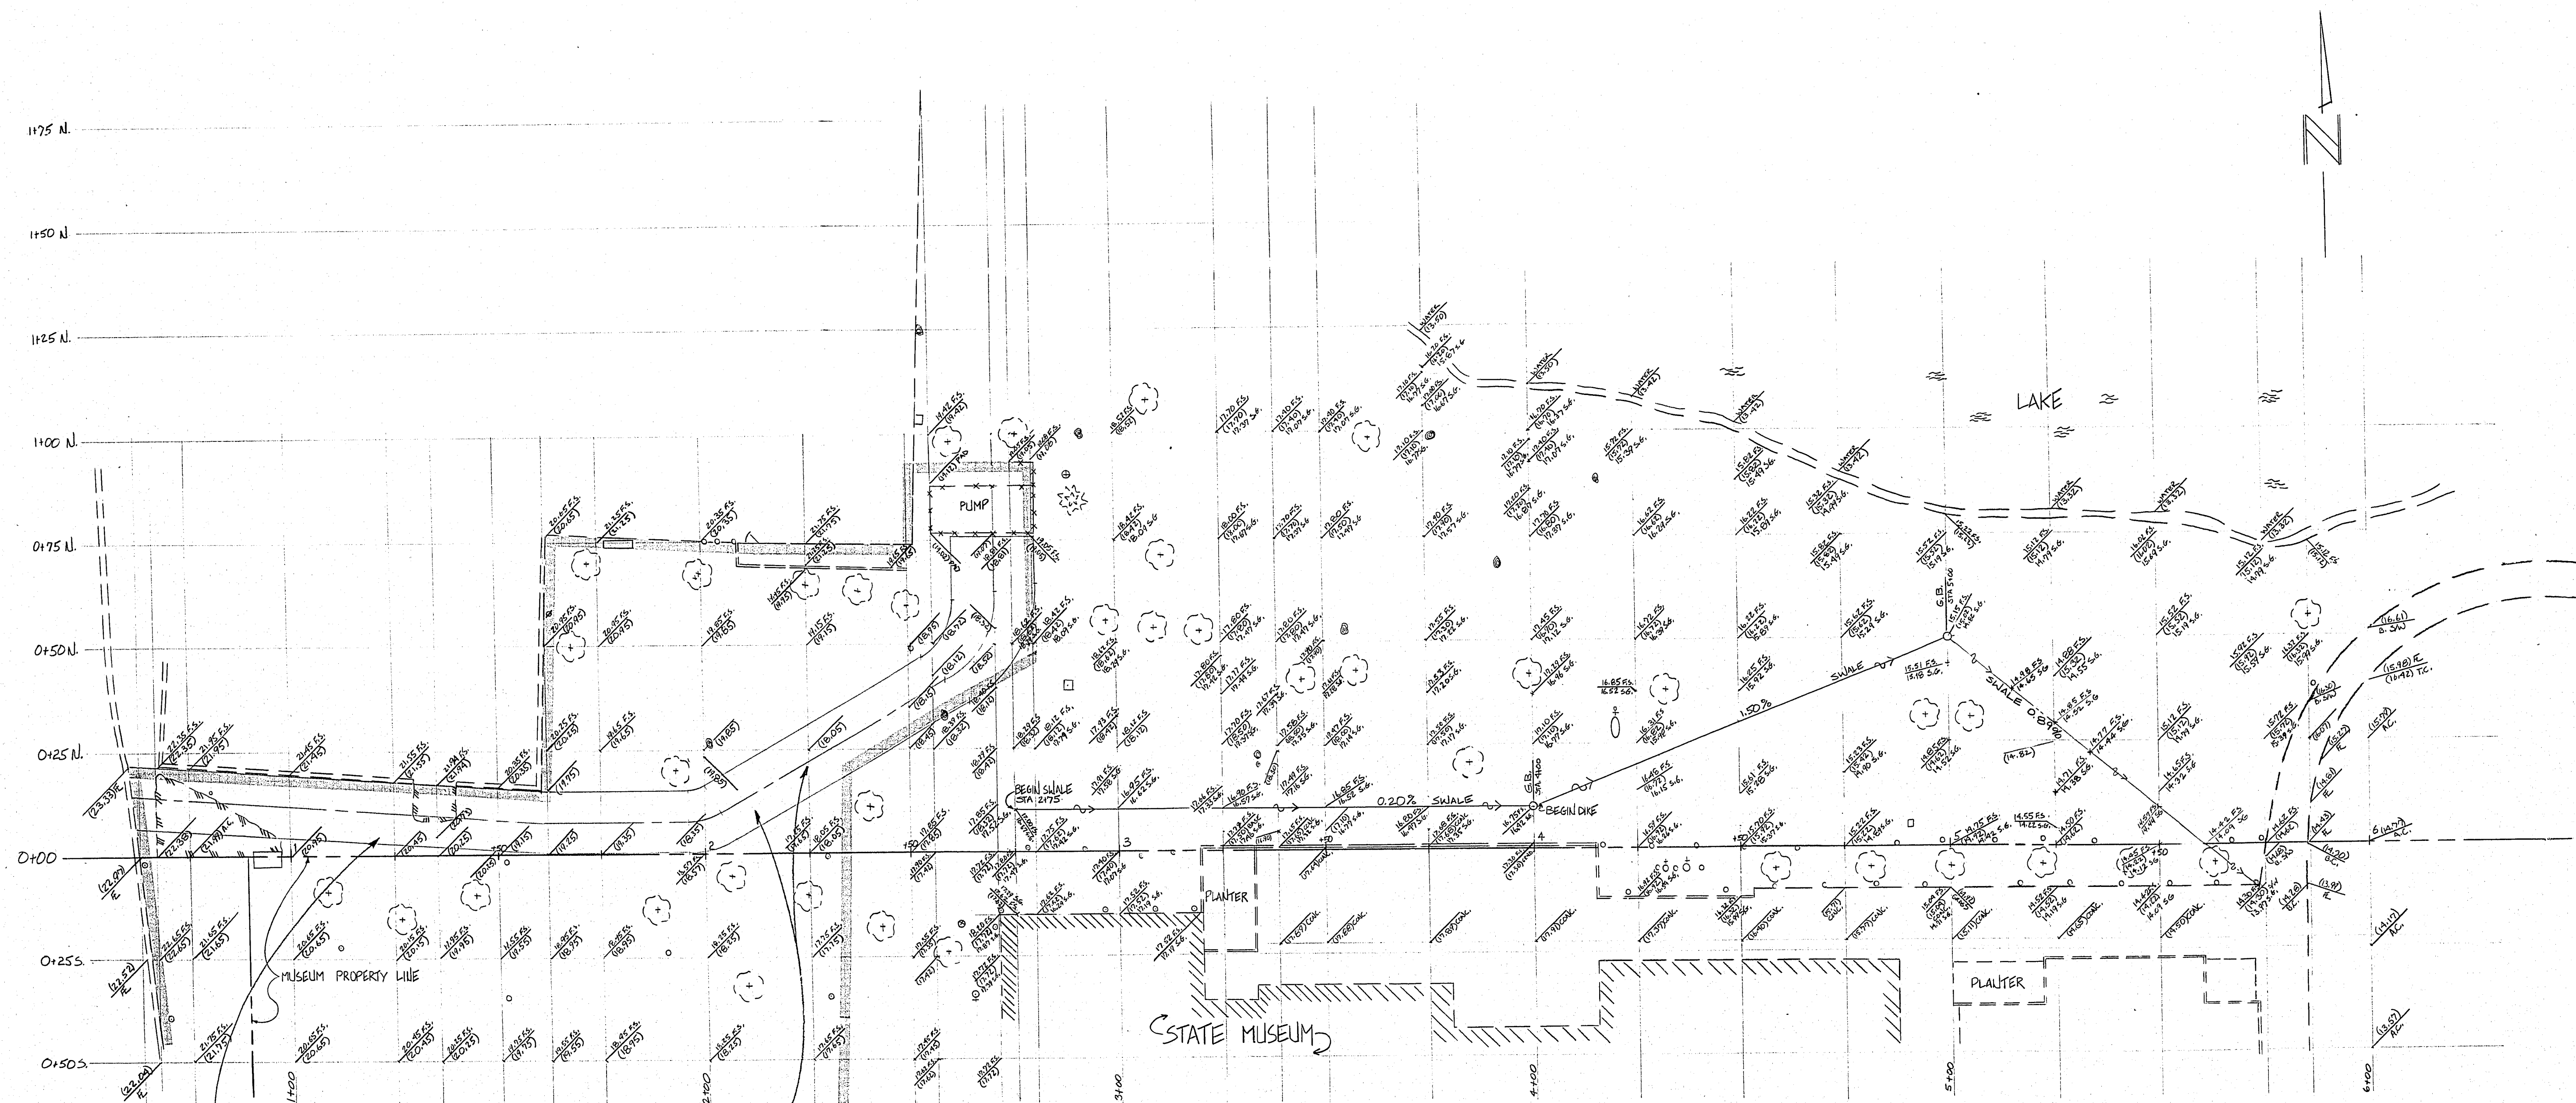

WORK IN THIS AREA SHALL BE REVIEWED
AT A LATER DATE.
NOT APPROVED AT THIS TIME.

GRADING PLAN
SCALE 1"=20'


Department of Public Services Engineering Design Division

LORENZI STATE MUSEUM
PARKING LOT & ROAD

GRADING PLAN



Drawing no. 650.19-324 5/5

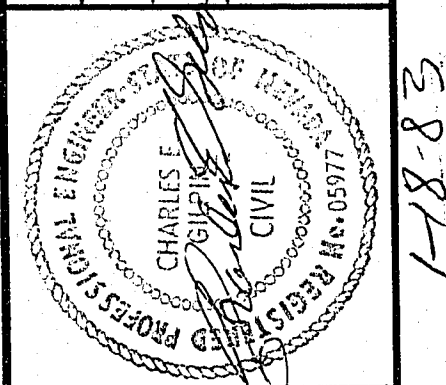

Scale (h) 1"=20'
Fid. bk. no.
Design by MORSE ARCHERY

Scale (v)
Date JANUARY '83
CHKD BY E. J. SAN

W.O. no.
Drawn by L. WOFFER

Approved by the CITY ENGINEER
Date

Revisions

Date

14-13-119

1-18-83