

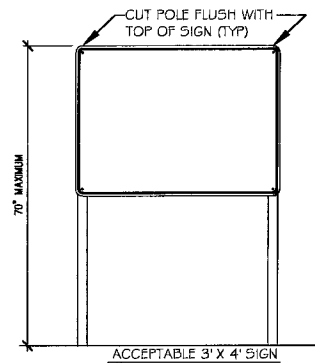


NOT TO SCALE

 

NOT TO SCALE

- NOTES:
- 1) SIGNS ATTACHED TO FENCE SHALL BE LEFT SIDE JUSTIFIED WITH EACH OTHER.
  - 2) SIGNS MOUNTED ON GATES SHALL BE CENTERED ON WIDTH OF GATE.
  - 3) NO POST MOUNTED SIGNS SHALL BE INSTALLED PERPENDICULAR TO EACH OTHER.
  - 4) SIGNS MOUNTED BACK TO BACK MUST BE THE SAME SIZE AND ORIENTATION.
  - 5) FENCE MOUNTED SIGNS SHOULD NOT HAVE ANY BOLTS, FASTENERS, OR OTHER SHARP EDGES ON THE FIELD SIDE OF ANY FENCE.

 

1. TO ALTER THESE DOCUMENTS FOR ANOTHER PROJECT BY ANYONE OTHER THAN THE ORIGINAL ARCHITECT IS A VIOLATION OF NRS 523.

1. TO ALTER THESE DOCUMENTS FOR ANOTHER PROJECT BY ANYONE OTHER THAN THE ORIGINAL ARCHITECT IS A VIOLATION OF NRS 523.
2. THIS RECORD DRAWING HAS BEEN PREPARED IN PART, BASED UPON INFORMATION FURNISHED BY THE GENERAL CONTRACTOR. WHILE THIS INFORMATION IS BELIEVED TO BE RELIABLE, THE DESIGN PROFESSIONAL CANNOT ASSURE ITS ACCURACY, AND THUS IS NOT RESPONSIBLE FOR ANY ERRORS OR OMISSIONS WHICH MAY HAVE BEEN INCORPORATED INTO IT AS A RESULT. THE DESIGN PROFESSIONAL CANNOT AND DOES NOT WARRANT THEIR ACCURACY.
3. INFORMATION THAT MAY BE INCLUDED WOULD BE SIGNIFICANT CHANGES TO PLANTING OR IRRIGATION LAYOUT PLANS AND ASSOCIATED DRAWINGS, MINOR CHANGES TO CONSTRUCTION DETAIL CHANGES MAY NOT BE INCLUDED.

