
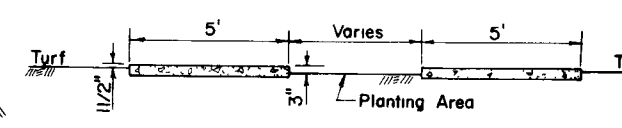
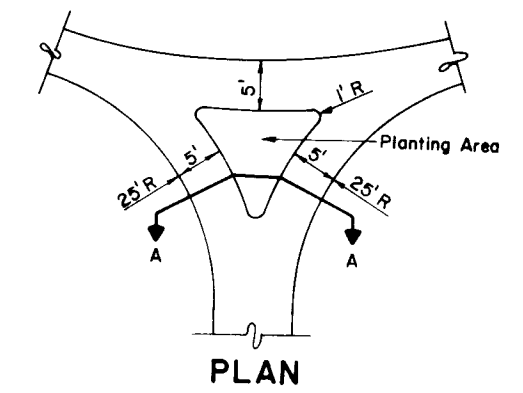
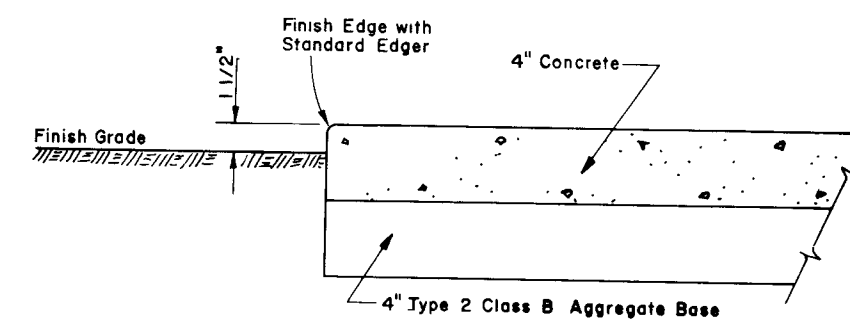


FED. RD REG NO	STATE	PROJECT NO	COUNTY
9	NEVADA	I-015-1(48)43	CLARK

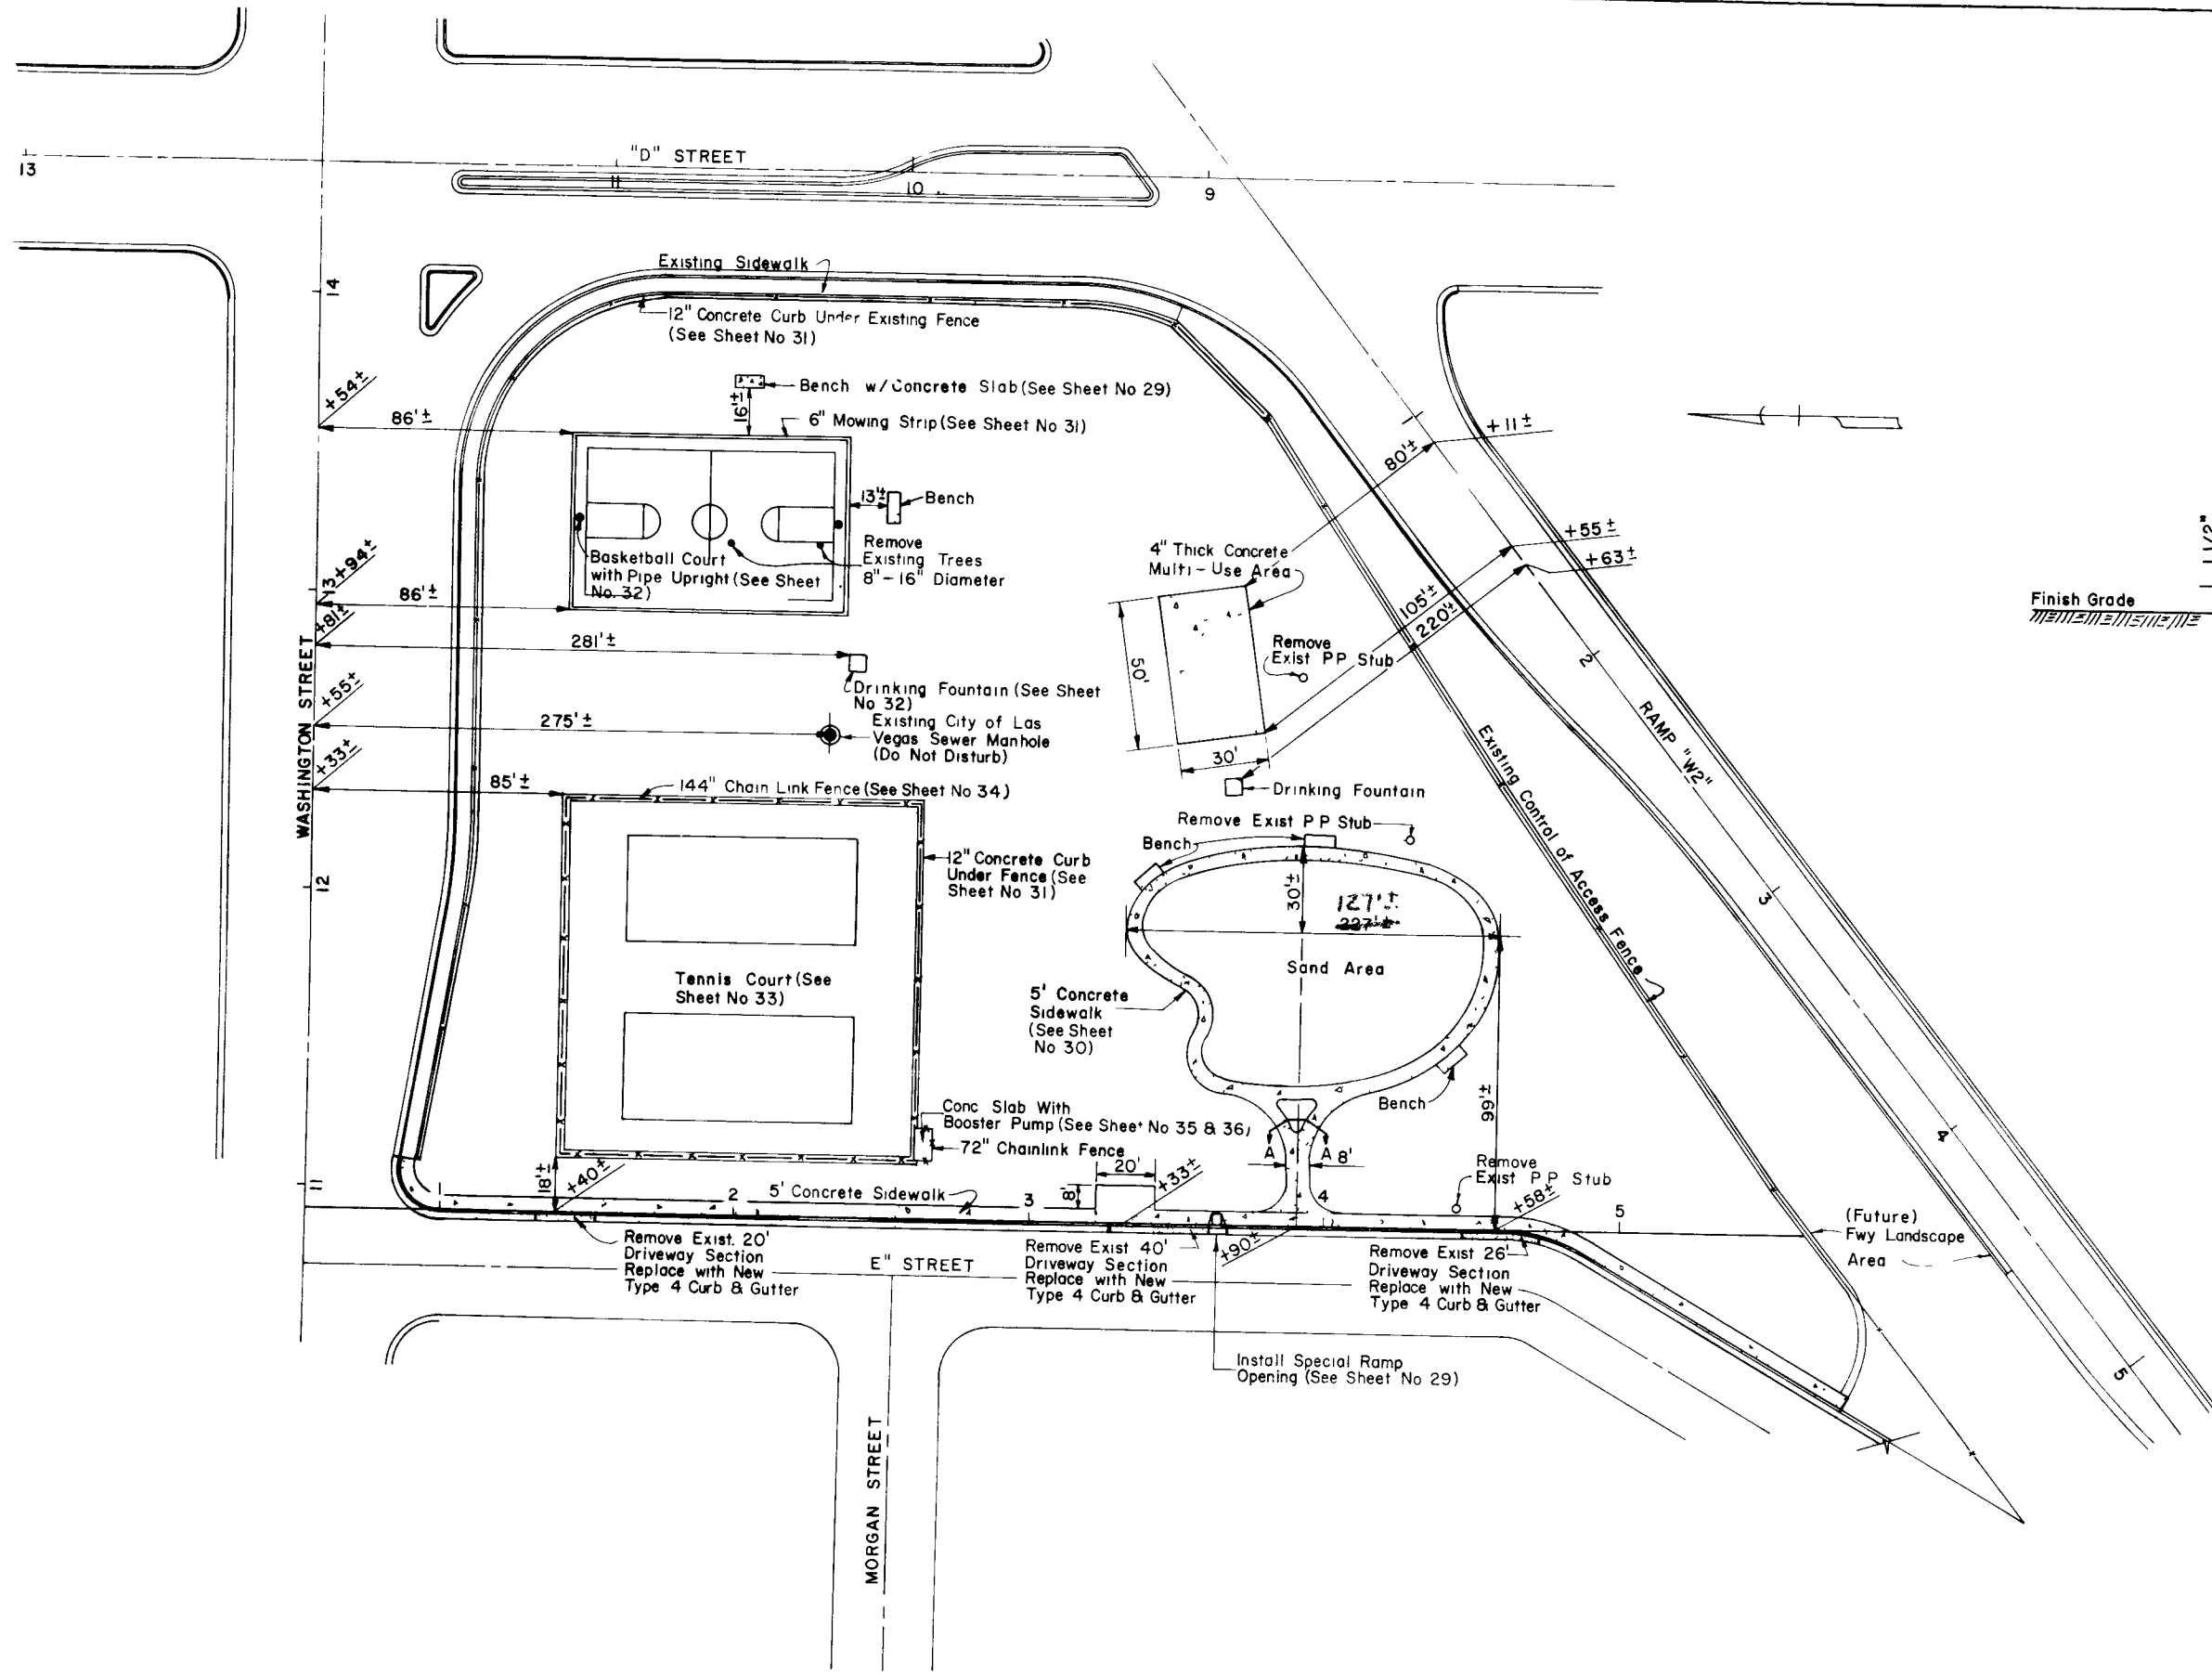

31552

STATE OF NEVADA
DEPARTMENT OF HIGHWAYS
**MORGAN STREET
MINI-PARK
CONSTRUCTION CONT**
650.26-4