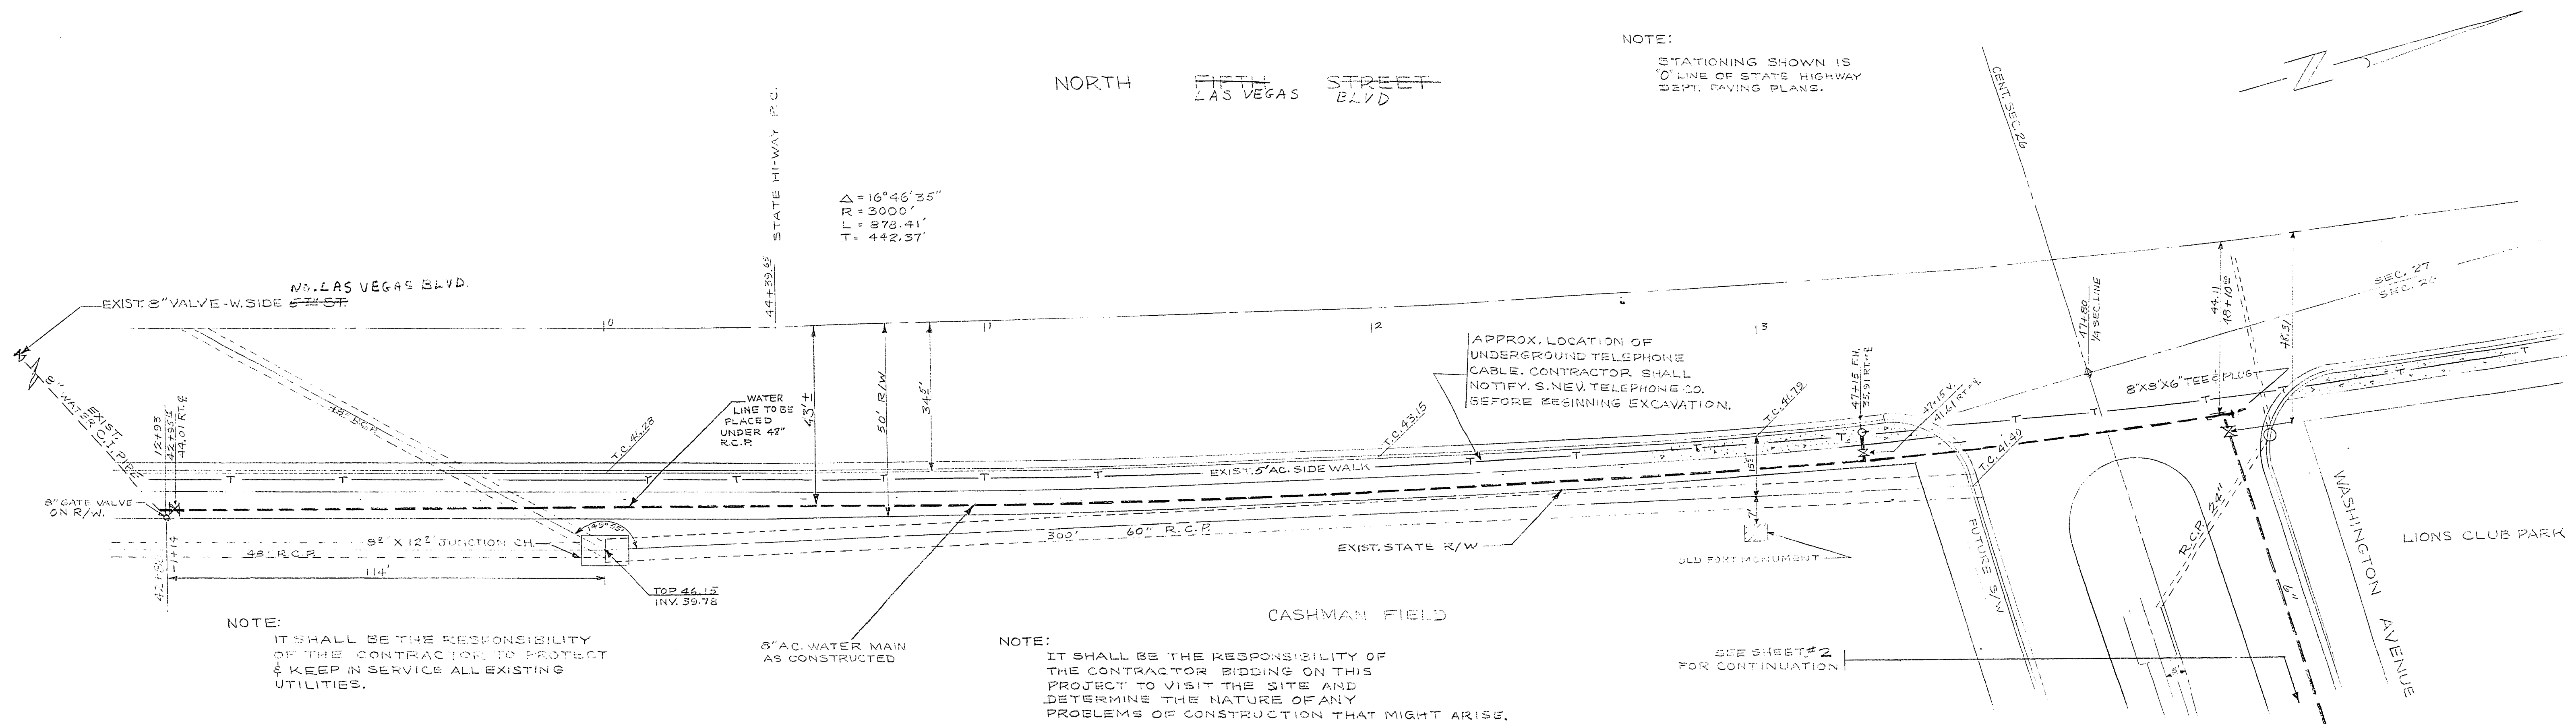


APPROVED BY		DATE
Las Vegas Valley Water Dist.		
Nevada State Highway Dept.		6/25/52
CITY OF LAS VEGAS, NEVADA ENGINEERING DEPT.		
LIONS CLUB PARK PROPOSED WATER LINE		
DESIGNED BY	L.H.	DATE
DRAWN BY	L. HARPER	7/11/52
CHECKED BY	R.L.	7/11/52
APPROVED	R.B. Jauer	CITY ENGR.
FIELD BOOK NO. 58-5X		WORK ORDER NO.
DRAWING NO.		650.9-V12