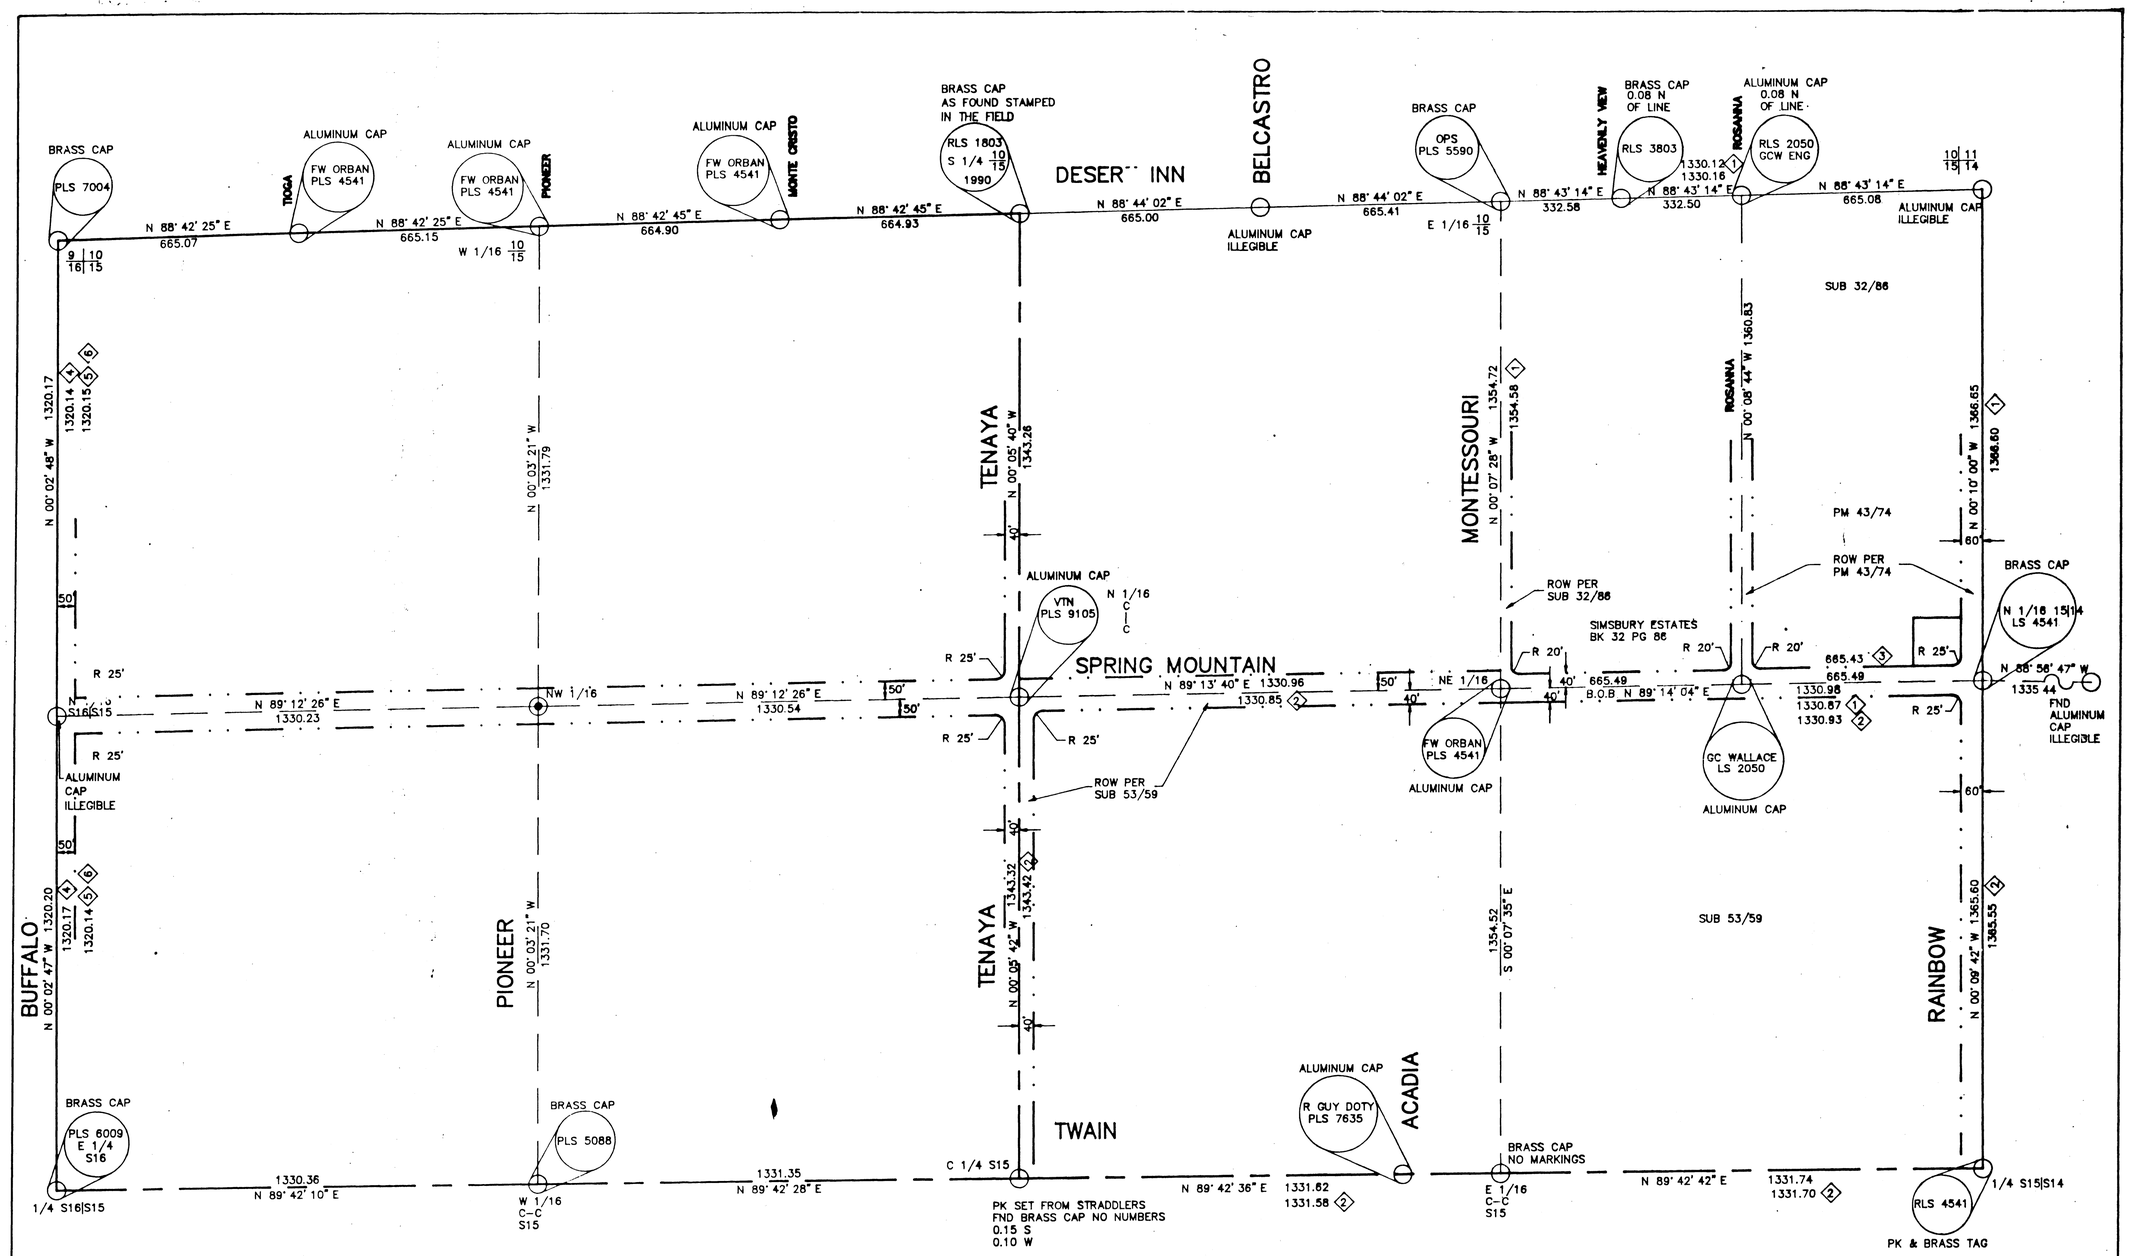

RECORD OF SURVEY FOR
A PORTION OF SECTIONS 16 AND 15
T. 21 S., R. 60 E., M.D.M.
CLARK COUNTY, NEVADA

WESCO SURVEYS, INC.
3305 WEST SPRING MOUNTAIN ROAD #60
LAS VEGAS, NEVADA 89102
(702) 367-0588

FILE NAME:	SHEET	DATE/DRAWN
SPRI01R1.DWG	NO. 2 OF 2 SHEETS	1-29-96/GAH 2-8-96/GAH 2-16-96/GAH
CHECKED BY: GTM 3-8-96		

22586

SHEET R-02

731-32