


980128

01130

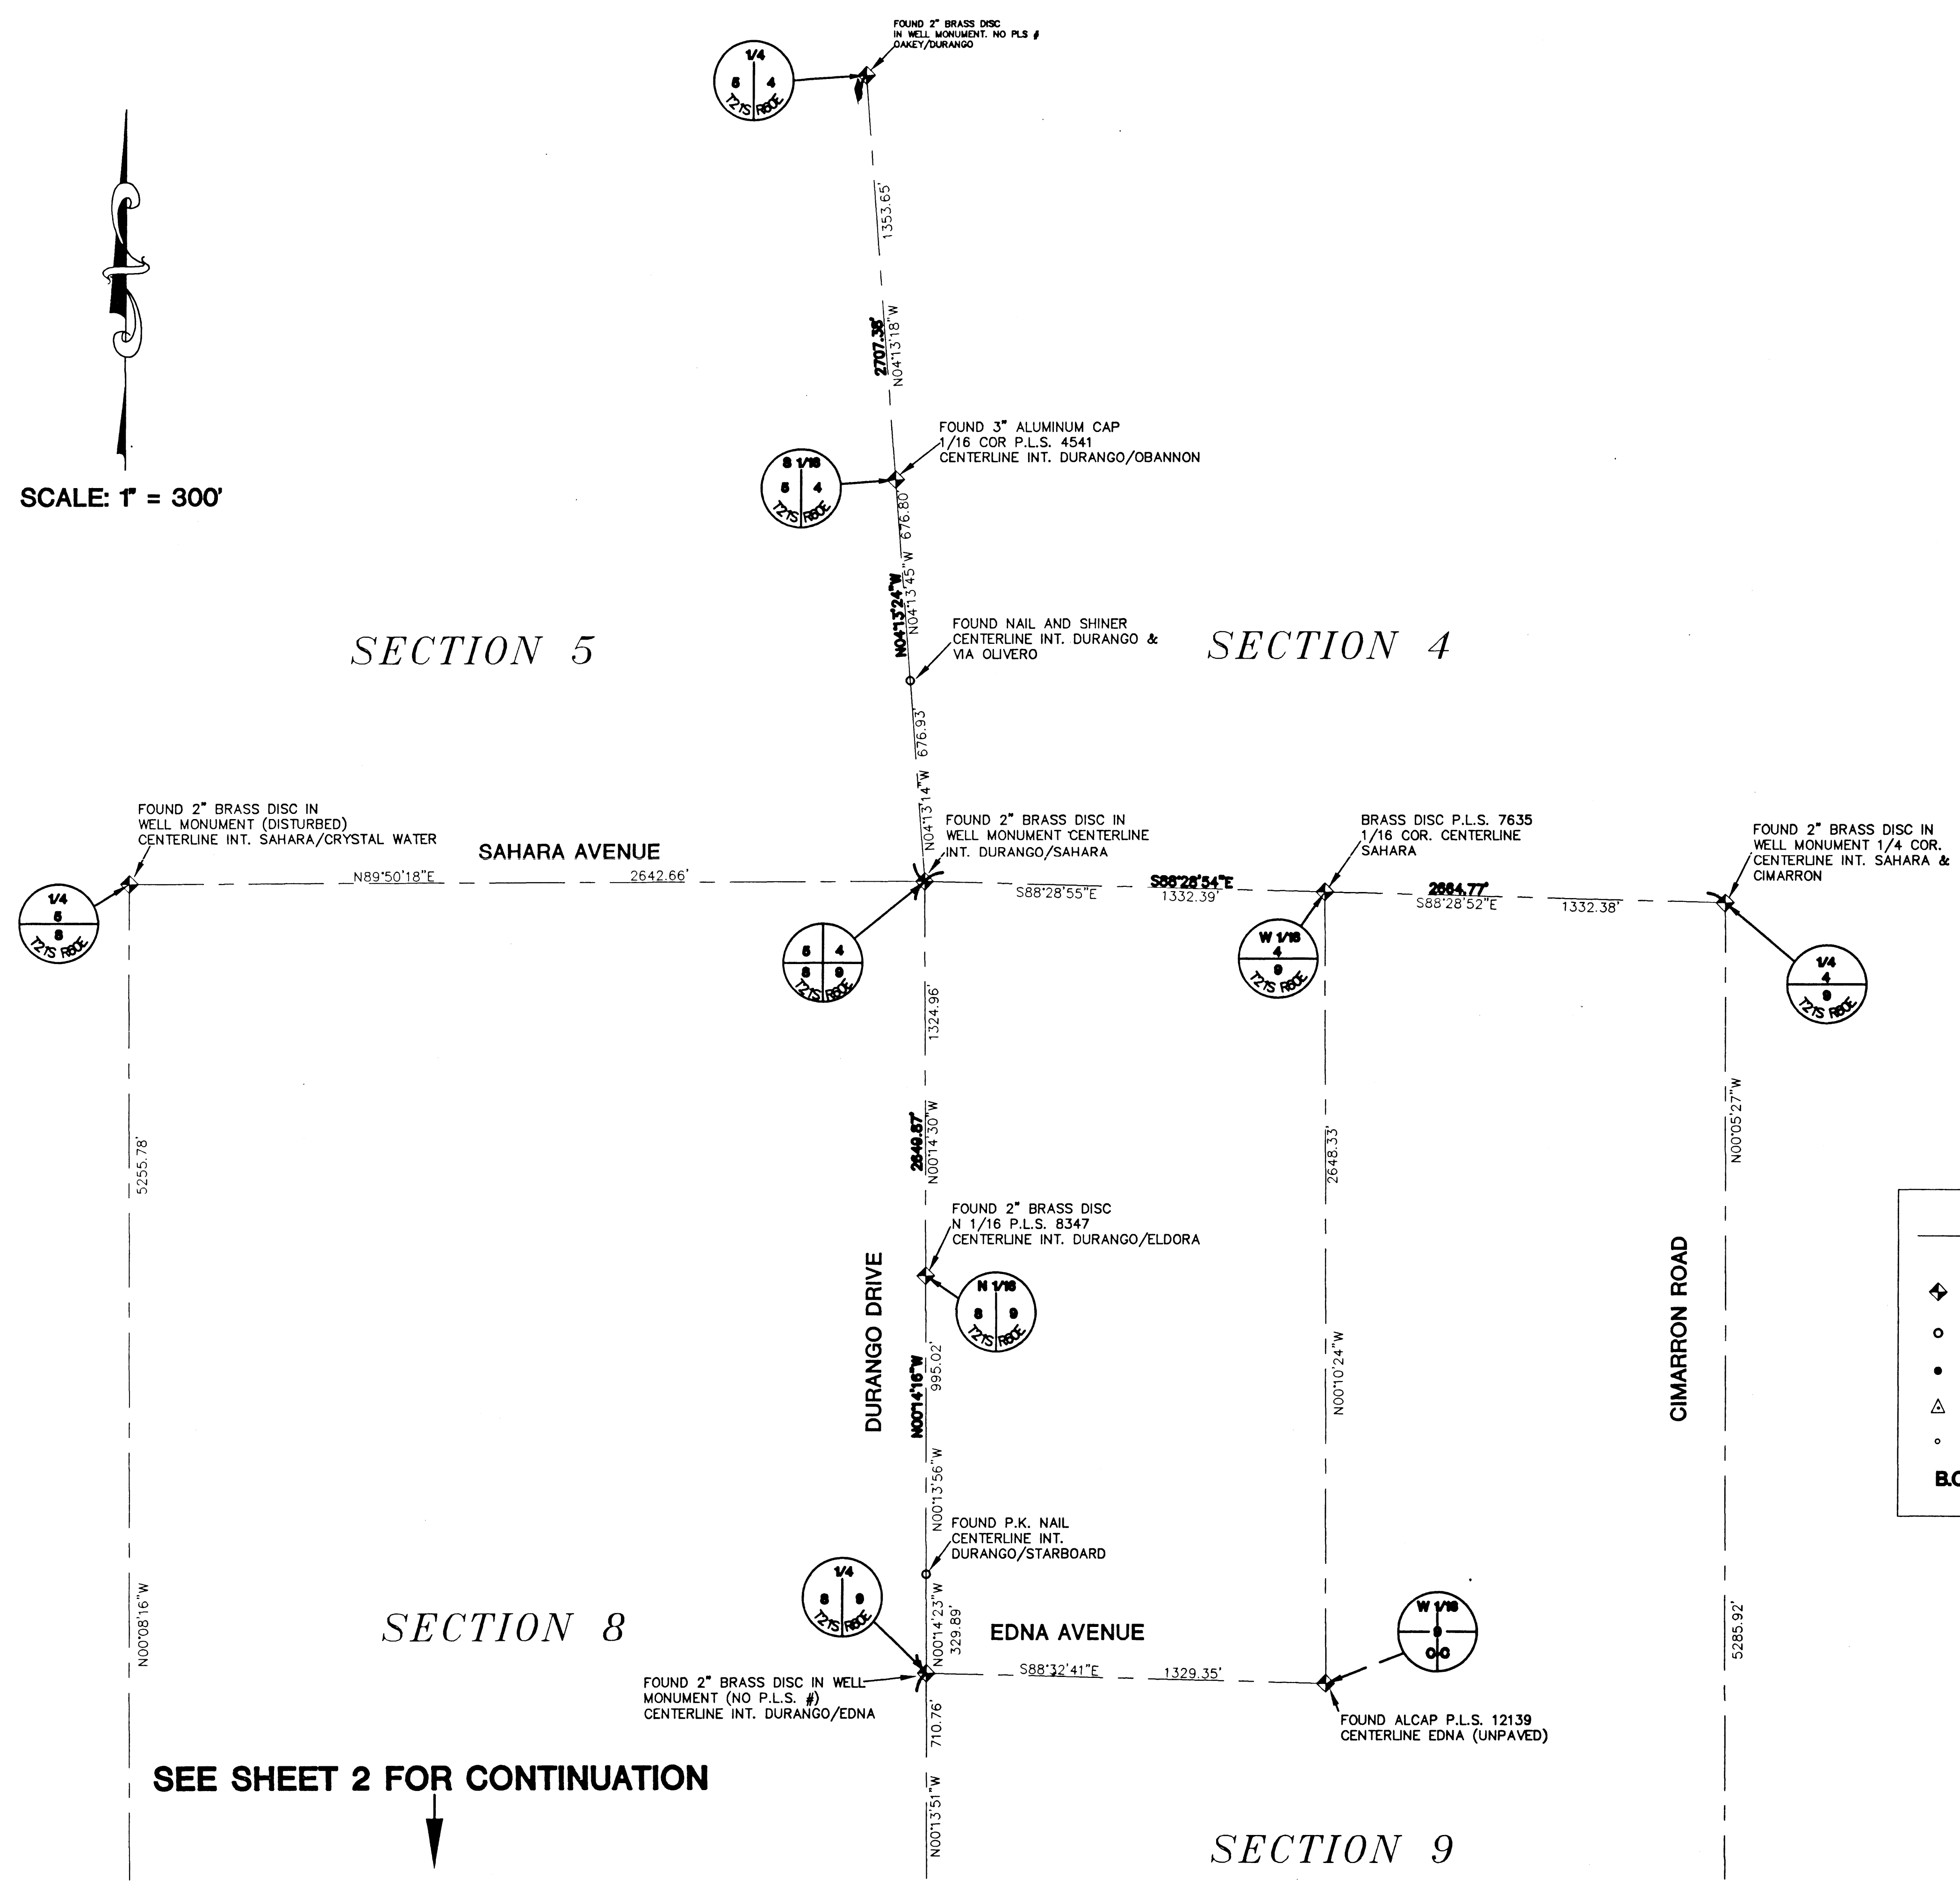

SCALE: 1" = 300'

SECTION 5

SECTION 4

SECTION 8

SECTION 9

SEE SHEET 2 FOR CONTINUATION

LEGEND

- SECTION LINE/STREET CENTERLINE
- FOUND SECTION CORNER MONUMENT AS NOTED
- FOUND MONUMENT AS NOTED
- SET REBAR AND ALCAP P.L.S. 7808
- SET MONUMENT AS NOTED
- LINE SEPARATOR - NO MONUMENTS SET OR FOUND
- B.O.B. BASIS OF BEARING

SHEET RS-03
OF RS-03
L-1568

Carter Burgess
Consultants in Engineering, Architecture,
Planning and the Environment
2955 East Sunset Road, Suite 105
Las Vegas, NV 89120
(702) 798-1007 Fax (702) 798-7056

RECORDER'S NOTE:	SHEET
ANY SUBSEQUENT CHANGES TO THIS MAP SHOULD BE EXAMINED AND MAY BE DETERMINED BY REFERENCE TO THE COUNTY RECORDER'S CUMULATIVE MAP INDEX.	3
	OF
	3

22588

FILED 9/30/2008
231-72