


OF THAT RECORD OF SURVEY RECORDED IN
FILE 174 OF SURVEYS, AT PAGE 96 FOR
THE CITY OF LAS VEGAS
LOCATED WITHIN SECTIONS 14 AND 15, TOWNSHIP 19 SOUTH,
RANGE 60 EAST, M.D.M., CLARK COUNTY, NEVADA

OF THAT RECORD OF SURVEY RECORDED IN
FILE 174 OF SURVEYS, AT PAGE 96 FOR
THE CITY OF LAS VEGAS
LOCATED WITHIN SECTIONS 14 AND 15, TOWNSHIP 19 SOUTH,
RANGE 60 EAST, M.D.M., CLARK COUNTY, NEVADA

SECTION LINE
QUARTER
SECTION LINE
SIXTEENTH
SECTION LINE
STREET
CENTERLINE
RIGHT-OF-WAY
LINE
PROPERTY
LINE
FOUND MONUMENT
AS NOTED

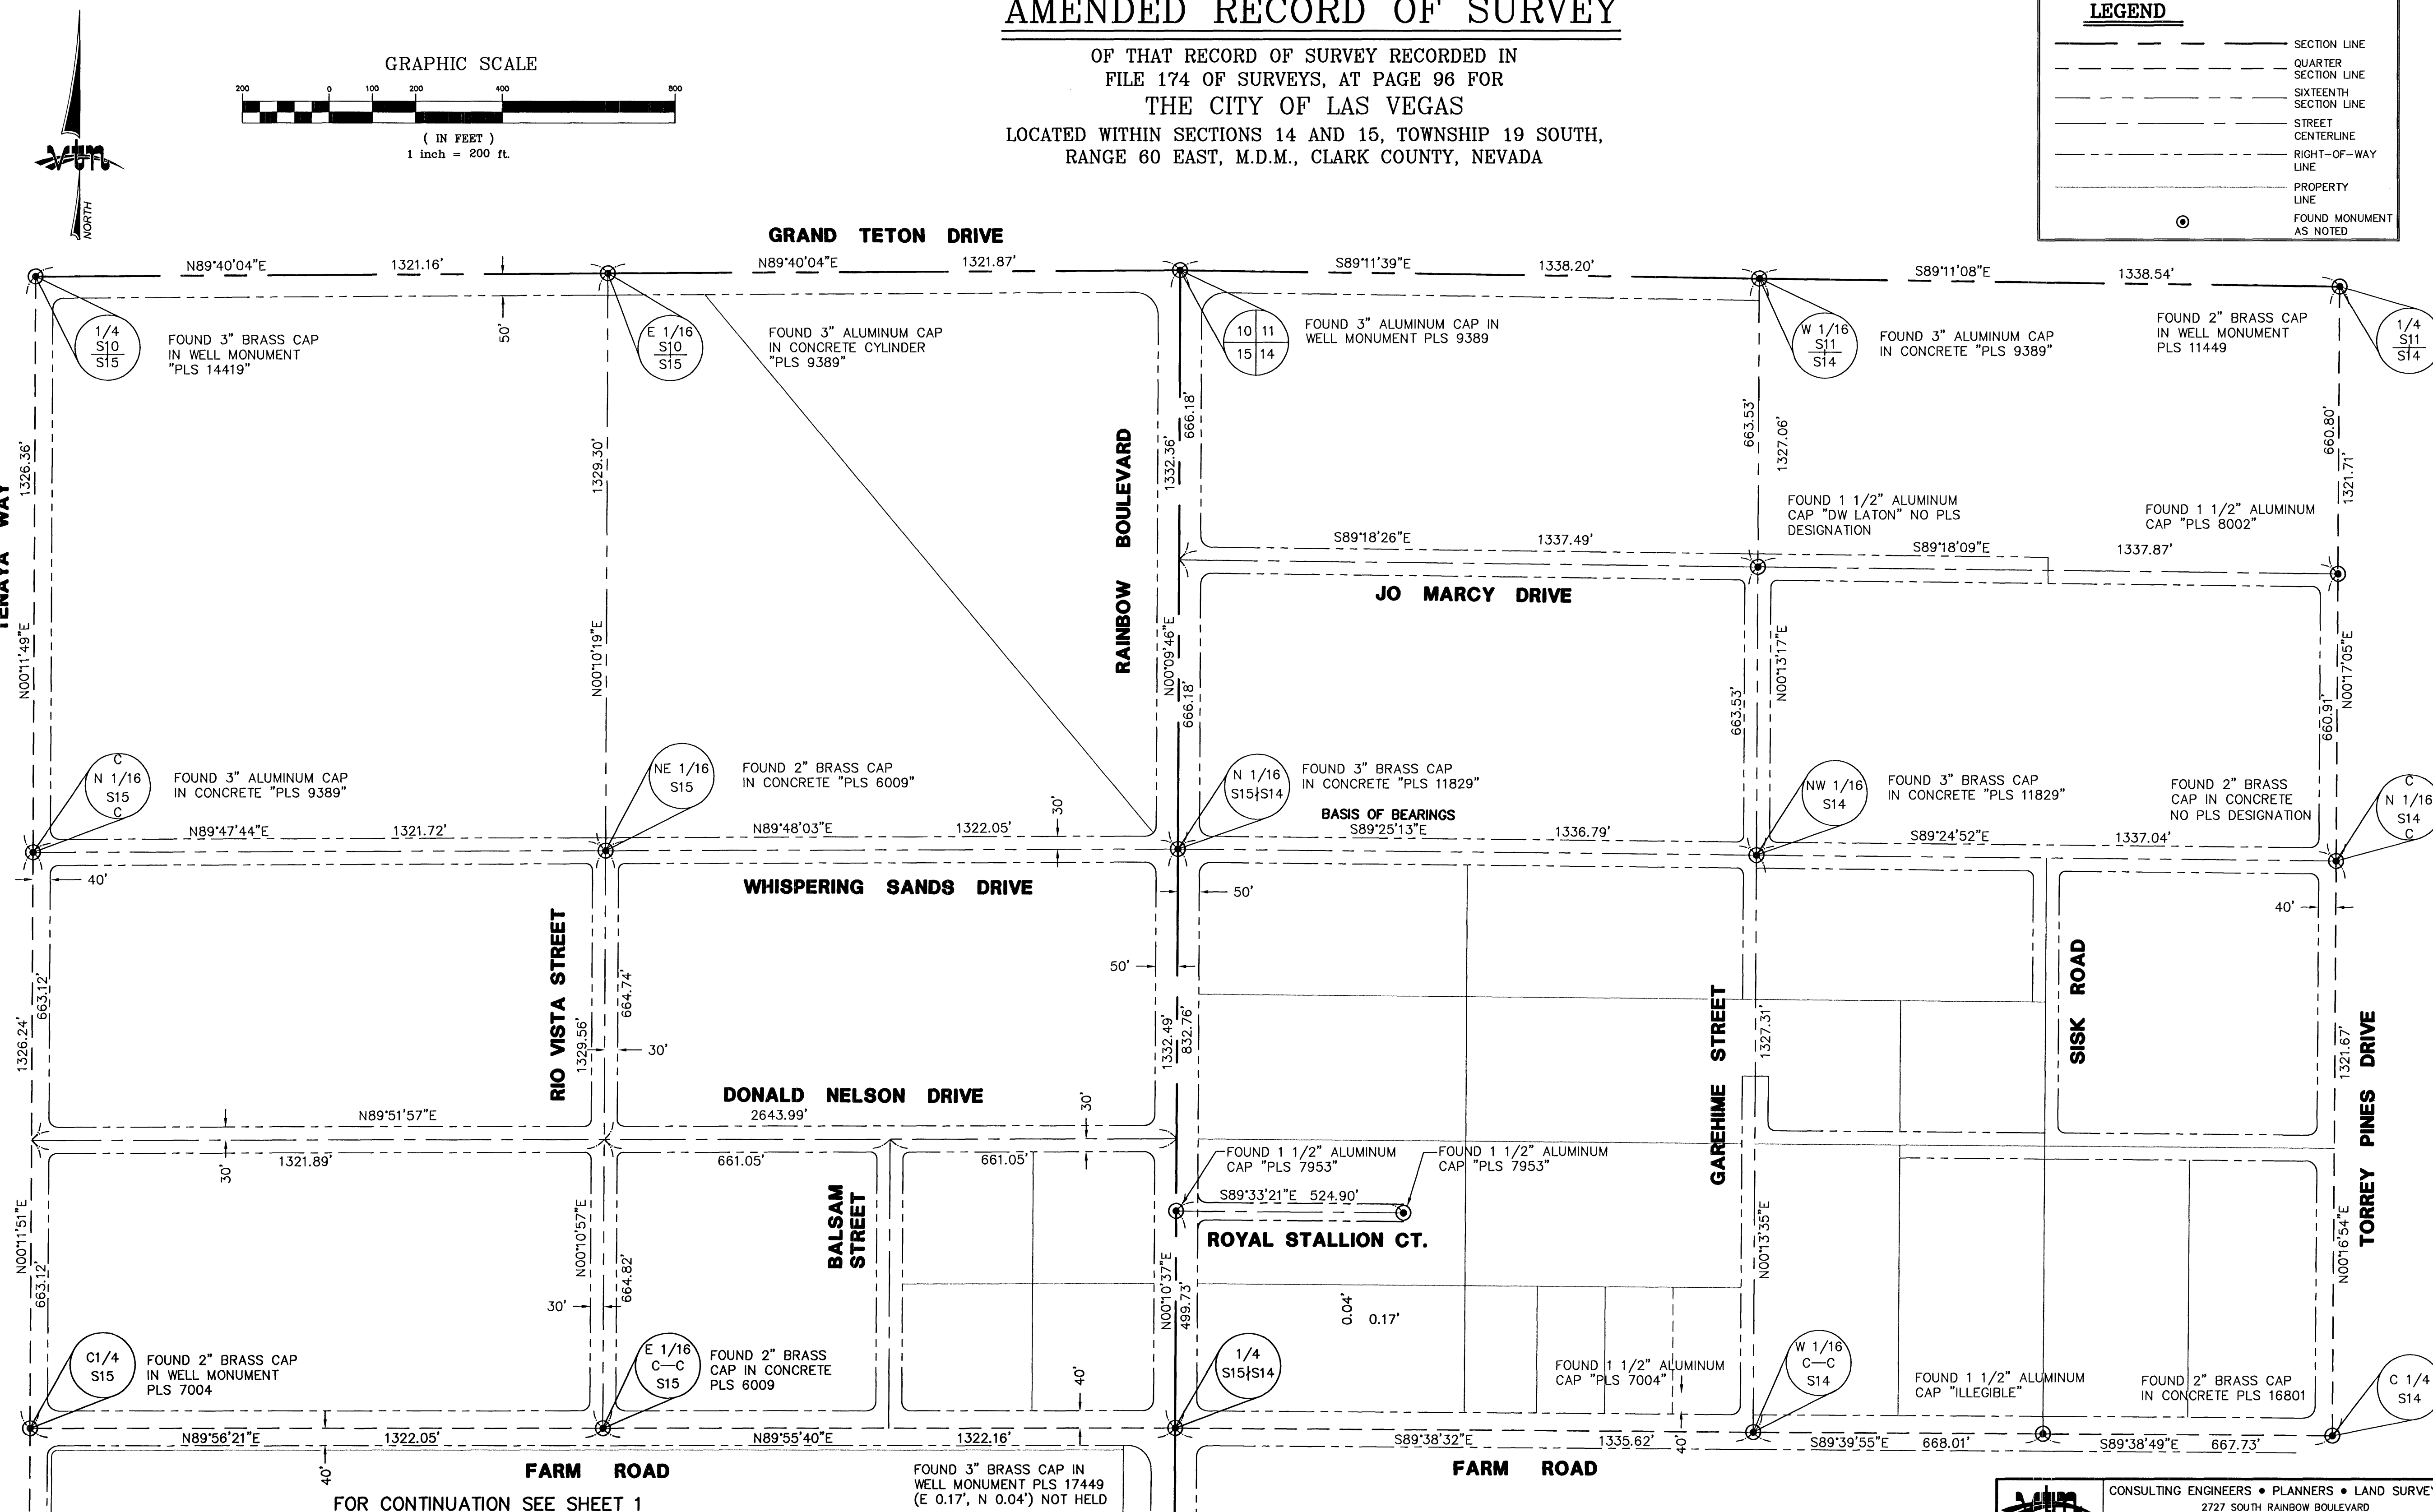

FOR CONTINUATION SEE SHEET 1

AVOID OVERHEAD POWER LINE
CONTACT. IT'S COSTLY

**Call
before you
Overhead**

1-702-227-2929

NEVADA POWER ENVIRONMENT AND
SAFETY SERVICES DEPARTMENT

Call before you Dig
Avoid cutting underground
utility lines. It's costly.

**Call
811**

OR

1-800-227-2600

OR
OUR COUNTY AND NEIGHBORING
1-702-455-7544



CONSULTING ENGINEERS • PLANNERS • LAND SURVEYORS
2727 SOUTH RAINBOW BOULEVARD
LAS VEGAS, NEVADA 89102
(702) 873 - 7550 FAX (702) 362 - 2597

**AMENDED RECORD OF SURVEY
OF THAT RECORD OF SURVEY RECORDED IN
FILE 174 OF SURVEYS, AT PAGE 96 FOR
THE CITY OF LAS VEGAS**

LOCATED WITHIN SECTIONS 14 AND 15, T. 19 S., R. 60 E., M.D.M.
CLARK COUNTY, NEVADA.

SCALE: 1" = 200'	W.O.# 6952	DATE: DEC. 2008	SHEET	OF
FILE: G:\6952\	DRN. BY: KAK	REV.:	2	2
6952CTRL.DWG	CKD. BY: MSC/JCF			

H#23161

PUBLIC WORKS DEPARTMENT



HORIZONTAL CONTROL PLAN IV

EMBEDDED RECORD OF SURVEY

**LAS VEGAS WASH-MIDDLE BRANCH
RAINBOW STORM DRAIN
ELKHORN TO GRAND TETON**

2727 SOUTH RAINBOW BOULEVARD
LAS VEGAS, NEVADA 89146-5148
PH. (702) 873-7550
FAX (702) 362-2597
WEB SITE WWW.VTNNV.COM




DRAWN BY: JCF 4/21/09

DESIGNED BY: VTN

CHECKED BY: _____
MSC _____ 4/21/09

PROJECT NO: 6952

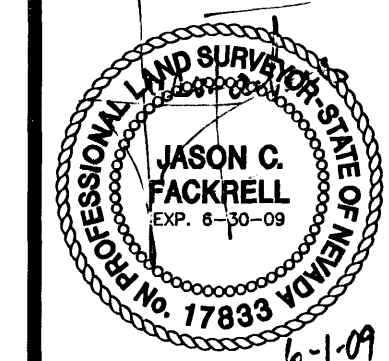

SHEET
HC4
7 OF 70 SHEETS
DRAWING NO.
731-87-1

p:\6952\6952CTRL.dwg;kimk; Jun 01, 2009 - 9:47am