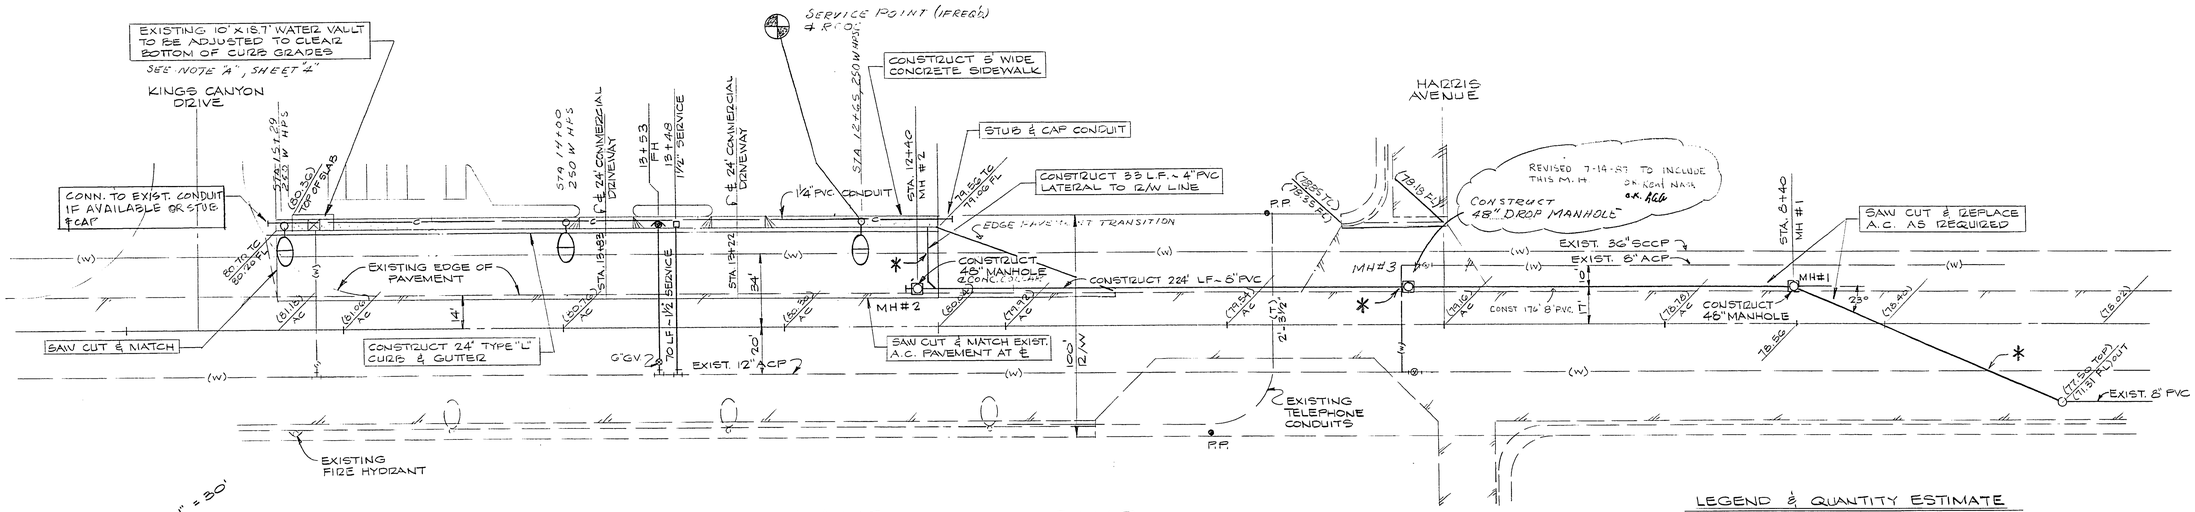

LEGEND & QUANTITY ESTIMATE

⊕	250 W HPS LUMINAIRE	3 EACH
—c—	1¼" PVC CONDUIT	302 LIN. FT.

* NOTE: ENCASE ALL SEWER LINES IN CONCRETE WHERE SEPERATION BETWEEN WATER LINES IS LESS THAN 24".

REGISTERED PROFESSIONAL ENGINEER — HERBERT R. CHAMPION — CIVIL — No. 3791 — STATE OF NEVADA

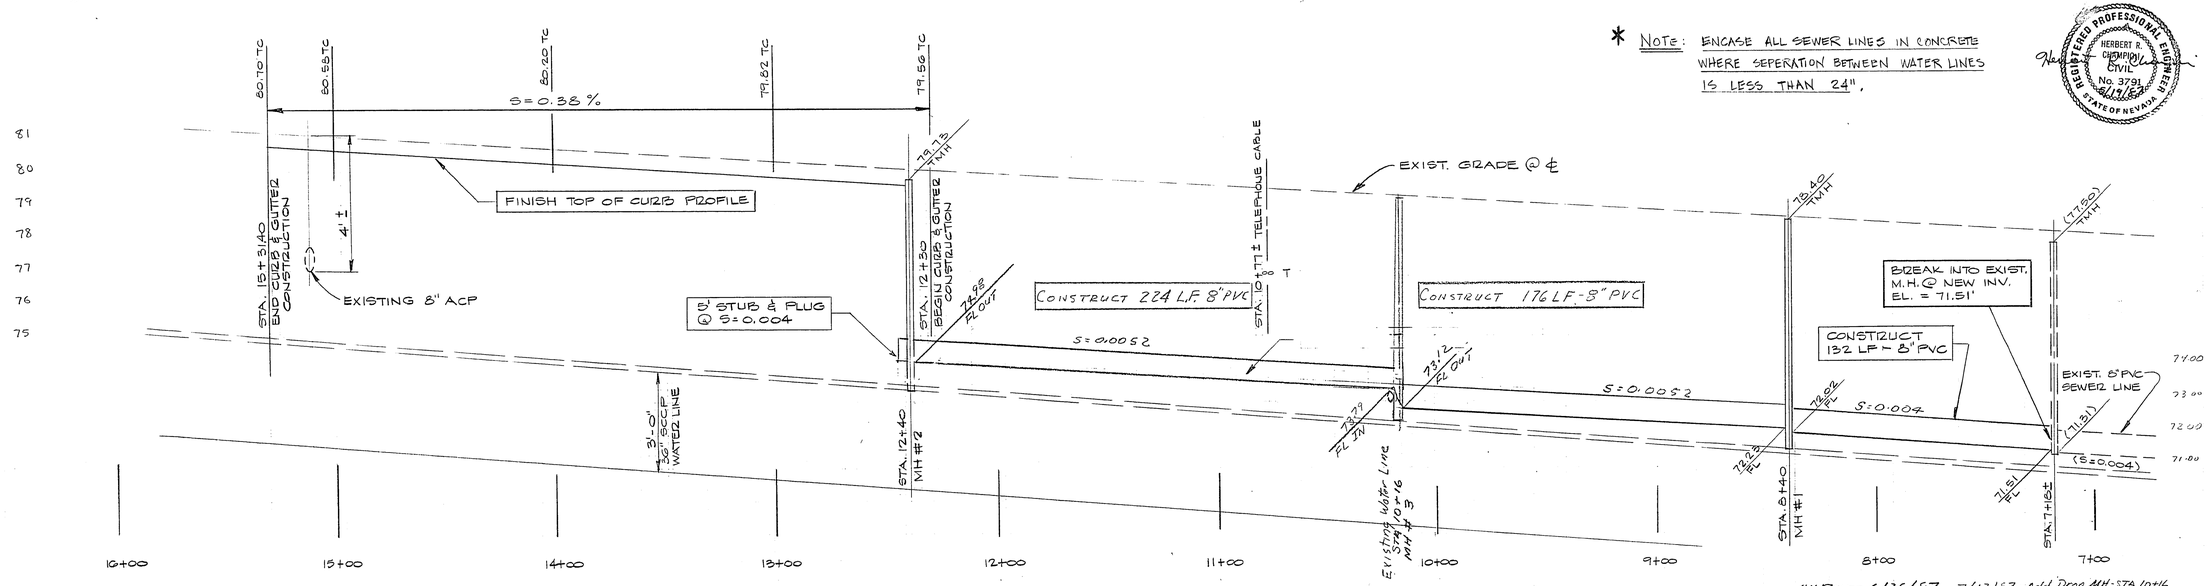

HRL Rev-- 6/25/87, 7/13/87 - Add Drop MH - STA 10+16

SCALE

HORIZONTAL 1" = 30'
VERTICAL 1" = 2'

LAMB BOULEVARD STREET IMPROVEMENT PLAN & PROFILE

SHAUNA PLAZA

BEN LEWIS ENGINEERING
745 WEST SUNSET ROAD # 3
HENDERSON, NEVADA 89015
PHONE (702) 564-1553, (702) 877-1938

SHEET 3 OF 4

107-V1504

5-3-201