7-13-88

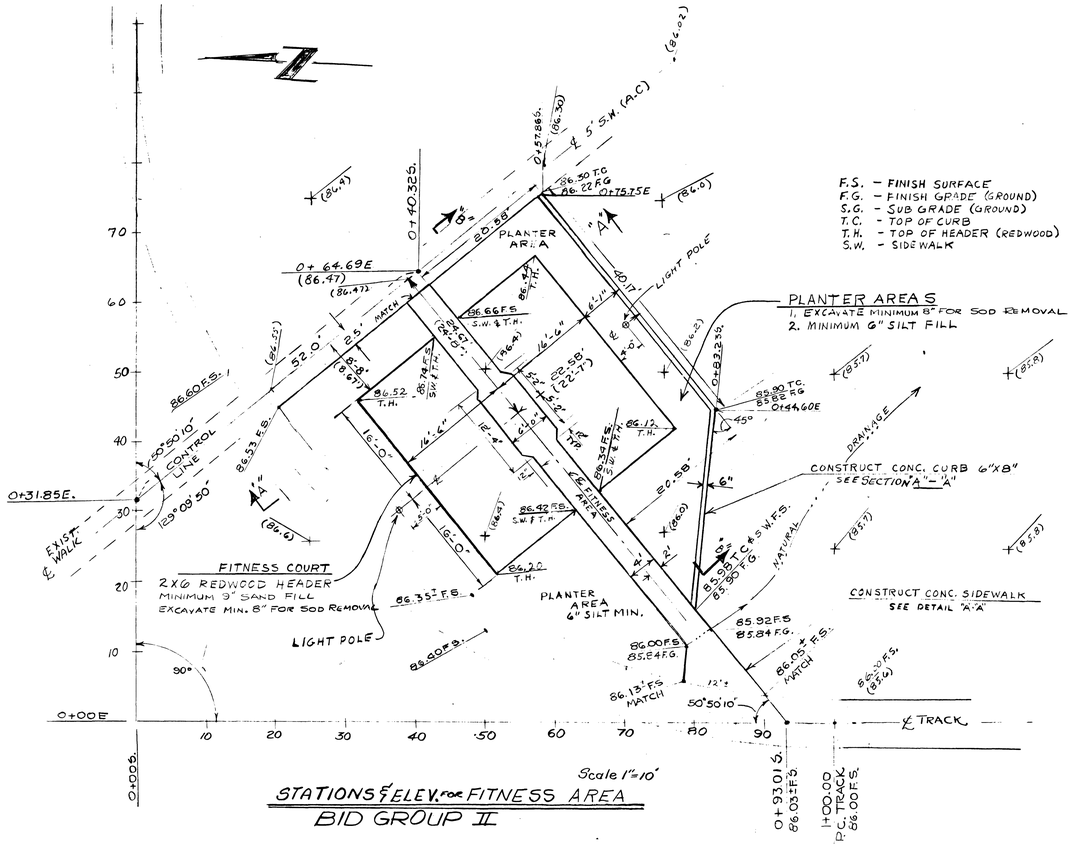

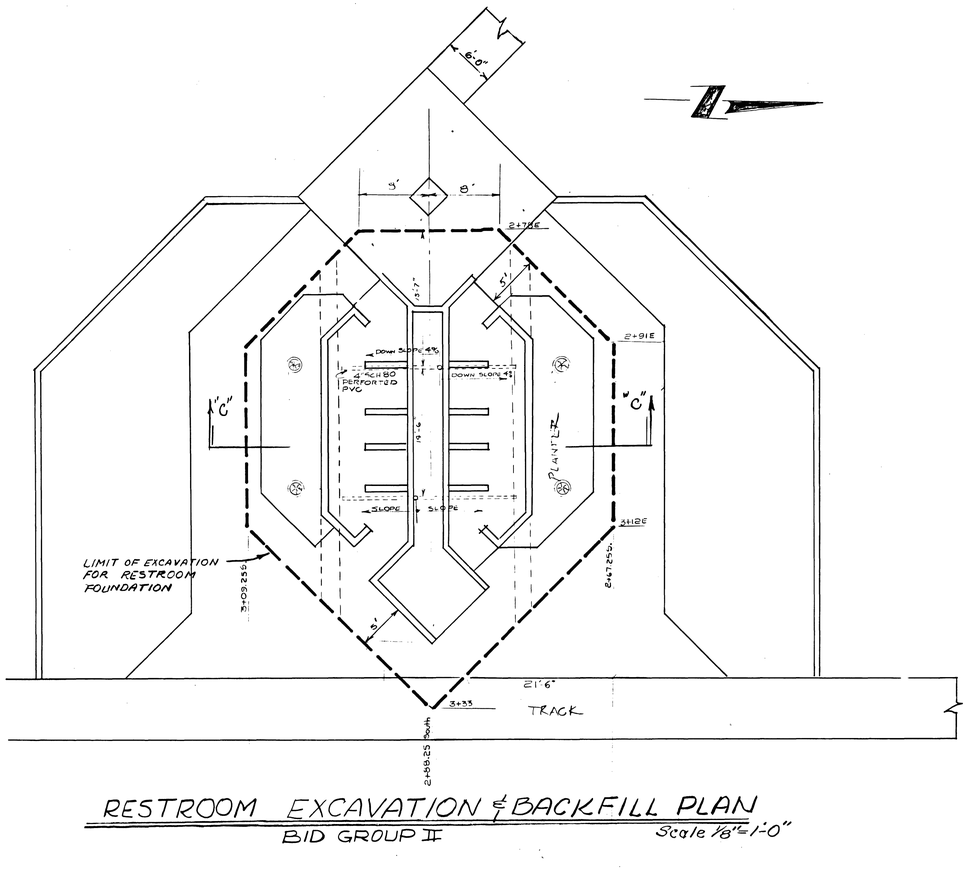

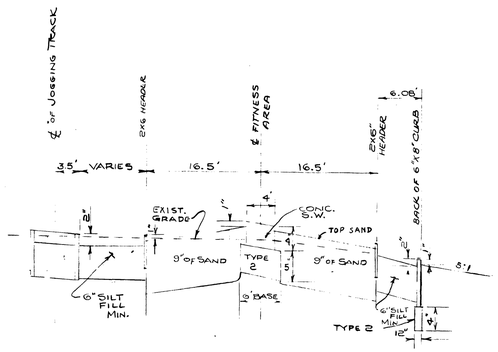

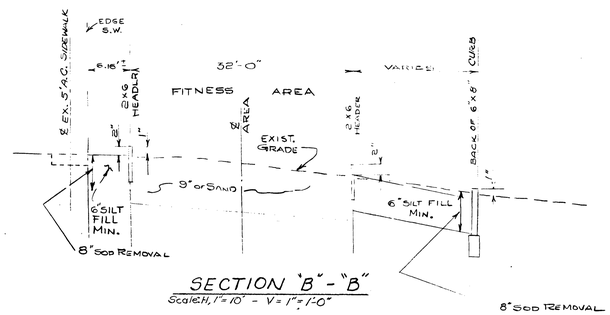

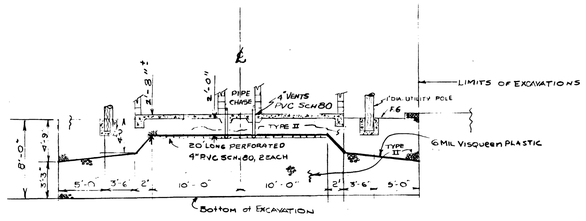

CONTRACT DRAWING
JUNE 1988
AS BUILT

Dept. of Engineering Services — Engineering Design Division

GRADING PLAN
RESTROOM & FITNESS AREA
JAYCEE PARK
PHASE II

CITY OF LAS VEGAS NEVADA

Drawing no. 650.6 - 20 | 7/22

Revisions	Date

W.A. WU-6090
Scale (h) Noted | Scale (v)
Fld. bk. no. 83-7X | Date 11-28-83
Design by D. MCGONEGLE | Drawn by
Approved by | Date