


12-1-78

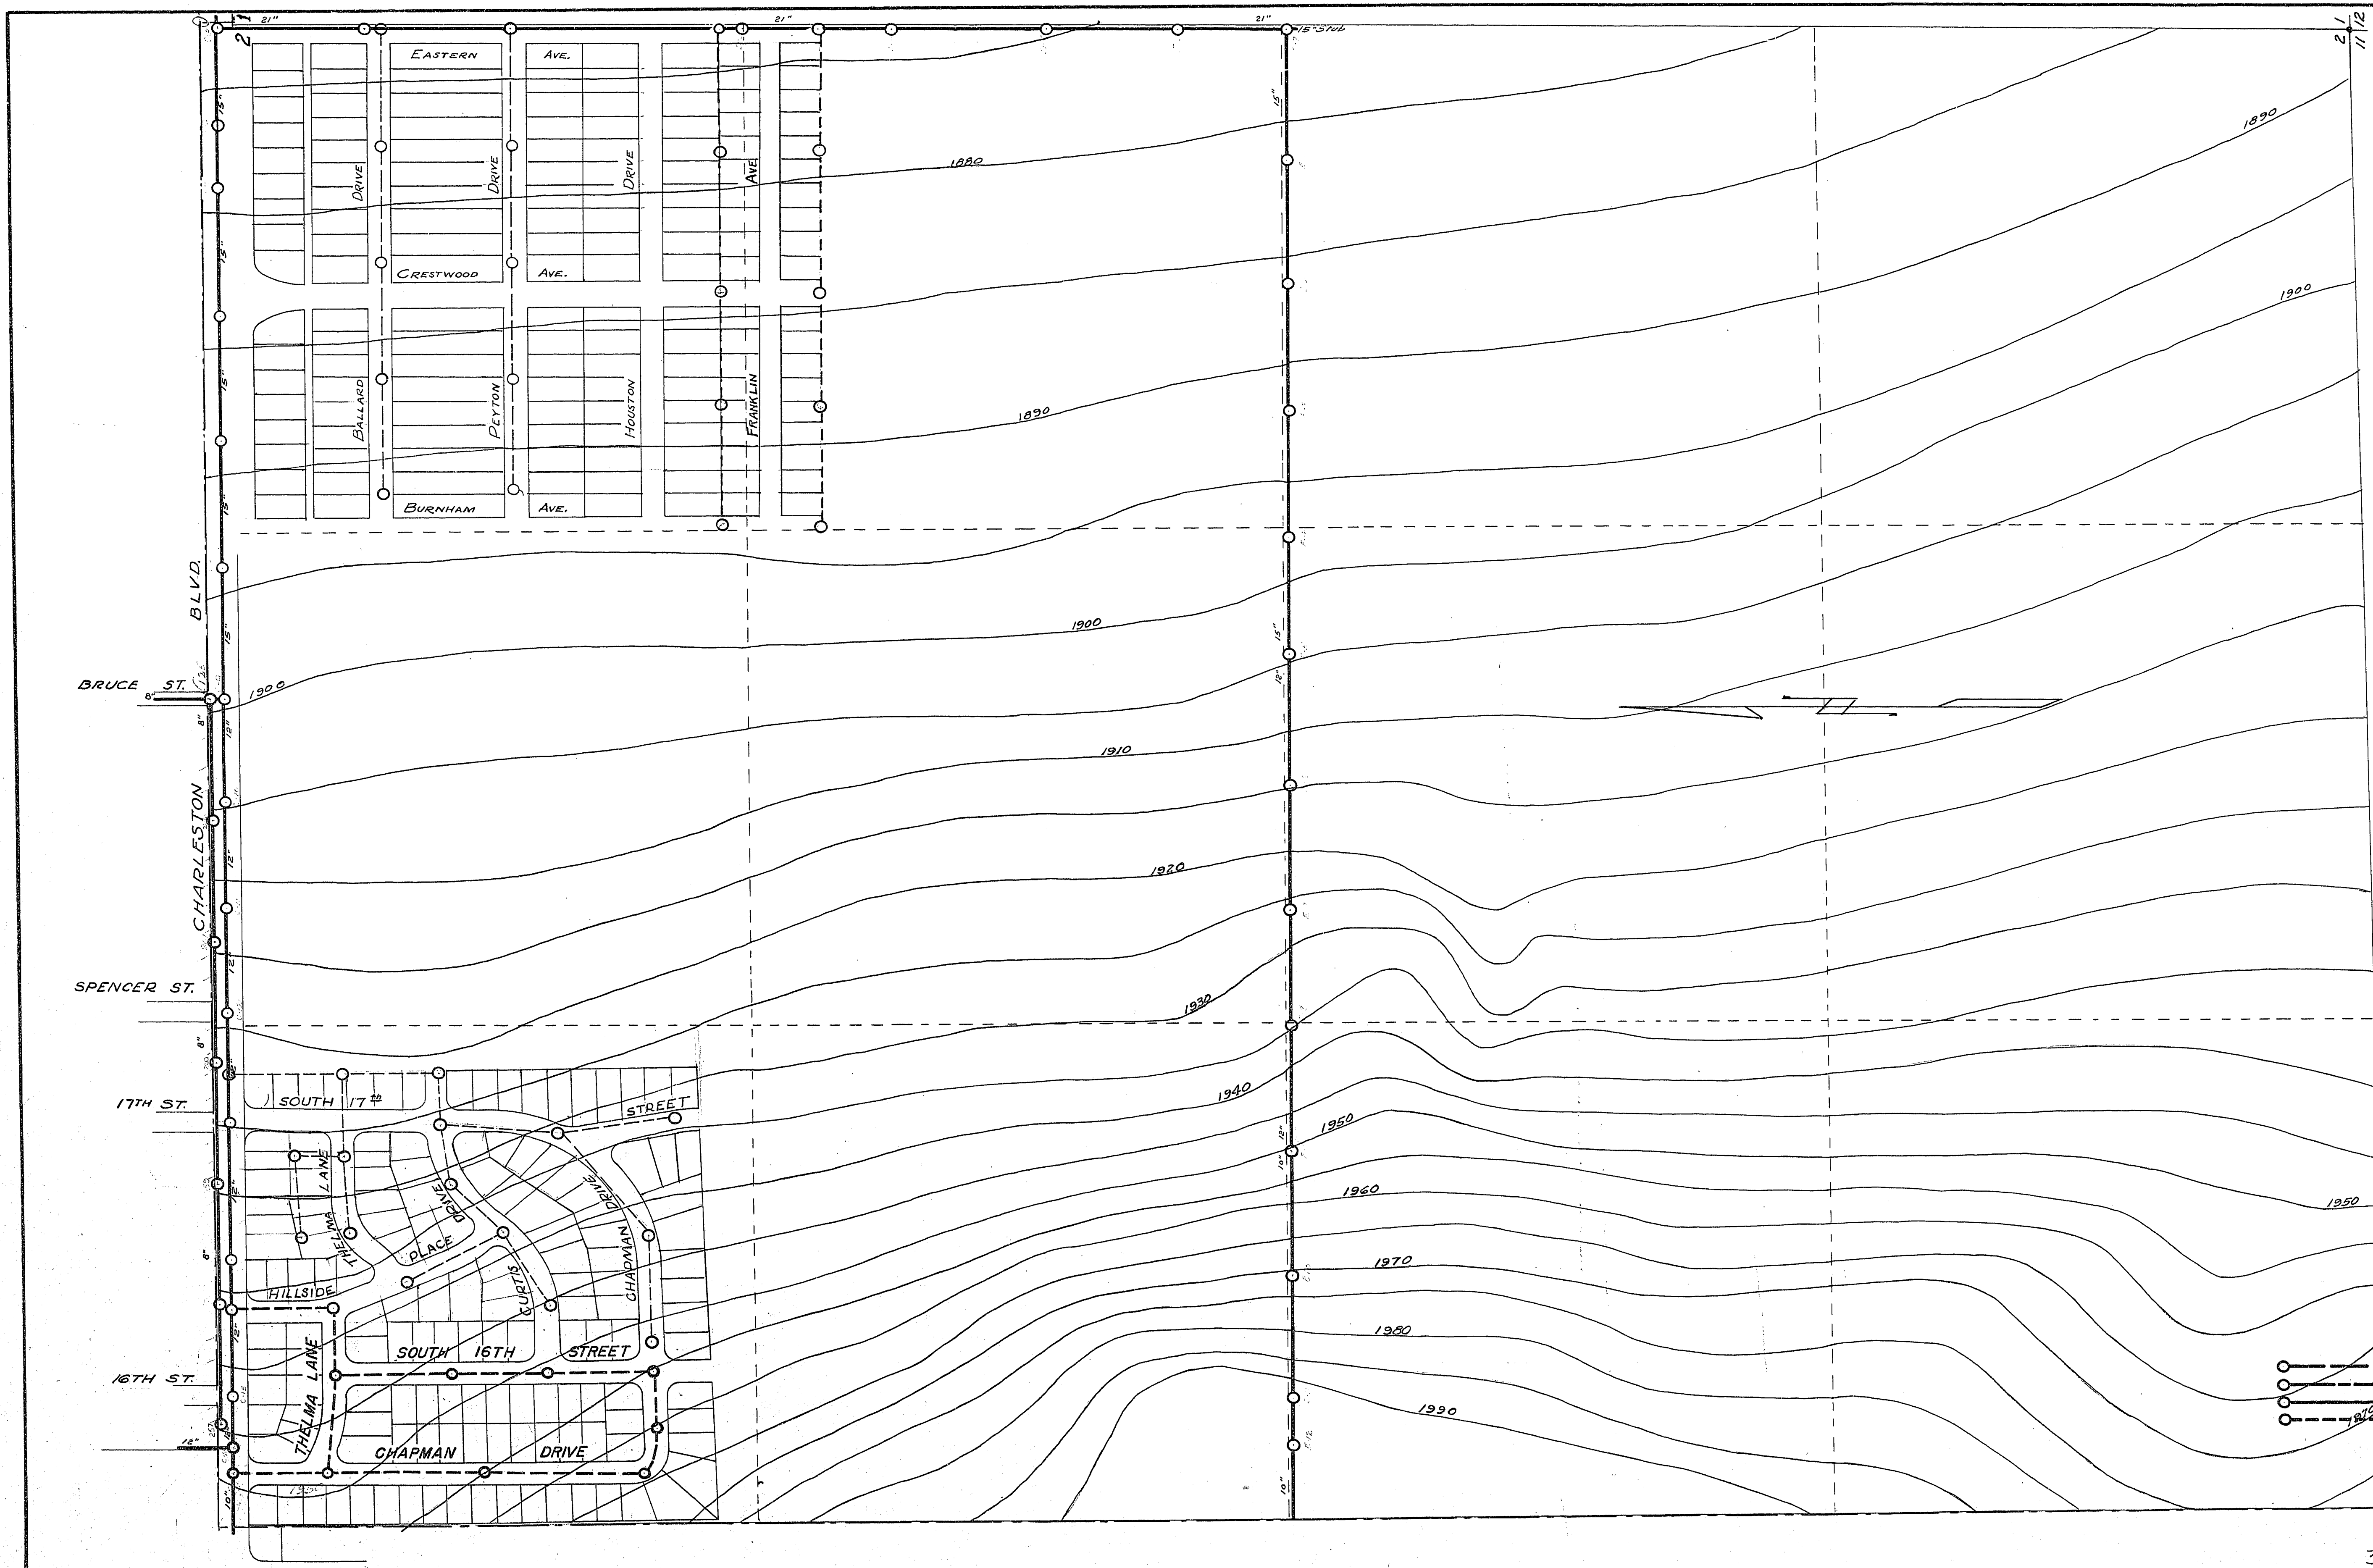

- LEGEND
- 1912 SEWER SYSTEM
 - 1932 SEWER SYSTEM
 - 1942 SEWER SYSTEM
 - MISCELLANEOUS
 - CLEAN-OUT A-4-64
 - FLUSH BOX
 - MANHOLE

307-W123

LAS VEGAS SEWERS
CURRIE ENGR. CO. SAN BERNARDINO, CALIF.

8