



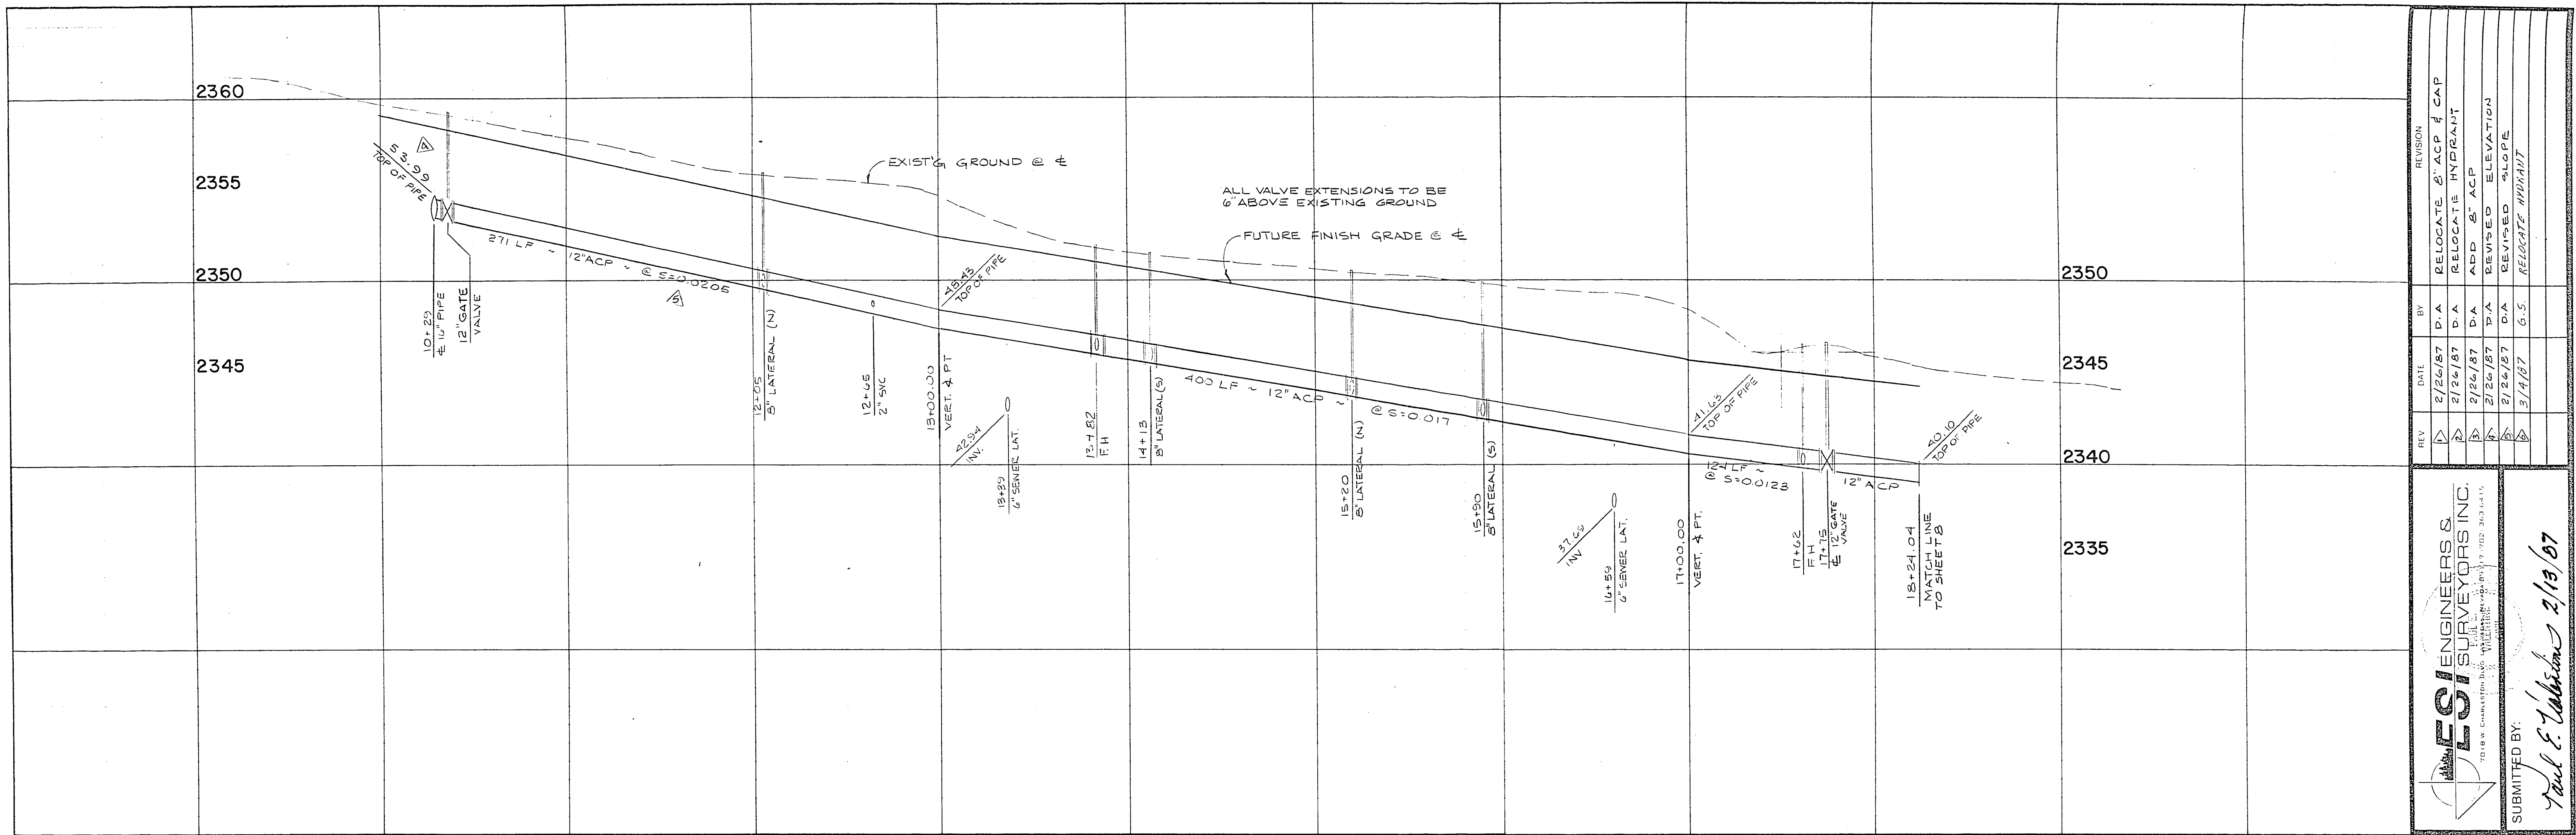

REV	DATE	BY	REVISION
1	2/26/87	D.A.	RELOCATE 8\" ACP & CAP
2	2/26/87	D.A.	RELOCATE HYDRANT
3	2/26/87	D.A.	ADD 8\" ACP
4	2/26/87	D.A.	REVISED ELEVATION
5	2/26/87	D.A.	REVISED SLOPE
6	3/4/87	G.S.	RELOCATE HYDRANT

ESI ENGINEERS & SURVEYORS INC.	SUBMITTED BY:
701 B W. CHURCH STREET, SUITE 200, LAS VEGAS, NV 89101	Paul E. Valentin 2/13/87

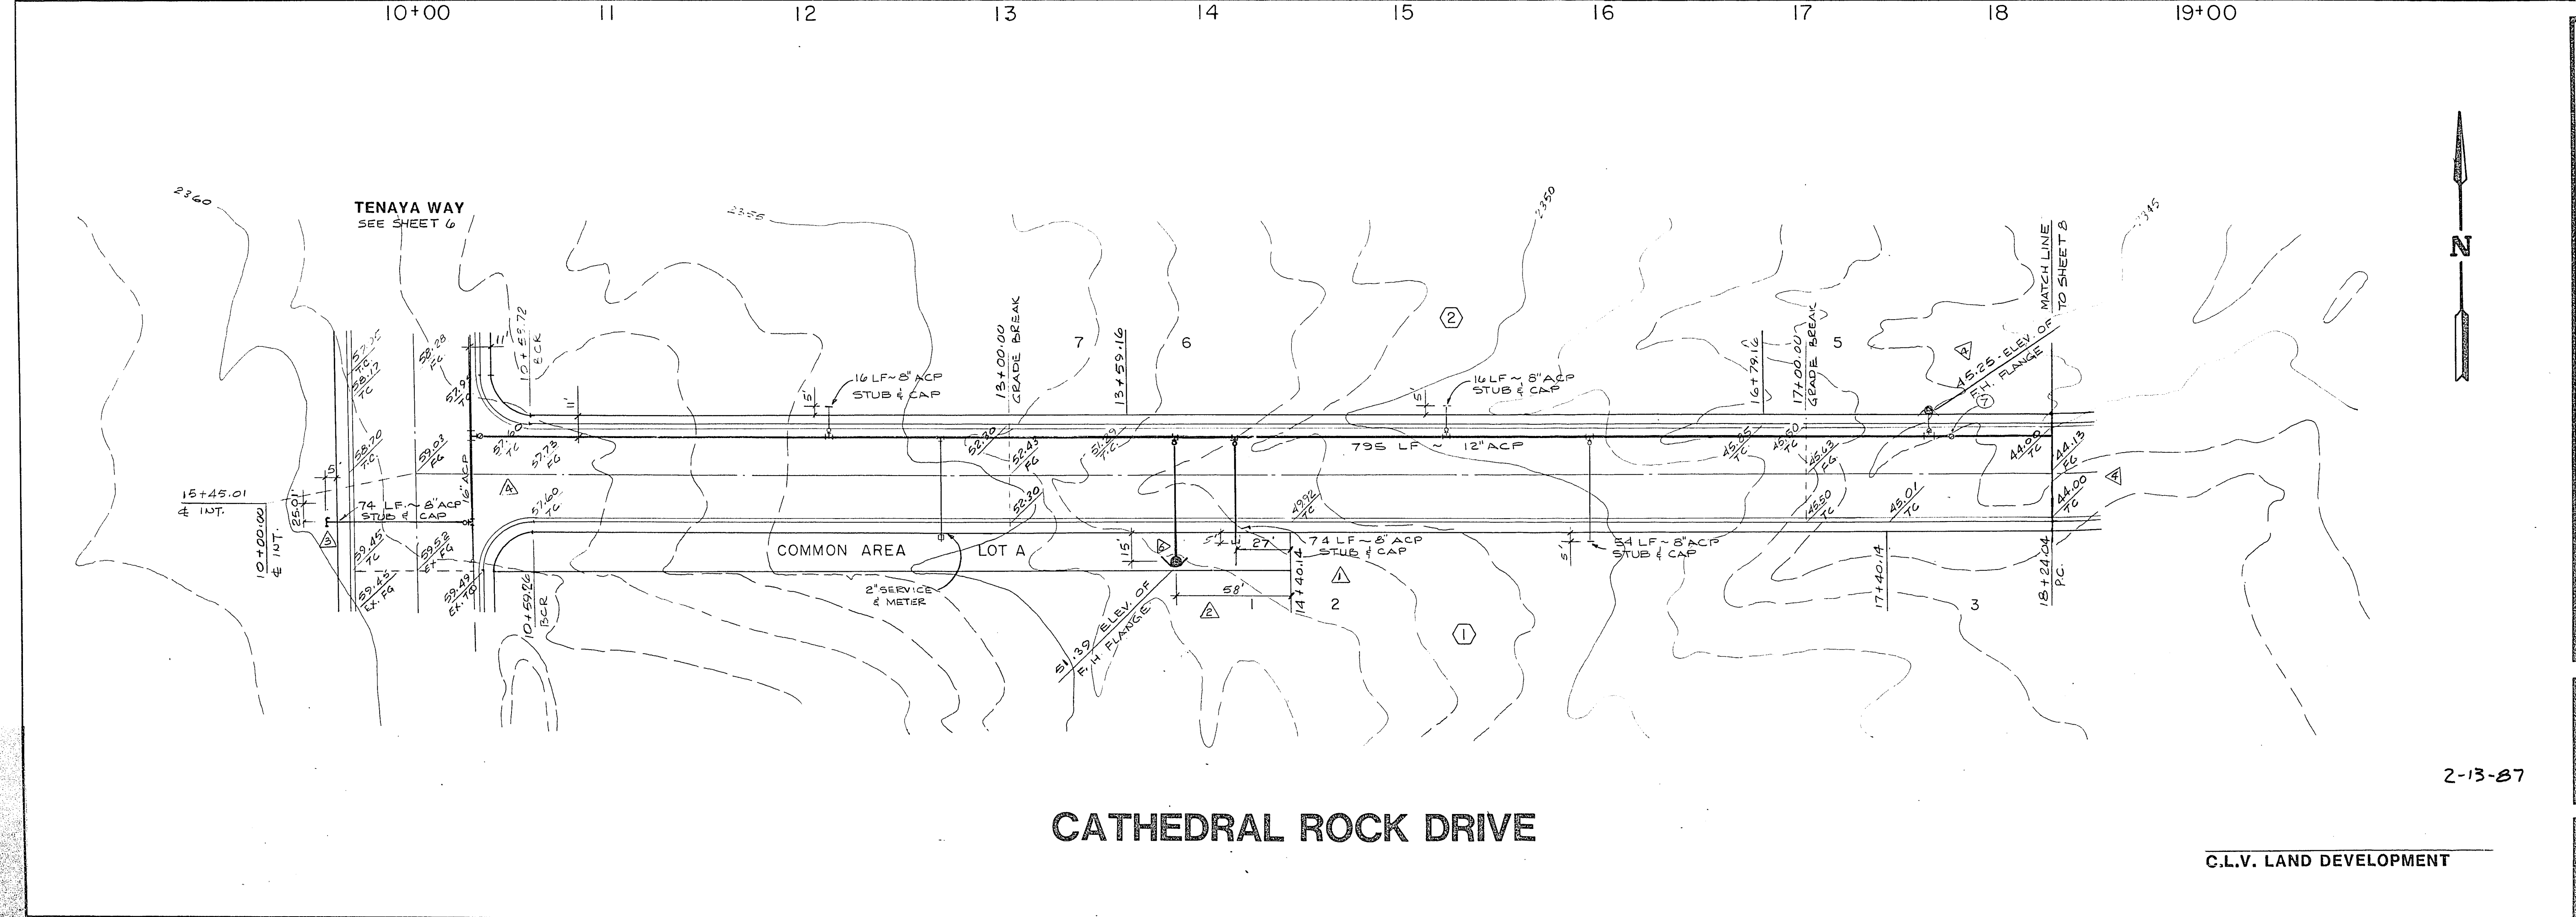

TITLE	WATER PLAN & PROFILE (CATHEDRAL ROCK DRIVE)
PROJECT	LAS VEGAS TECHNOLOGY CENTER UNIT NO. 1
WO NO.	4069
BY	RPF
DATE	2/87
SCALE	HOR. 1"=40' VERT. 1"=4'
SHEET	7
OF 13 SHEETS	

C.L.V. LAND DEVELOPMENT