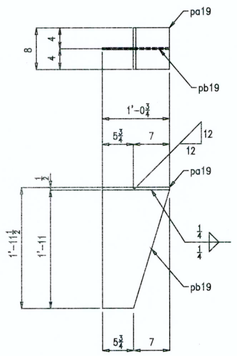

ONE - PLATE - 19A

SHOP BILL

MARK	QTY	DESCRIPTION	FT	IN	REMARKS	WT
19A	ONE	PLATES				
pa19	ONE	FB 1/2x7	0	8	A36	
pb19	ONE	PL 3/8x12 3/4	1	11	A36	

GUARDRAIL NOTES
1. LIN. FT. LENGTH INCLUDES ADDITIONAL 1'-6±
2. ALL G.R. JOINT TO BE WELDED & GRIND SMOOTH

APPROVAL AUTHORITY:
VERIFICATION OF DIMENSIONS, DETAILS, ETC ARE REQUESTED WHERE INDICATED. IF EACH VERIFICATION IS NOT NOTED OTHERWISE, IT WILL BE ASSUMED TO BE CORRECT AS SHOWN.

AS BUILTS

QUALITY CERTIFICATION

PRINTS	NO.	DATE
SHOP		
FIELD		
GEN CONT		
PRJ MGR		
Q A		
1st APPR		
SHOP PRELIM		
EREC PRELIM		
Q C PRELIM		
ENGR.		
PURCH.		

REV.	DATE	DESCRIPTION
0	7/10	For FAB

THIS PROJECT SHALL BE ERECTED PER THE AISC THIRTEENTH EDITION CODE OF STANDARD PRACTICE SPECIFICALLY PARAGRAPH 7.14 AS FOLLOWS:

7.14 CORRECTION OF ERRORS
The correction of minor misfits by moderate amounts of reaming, grinding, welding or cutting, and the drawing of elements into line with drift pins. shall be considered to be normal erection operations. Errors that cannot be corrected using the foregoing means, or that require major changes in the member or Connection configuration, shall be promptly reported to the Owner's Designated Representatives for Design and Construction and the Fabricator by the Erector to enable the responsible entity to either correct the error or approve the most efficient and economical method of correction to be used by others.

No Backcharges Wil Be Accepted Unless Approved In Writing By Steel Structures, Inc

REFERENCE DRWG. / LOCATION: **E2**
MATERIAL (UNLESS NOTED): **A36**
SURFACE PREPARATION:
SHOP PAINT: **SHOP PRIMER U.N.**
SHOP CONNECTIONS/ELECTRODES: **E70XX**
FIELD CONNECTIONS:
HOLES (U.N.): 13/16"Ø U.N.

STEEL STRUCTURES, INC.
5980 So. Proycon Ave. – Las Vegas, Nevada
(702)736-7033

JOB: CITY OF LAS VEGAS MUSIUM
LOCATION: Las Vegas, Nevada
CUSTOMER: APCO
DRWG. COVERS: PLATE
DETAILER: YS DATE: 6/10
CHECKER: SS DATE: 6/10
PROJECT MANAGER: SSI

JOB NO. 1014
DRWG. NO. 19