
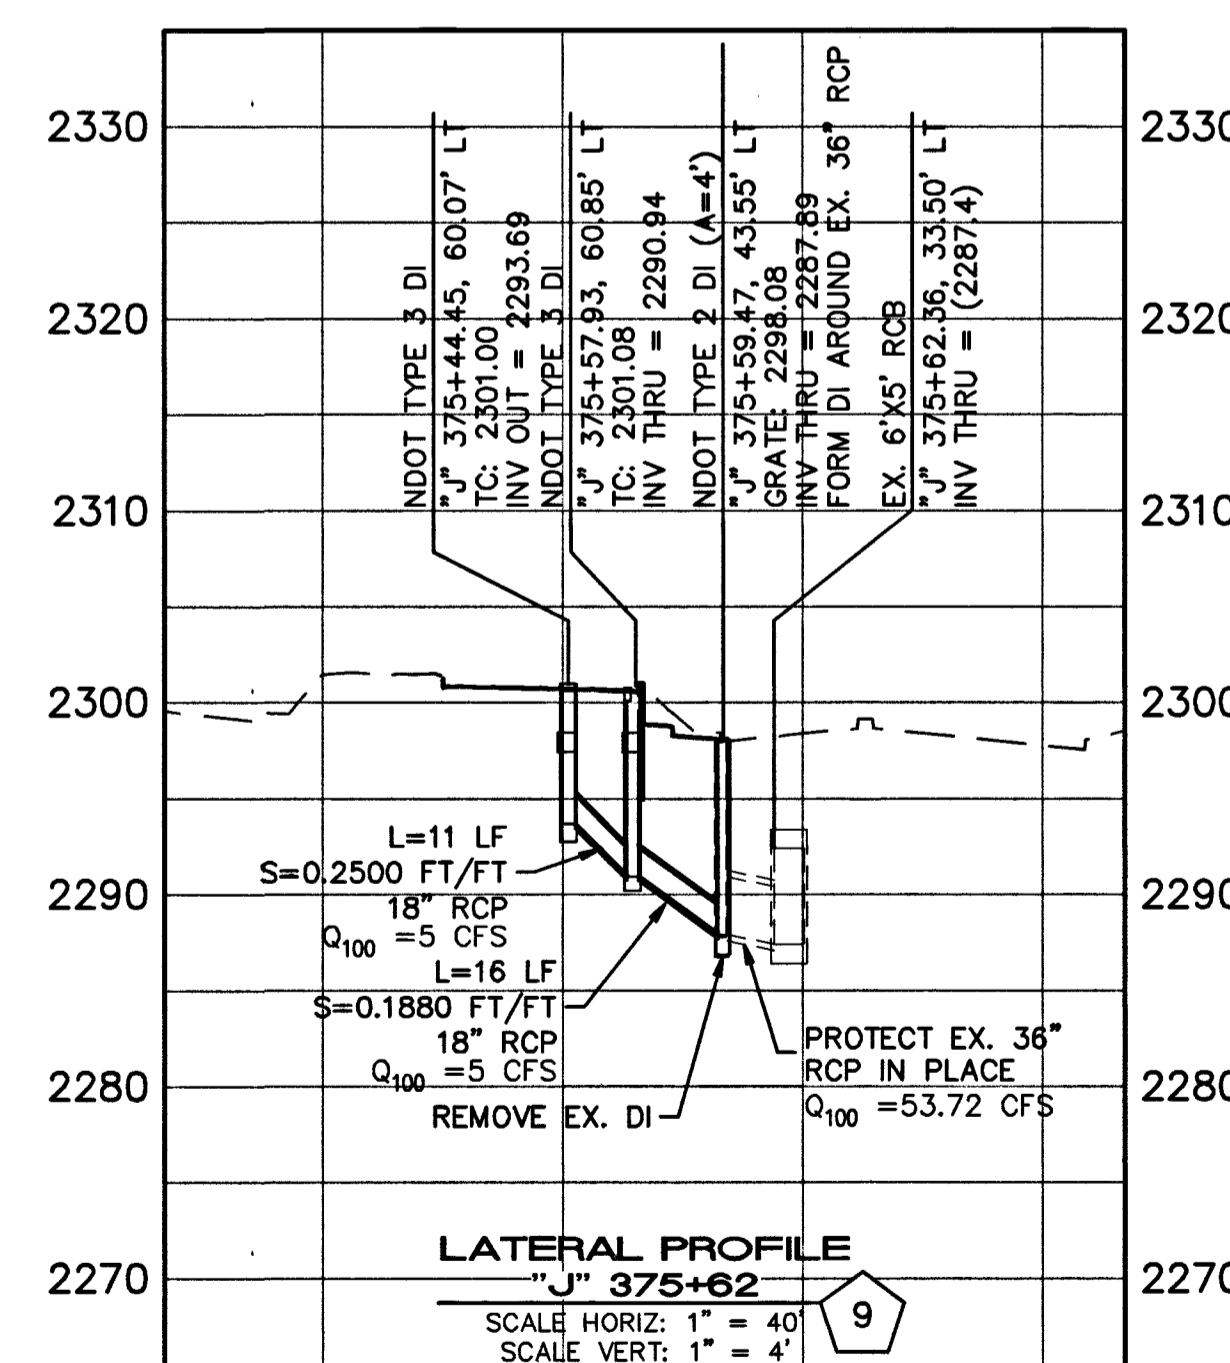
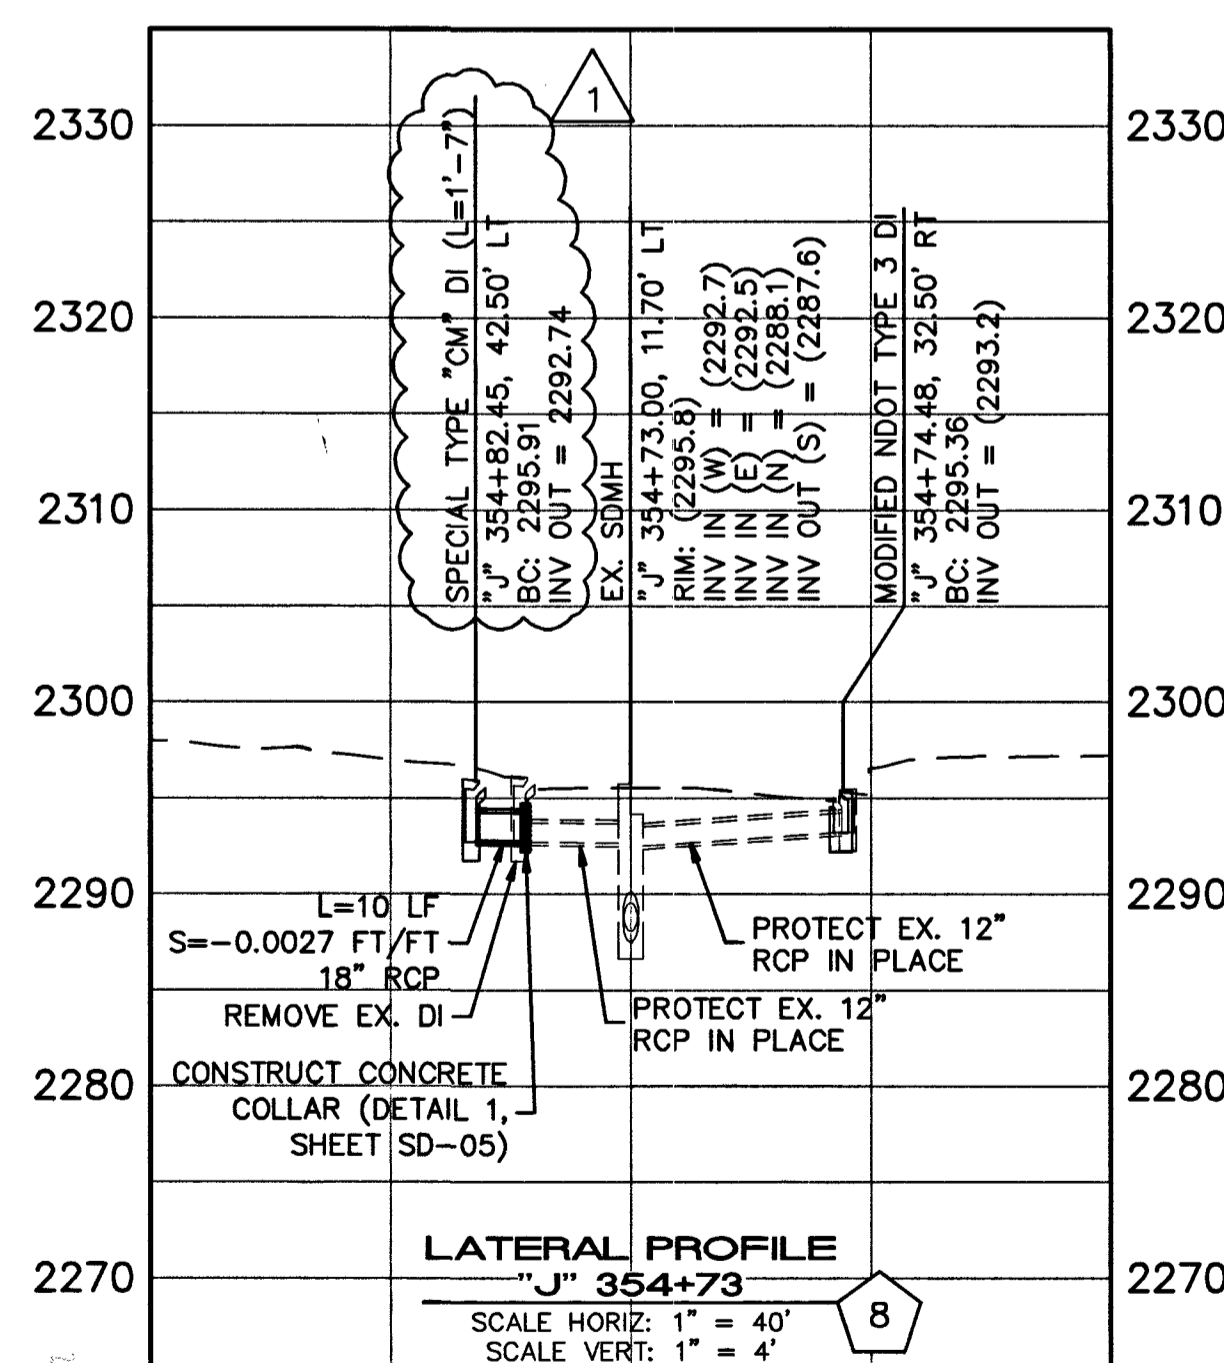




- STORM DRAIN NOTES:**
1. ALL PIPE LENGTHS MEASURED ALONG PIPE CENTERLINE TO CENTER OF MANHOLE OR GRADE BREAK OR TO INSIDE EDGE OF DI, RCB, OR STRUCTURE.
 2. ALL DROP INLETS SHALL INCLUDE STORM WATER MANAGEMENT STAMP AND DETAIL PER USDOCA STD. DWG. NO. 421).
 3. ALL STORM DRAIN SHALL BE CLASS III UNLESS OTHERWISE NOTED.

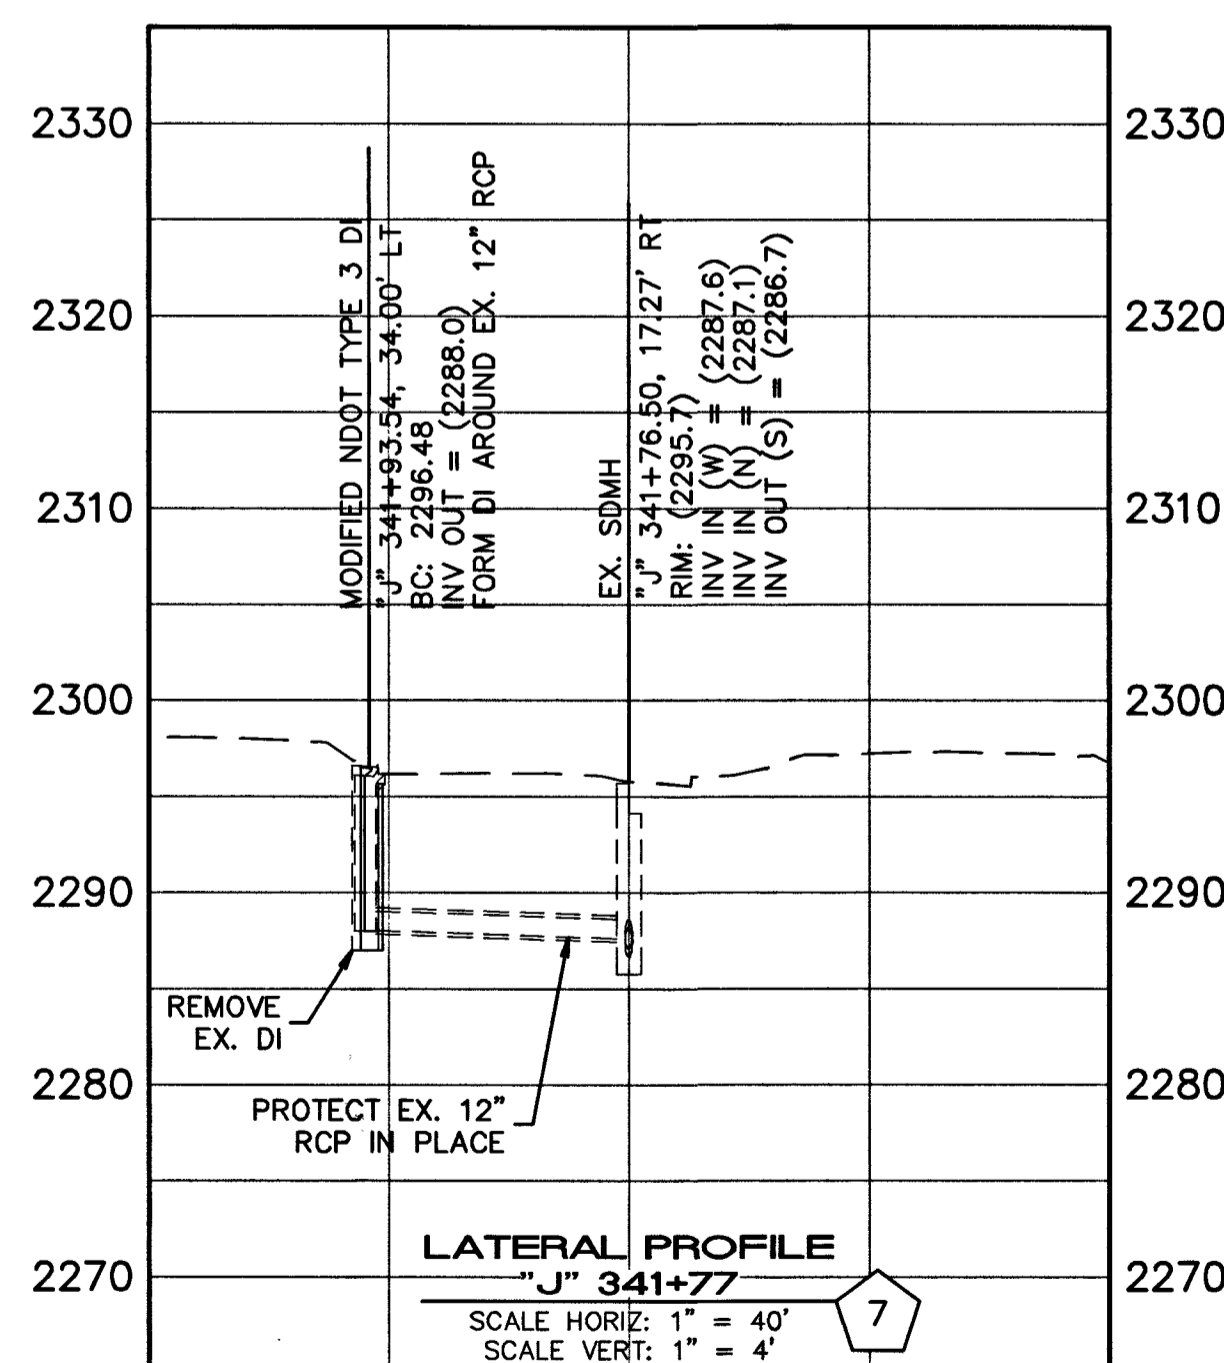

FAST
Call before you UnderGround.
1-702-432-5300

AVOID HITTING OVERHEAD POWER LINES. IT'S COSTLY.
CALL BEFORE YOU DO OVERHEAD.
1-702-227-2929

Call before you Dig
Avoid cutting underground utility lines. It's costly.
Call
1-800-227-2800

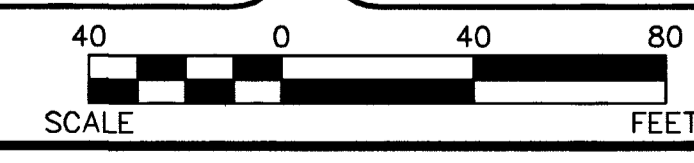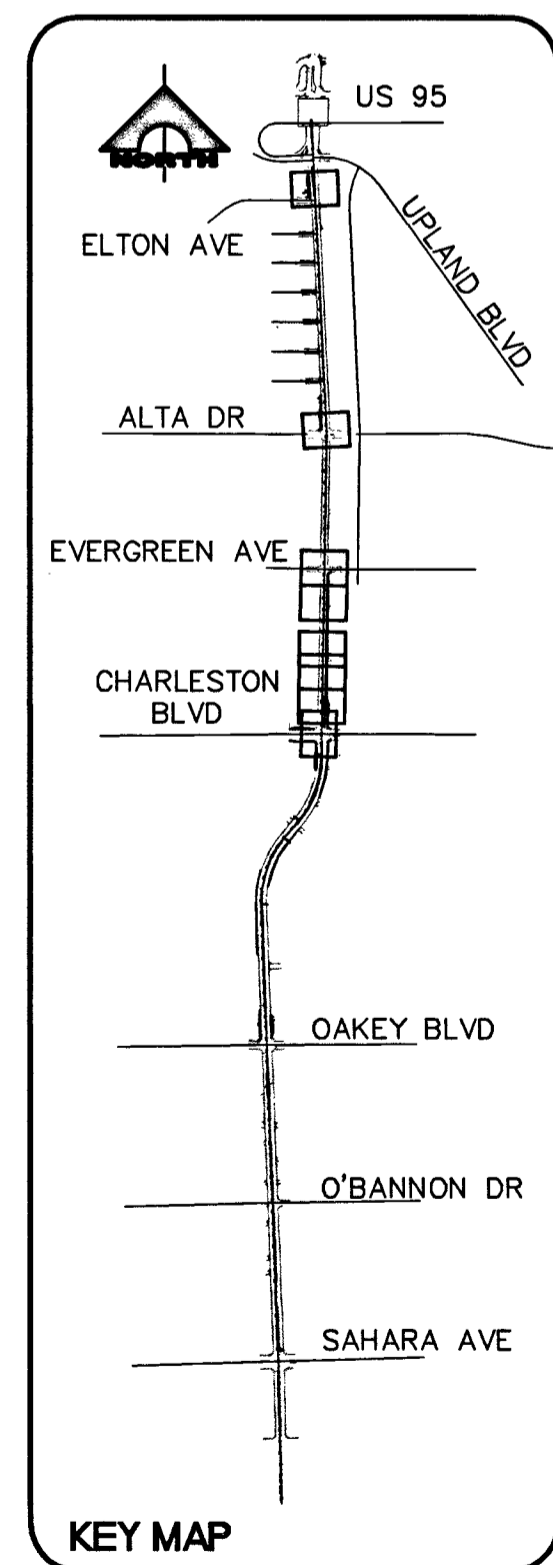


REVISIONS

NO.	DATE	DESCRIPTION	APP'D
1	12/21/11	REVISE DROP INLET GRATE SIZE	

DEPARTMENT OF PUBLIC WORKS
CAPITAL PROJECT MANAGEMENT
CITY ENGINEER: DAVID BOWERS, P.E., P.TOE
PROGRAM MANAGER: JEREMY LEAVITT, P.E.
DESIGNED BY: MDM
DRAWN BY: JAS
CHECKED BY: TAM
DATE: 9/21/11

JONES BOULEVARD IMPROVEMENTS
SAHARA AVENUE TO US 95
STORM DRAIN LATERALS III

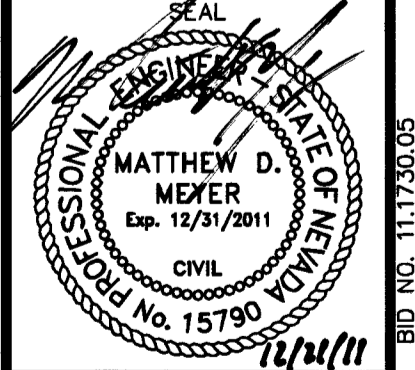

Sheet
SD-03
59 of 101
DRAWING NO.
107V5627