


LEGEND

1	INSTALL B-36 PULL BOX (24"x36"x24")
2	EXISTING B-36 PULL BOX (24"x36"x24")
3	INSTALL B-50 PULL BOX (13"x24"x24")
4	EXISTING B-50 PULL BOX (13"x24"x24")
5	INSTALL B-100 PULL BOX (24"x36"x24")
6	EXISTING B-100 PULL BOX (24"x36"x24")
7	INSTALL T-200 CATV VAULT (30"x48"x36")
8	EXISTING T-200 CATV VAULT (30"x48"x36")
9	INSTALL T-400 CATV VAULT (36"x60"x36")
10	EXISTING T-400 CATV VAULT (36"x60"x36")
11	INSTALL T-600 CATV VAULT (48"x72"x36")
12	EXISTING T-600 CATV VAULT (48"x72"x36")
13	INSTALL NEW CATV PEDESTAL
14	EXISTING NEW CATV PEDESTAL
15	R&R S/W SLAB(S)
16	POTHOLE
17	—c—c—c— SIDEWALK/DIRT TRENCH INSTALL
18	—c—c—c— ASPHALT/STREET TRENCH INSTALL
19	—b—b—b— PROPOSED BORE
20	—x—x—x— EXISTING CATV CONDUIT(S)
21	—ohc— PROPOSED OVERHEAD FIBER OPTIC CABLE OR COAX INSTALL
22	—xohc— EXISTING OVERHEAD FIBER OPTIC CABLE OR COAX
23	— — — U.G. FIBER/COAX PULL
24	— — — RIGHT OF WAY LINE
25	— — — LOT/PROPERTY LINE
26 EDGE OF PAVEMENT
27	P EXISTING NVE PULL BOX
28	T EXISTING TELCO PULL BOX
29	TM EXISTING TELCO MANHOLE
30	T EXISTING TELCO POLE
31	● EXISTING NVE POLE
32	NVE EXISTING NVE TRANSMISSION POLE
33	⊗ EXISTING JOINT POLE
34	⊗ EXISTING JOINT POLE WITH TRANSFORMER
35	⊕ POLE ANCHOR
36	⊕ EXISTING NVE TRANSFORMER TRANSFORMER PAD
37	TS SNWA TEST STATION
38	⊕ COX POWER SUPPLY (49"x24"x52")
39	RQ INSTALL RHINO CABINET
40	⊕ RISER POLE/QUADRANT DETAIL RISER OWNERSHIP NOTED
41	++++ RAILROAD
42	MH EXISTING MANHOLE (SS),(SD)...ECT
43	--- 1in CONDUIT LATERAL
44	
45	

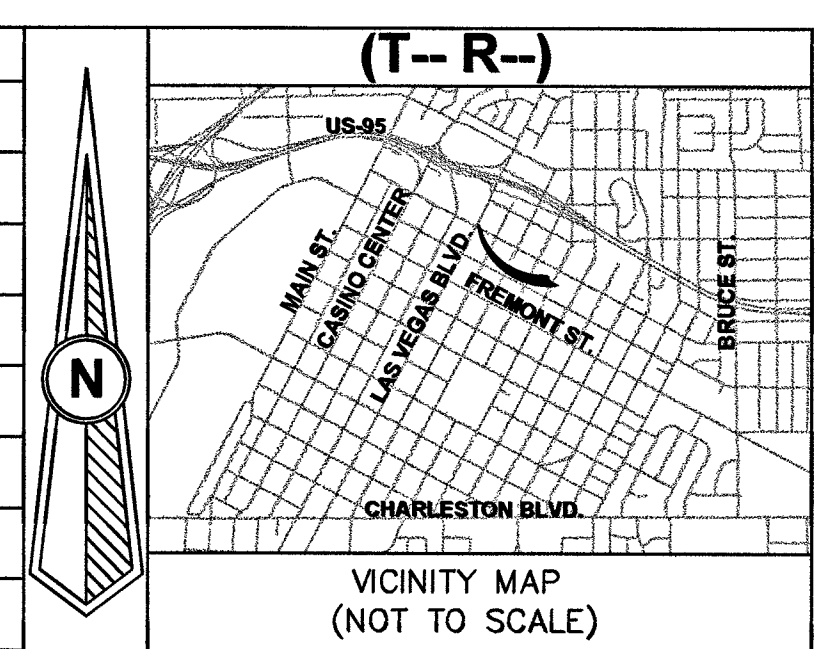

REVISIONS

REV	DESCRIPTION	DATE	BY
1	CHANGED BORE TO A TRENCH	8/16/17	CMR
2		8/22/17	PIK

ALL CONSTRUCTION AND MATERIALS SHALL BE IN ACCORDANCE WITH THE "UNIFORM STANDARD SPECIFICATIONS FOR PUBLIC WORKS CONSTRUCTION OFF-SITE IMPROVEMENTS, CLARK COUNTY AREA NEVADA" LATEST ISSUE; THE "UNIFORM STANDARD DRAWINGS FOR PUBLIC WORKS CONSTRUCTION, CLARK COUNTY AREA NEVADA" LATEST ISSUE; AND OTHER APPLICABLE APPROVED STANDARDS ISSUED BY THE CONTROLLING AGENCY; ALL LOCAL CITY CODES AND ORDINANCES APPLICABLE.

APPROVED FOR CONSTRUCTION

THIS APPROVAL IS FOR WORK IN CLV RW OR CLV EASEMENT ONLY. OBTAINING PERMISSION OR EASEMENT FOR WORK SHOWN IN PRIVATE PROPERTY IS THE RESPONSIBILITY OF THE UTILITY.

APPROVAL: *[Signature]* DATE: 8/22/17

PERMIT #	124603
DRAWN BY:	L17-00090
DATE:	6/29/17
SCALE:	5-12-17
1:20	
NODE:	124603
DESIGNER:	40520160000124603
TECH #	702-209-8447
APPROVED BY:	DAVID REYNOLDS

1700 VEGAS DRIVE
LAS VEGAS, NEVADA 89106
PHONE: (702) 545-1606
FAX: (702) 545-2808

DISCLAIMER NOTE

UTILITY LOCATIONS SHOWN HEREON ARE APPROXIMATE ONLY. IT SHALL BE THE CONTRACTOR'S RESPONSIBILITY TO DETERMINE THE EXACT HORIZONTAL AND VERTICAL LOCATION OF ALL EXISTING UNDERGROUND AND OVERHEAD UTILITIES PRIOR TO COMMENCING CONSTRUCTION. NO REPRESENTATION IS MADE THAT ALL EXISTING UTILITIES ARE SHOWN HEREON. THE ENGINEER ASSUMES NO RESPONSIBILITY FOR UTILITIES NOT SHOWN OR UTILITIES NOT SHOWN IN THEIR PROPER LOCATIONS.

AVOID CUTTING UNDERGROUND UTILITY LINES. IT'S COSTLY. CALL 811 BEFORE YOU DIG OR 1-800-227-2800 UNDERGROUND SERVICE (USA)

AVOID OVERHEAD POWER LINE CONTACT. CALL BEFORE YOU OVERHEAD. 1-702-227-2829 NEVADA POWER ENVIRONMENT AND SAFETY SERVICE DEPARTMENT

BEFORE YOU UNDERGROUND: 1-702-455-7511 CLARK COUNTY TRAFFIC OPERATIONS AND 1-702-422-6300 LAS VEGAS AREA COMPUTERIZED SYSTEMS

TOTAL BORE	70'
TOTAL DIRT TRENCH	35'
TOTAL ASPHALT TRENCH	0'
TOTAL TRENCH	35'
SIDEWALK REMOVAL/REPAIR	
TOTAL S/W PANELS	2
TOTAL LINEAR FOOTAGE	10'

CITY/UTILITY: CITY OF LAS VEGAS

PROJECT LOCATION: N LAS VEGAS BLVD & STEWART AVE

333 N. RANCHO DRIVE
LAS VEGAS, NEVADA 89106
(702) 229-6885

SUB-CONTRACTOR: CLOVER

ENTITY NOTES:

SHEET No: **1**

SHEET 1 OF 1

8/16/17

L17-00090-R001

TrueNet# 11020