

# NEONOPOLIS

@ THE FREMONT STREET EXPERIENCE

| No. | Date | Item |
|-----|------|------|
| 1   |      |      |
| 2   |      |      |
i.d.b.


## RTKL

RTKL Nevada Corp.  
333 South Hope Street, C-200  
Los Angeles, CA 90071  
(213) 627-7373 FAX: (213) 627-9815  
© 1999 RTKL Nevada Corp.

STAIR SECTIONS


|         |                   |    |
|---------|-------------------|----|
| Project | 40-98046.00       | 34 |
| Scale   | 1/4" = 1'-0"      | 17 |
| Date    | NOVEMBER 26, 1999 |    |
| Issue   |                   |    |

107-V 3037-A

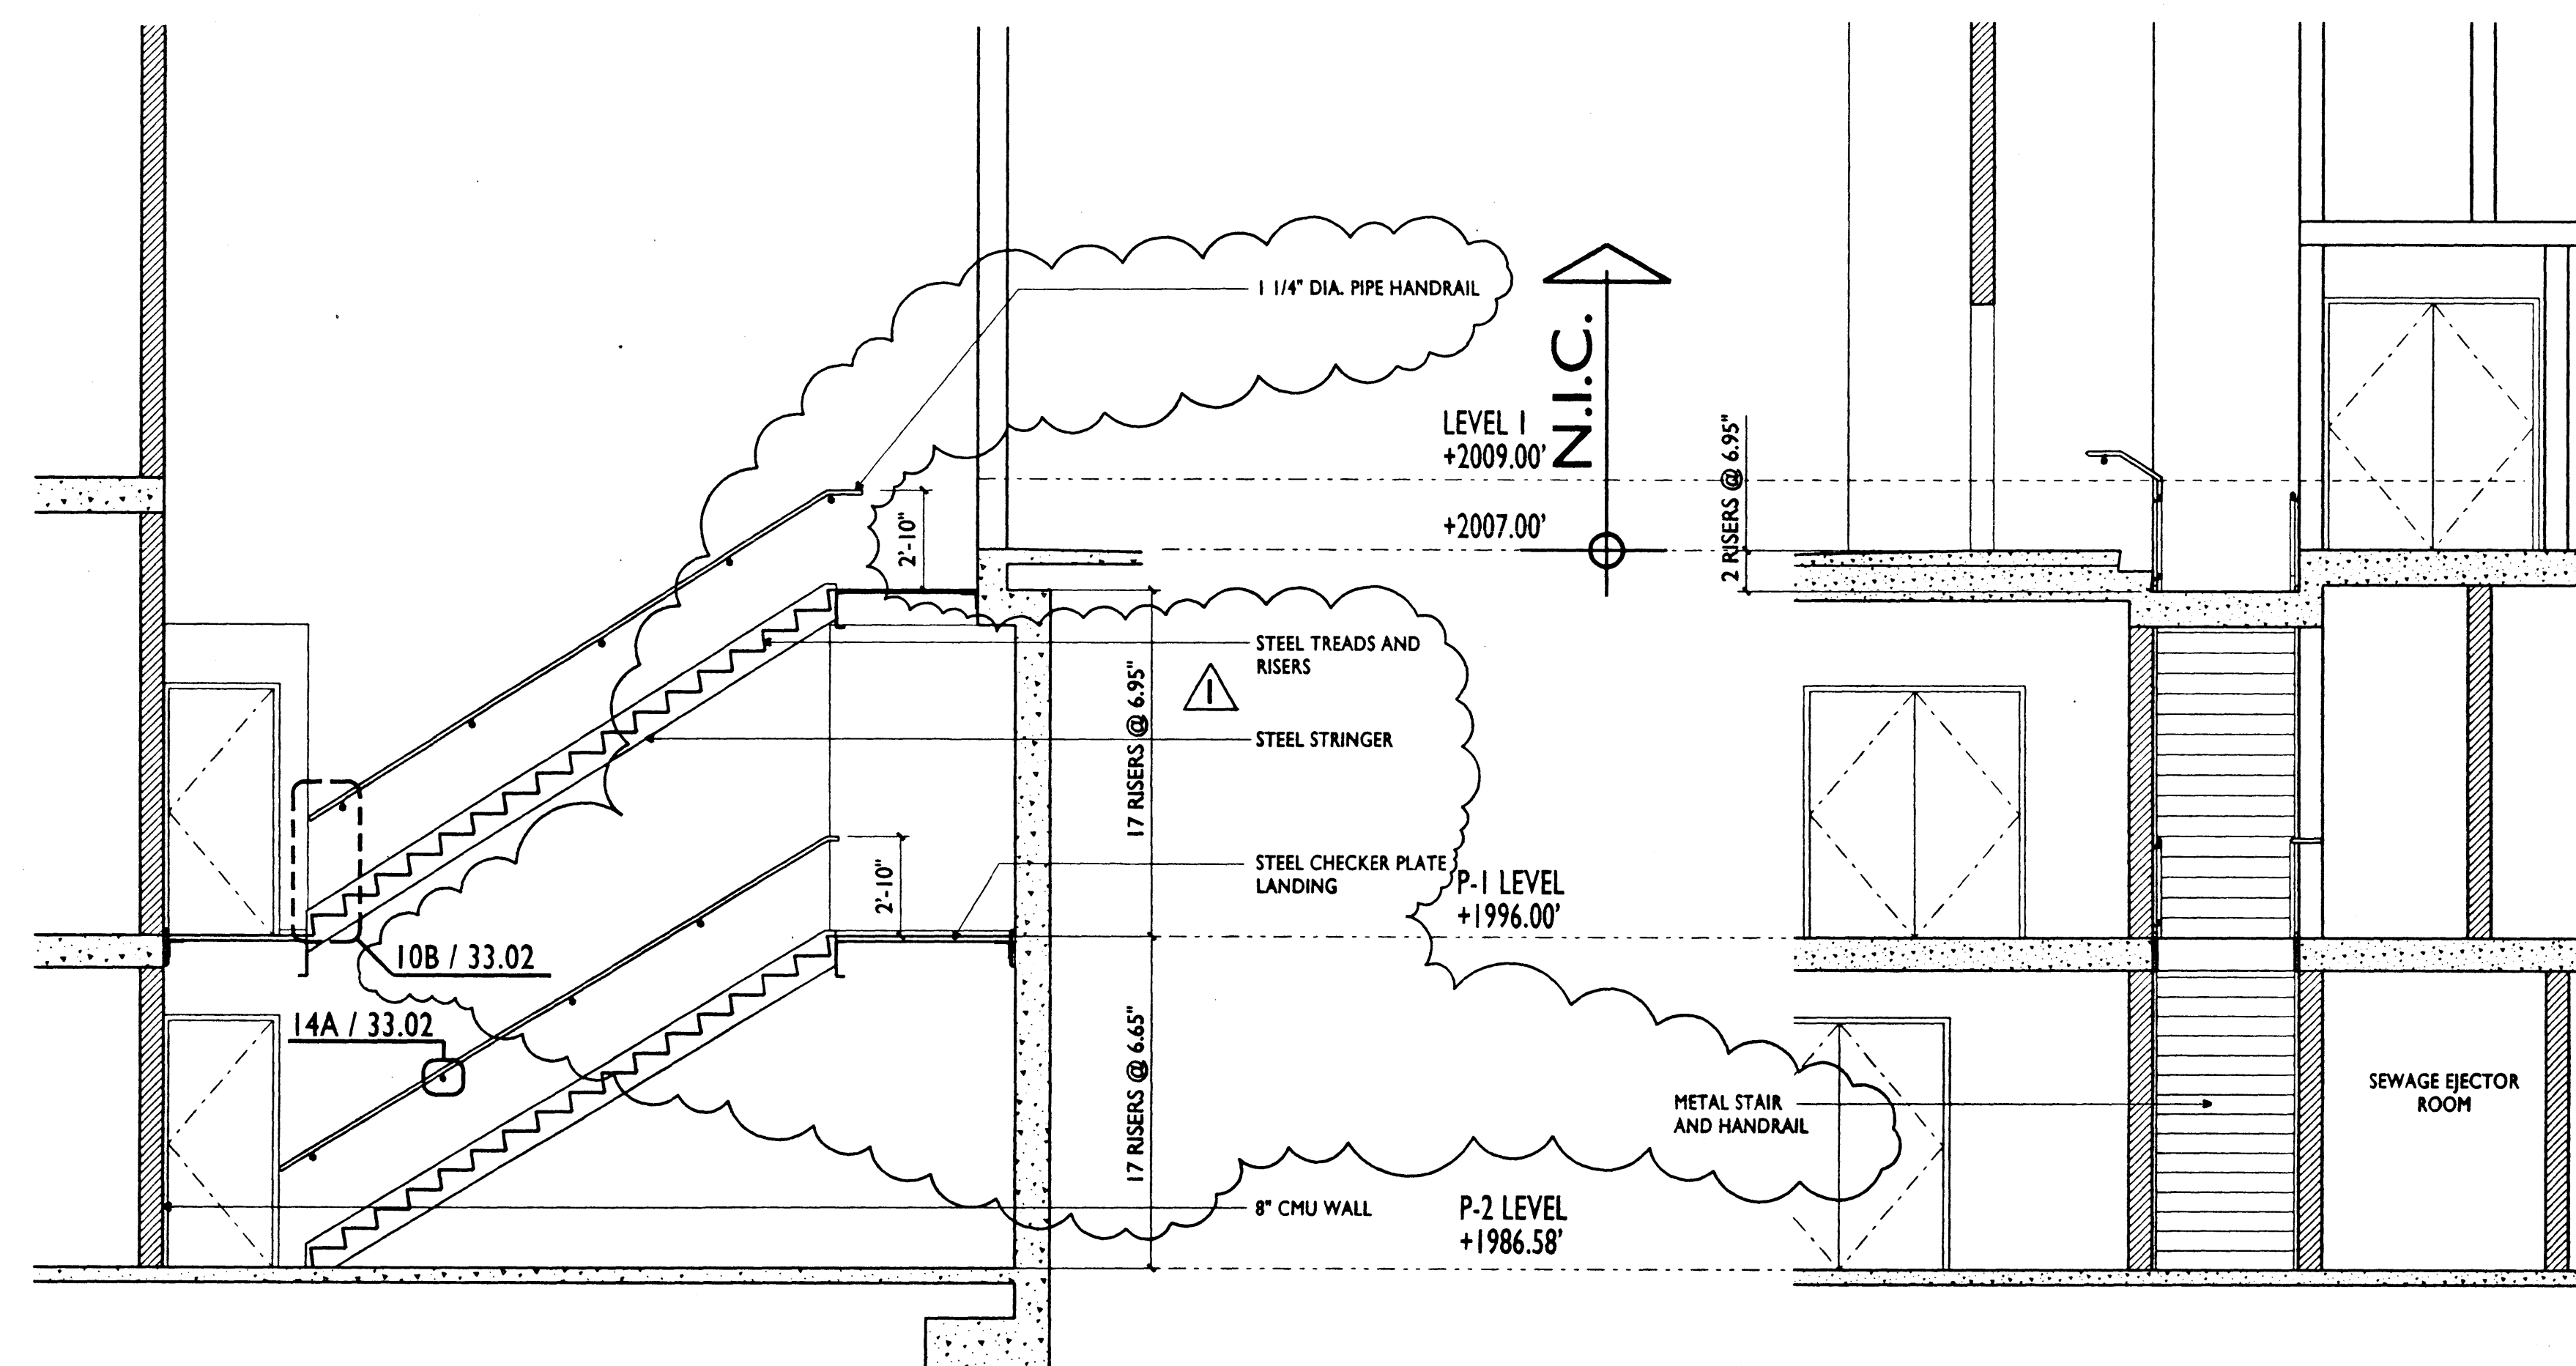

13B STAIR #4 SECTION  
SCALE: 1/4" = 1'-0"

21844

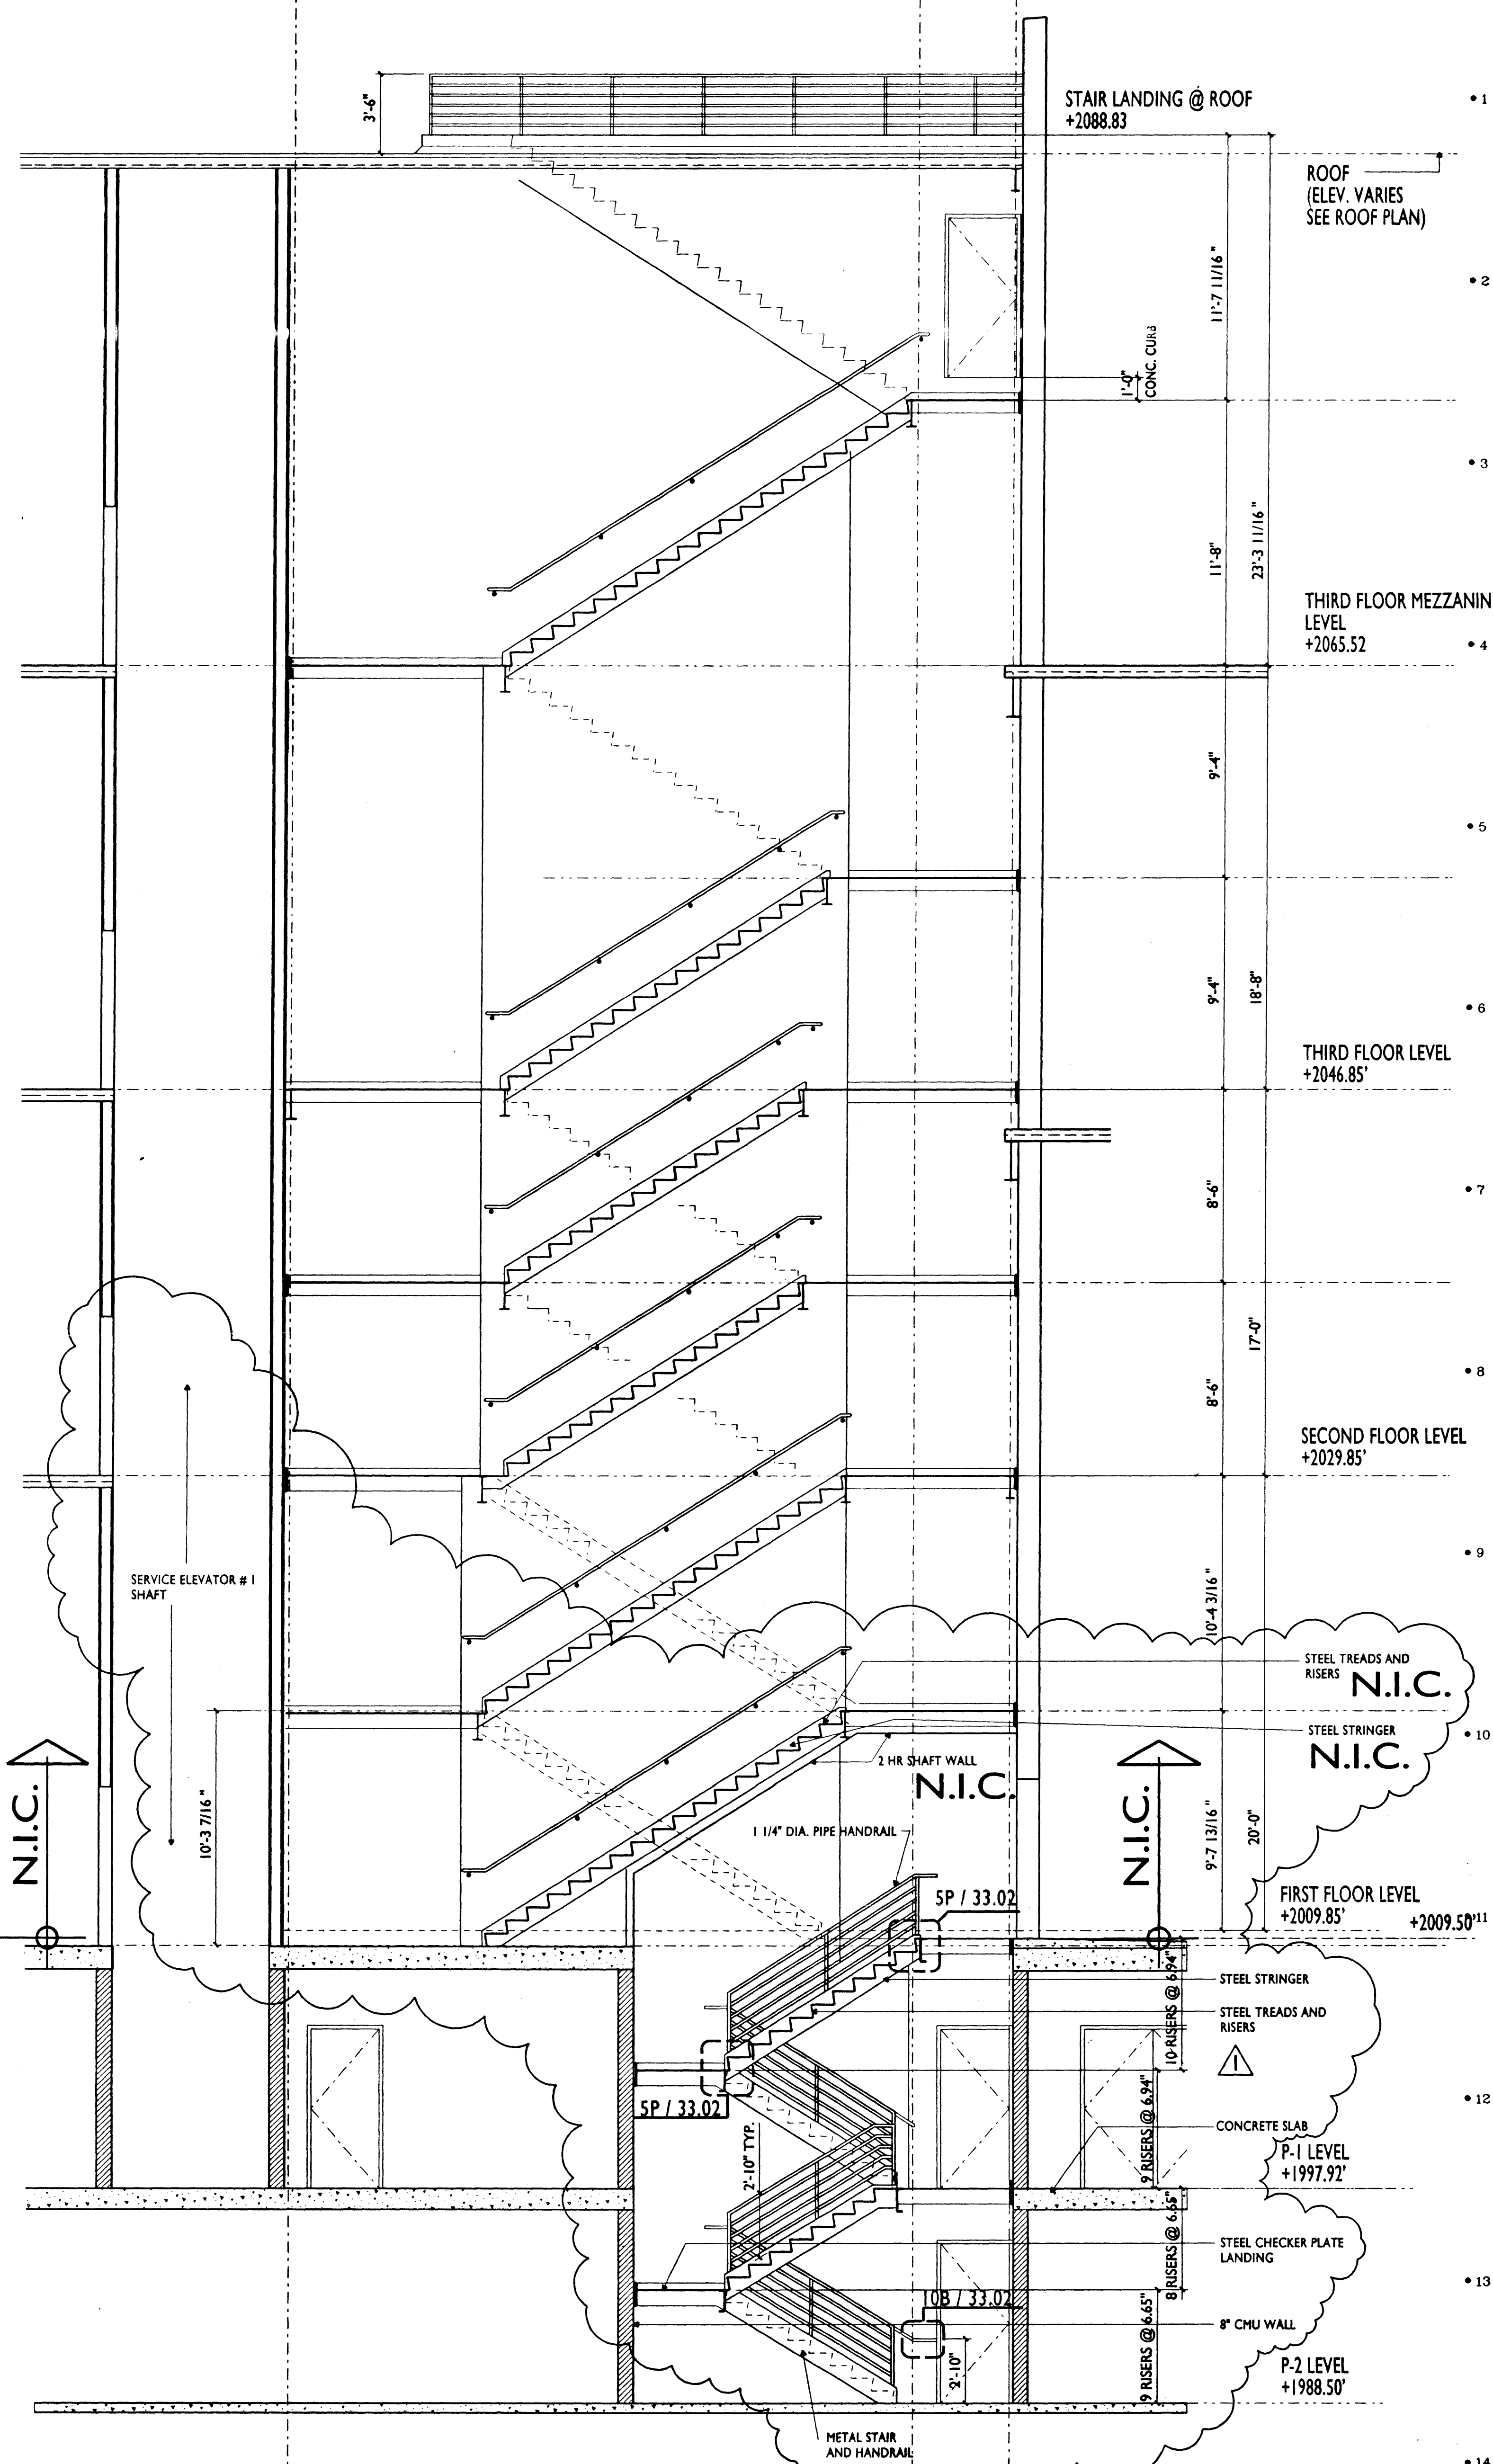

13M STAIR #2 SECTION  
SCALE: 1/4" = 1'-0"

13H STAIR #4 SECTION  
SCALE: 1/4" = 1'-0"