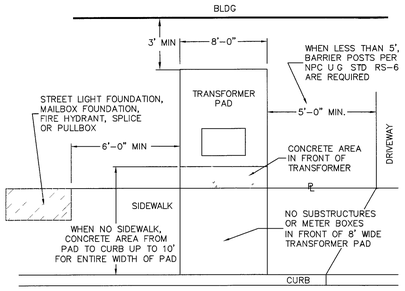

COMMERCIAL TRANSFORMER LOCATION DETAIL

NPC U G STD RS-5

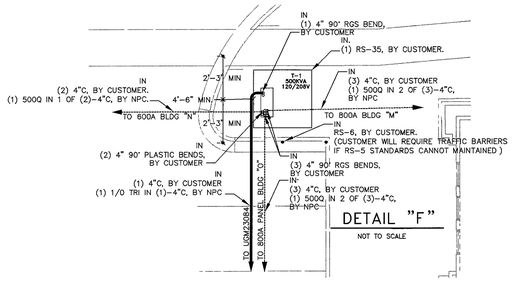

DETAIL "F"

NOT TO SCALE

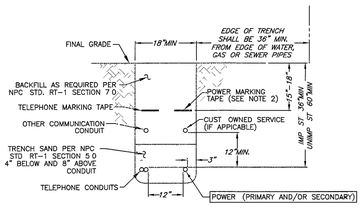

TRENCH DETAIL

NPC U G STD RT-12 (REV 4/8/02)
(RESIDENTIAL AND COMMERCIAL)

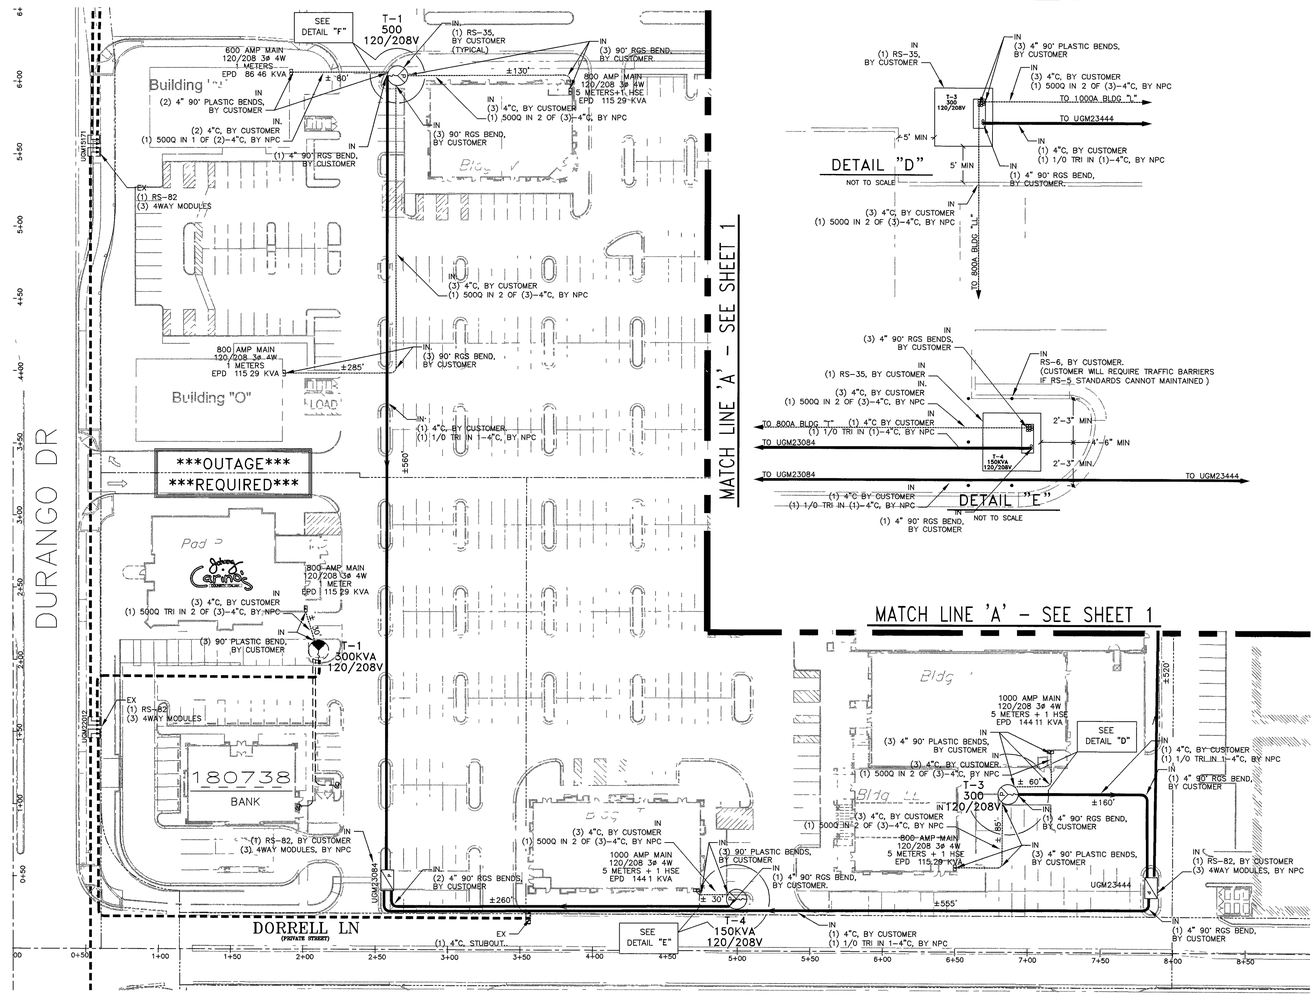

DETAIL "D"

NOT TO SCALE

DETAIL "E"

NOT TO SCALE

N

T,R,S: 1960-20

APN: 125-20-510-008

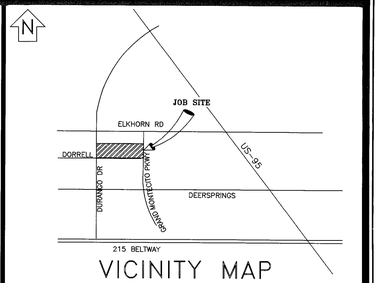

VICINITY MAP

(NOT TO SCALE)

EVERY EFFORT HAS BEEN MADE TO IDENTIFY ALL NPC FACILITIES. THE CUSTOMER SHALL CONFIRM THE EXISTENCE AND LOCATION OF THESE FACILITIES.

AVOID HITTING OVERHEAD POWER LINES IT'S COSTLY

CALL BEFORE YOU DO OVERHEAD

CALL 1-702-227-2929

AVOID CUTTING UNDERGROUND UTILITY LINES IT'S COSTLY

Call before you Dig.

1-800-227-2600
UNDERGROUND SERVICE (USA)

REVISIONS

NO.	DESCRIPTION	DATE	G.A.
1	RELOCATE FC1 AND CHANGE QUANTITY OF METERS ON BUILDINGS	07/05/2006	
2	INSTALL 4"C, STUBOUT FOR BUILDING "S" PAGE 1 OF (2) - LCM	08/14/2006	
3	INSTALL (1) RS-82 FOR FUTURE DEVELOPMENT OF BUILDING "U" PAGE 1 OF 2 -LCM	08/25/2006	

TYPE OF EASEMENT:

- AERIAL
- STANDARD
- R/W-31
- UNDERGROUND
- AS BUILT UNDERGROUND
- R O E /R/W-5-COM
- 3rd PARTY
- UNDERGROUND BY EXHIBIT
- (N-DOT) PERMIT
- (BLM) PERMIT
- RAILROAD-UPRR-PERMIT
- SO NEVADA WATER PERMIT
- NOT REQUIRED
- Misc Info

JPA NOTES:

SPRINT CONTACT: N/A
PHONE NUMBER: N/A
DATE OF CONTACT: N/A
____ TO SET NEW POLES
____ TO STAKE NEW POLES
____ TO PROVIDE ____ POLES
____ FT. CLASS ____
____ FT. CLASS ____
____ FT. CLASS ____
____ TO DIG POLE HOLES
____ TO REMOVE EX. POLES
NONE

JPA#: N/A

NPC INFORMATION:

COORDINATOR: KATHY CUNNINGHAM
PHONE: 702/657-4313
DESIGNER: LUIS C MONTOYA
DCA: N/A
INSPECTOR: 274-7051
SCHEDULING: 657-4114,657-4116,657-4118
DISTRICT: LAS VEGAS

CUSTOMER INFORMATION:

APPLICANT MONTECITO MARKETPLACE
ENGINEER: N/A
CONTACT: RICH RAIL 702/376-0527
APPROVAL DATE: 06/21/2006

GOVERNMENT INFORMATION:

AGENCY: CITY OF LAS VEGAS
APPROVAL DATE:

CITY OF LAS VEGAS PERMIT REQUIRED*

CONTACT CLV LAND DEVELOPMENT (229-6371) CLV CONSTRUCTION SERVICES MUST BE NOTIFIED 24 HOURS PRIOR TO COMMENCING CONSTRUCTION (229-6337)

*NPC INSPECTOR MUST BE NOTIFIED BY FAX 48 HOURS PRIOR TO COMMENCING CONSTRUCTION & WILL VERIFY CITY PERMIT FOR WORK DONE IN STREETS OR SIDEWALK. FAX PERMIT TO:
LAS VEGAS NORTH: 657-4354
LAS VEGAS SOUTH (HENDERSON): 558-4740
LAS VEGAS SOUTH (SPRING VALLEY): 252-4828

PURPOSE OF PROJECT:
TO PROVIDE FUTURE SERVICE TO COMMERCIAL BUILDINGS.

CONSTRUCTION OF THIS JOB IS CONTINGENT UPON THE COMPLETION OF WR# 176017, 180738,178919,_____

CIVIL LINETYPE LEGEND

	PROPOSED	EXISTING
CENTERLINE		
PROPERTY LINE/ROW		
CURB		
EDGE OF PAVEMENT		
EDGE OF SIDEWALK		
SEWER LINE *	8"S	8"S
WATER LINE *	8"W	8"W
GAS LINE *	2"G	2"G
TELEPHONE LINE *	TEL	TEL
CABLE TV LINE *	CATV	CATV
STORM DRAIN LINE *	12"SD	12"SD
FIRE HYDRANT		
STREET LIGHT		
STREET LIGHT SERVICE		

* LINETYPES UTILIZED WHERE CONFLICT OCCURS WITH NPC FACILITIES

NEVADA POWER COMPANY

MONTECITO MARKETPLACE
PHASE 2
ELKHORN & DURANGO

107V4300-2-NPC

PROJ. ID: 181301	SCALE: 1" = 50'
SHEET #: 2 OF 2	DATE: 04/14/2006

96346

3-REVISION(S)