

TRAFFIC SIGNAL SHEET NOTES

- SEE SHEET T15 FOR TRAFFIC SIGNAL GENERAL NOTES.
- EXISTING UTILITIES ARE NOT SHOWN FOR CLARITY. FOR EXISTING UTILITY INFORMATION, PLEASE REFER TO SHEETS R1 TO R18.


PULLBOX LEGEND

- A** No. 3 1/2 PULL BOX (MARKED "TRAFFIC SIGNAL")
- B** No. 5 PULL BOX (MARKED "TRAFFIC SIGNAL")
- C** No. 7 PULL BOX (MARKED "TRAFFIC SIGNAL")
- D** P-30 PULL BOX (MARKED "FIBER OPTIC")



VEHICLE DETECTION LEGEND

- 5A** INDUCTION LOOP DETECTION SYSTEM
- LOOP DETECTOR*
- LOOP DETECTOR SYSTEM PHASE
- * ALL LOOPS SHALL BE PREFORMED LOOPS PER SPECIAL PROVISIONS AND DETAILS ON SHEET T-33.

PHASE DIAGRAM

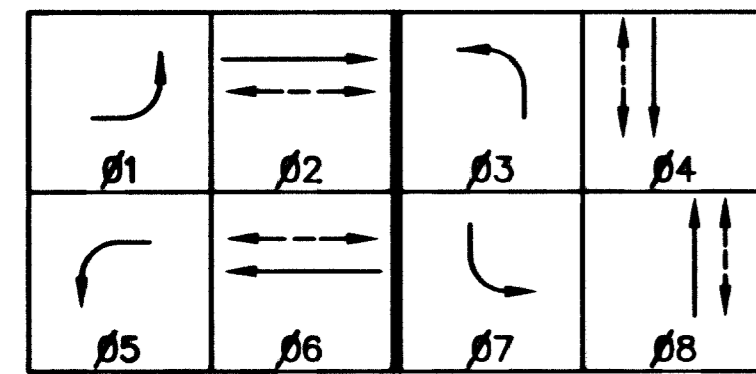

FLASHING OPERATION SHALL BE ALL RED.
OPTICOM PREEMPTION FOR PHASES 2, 4, 6, & 8.

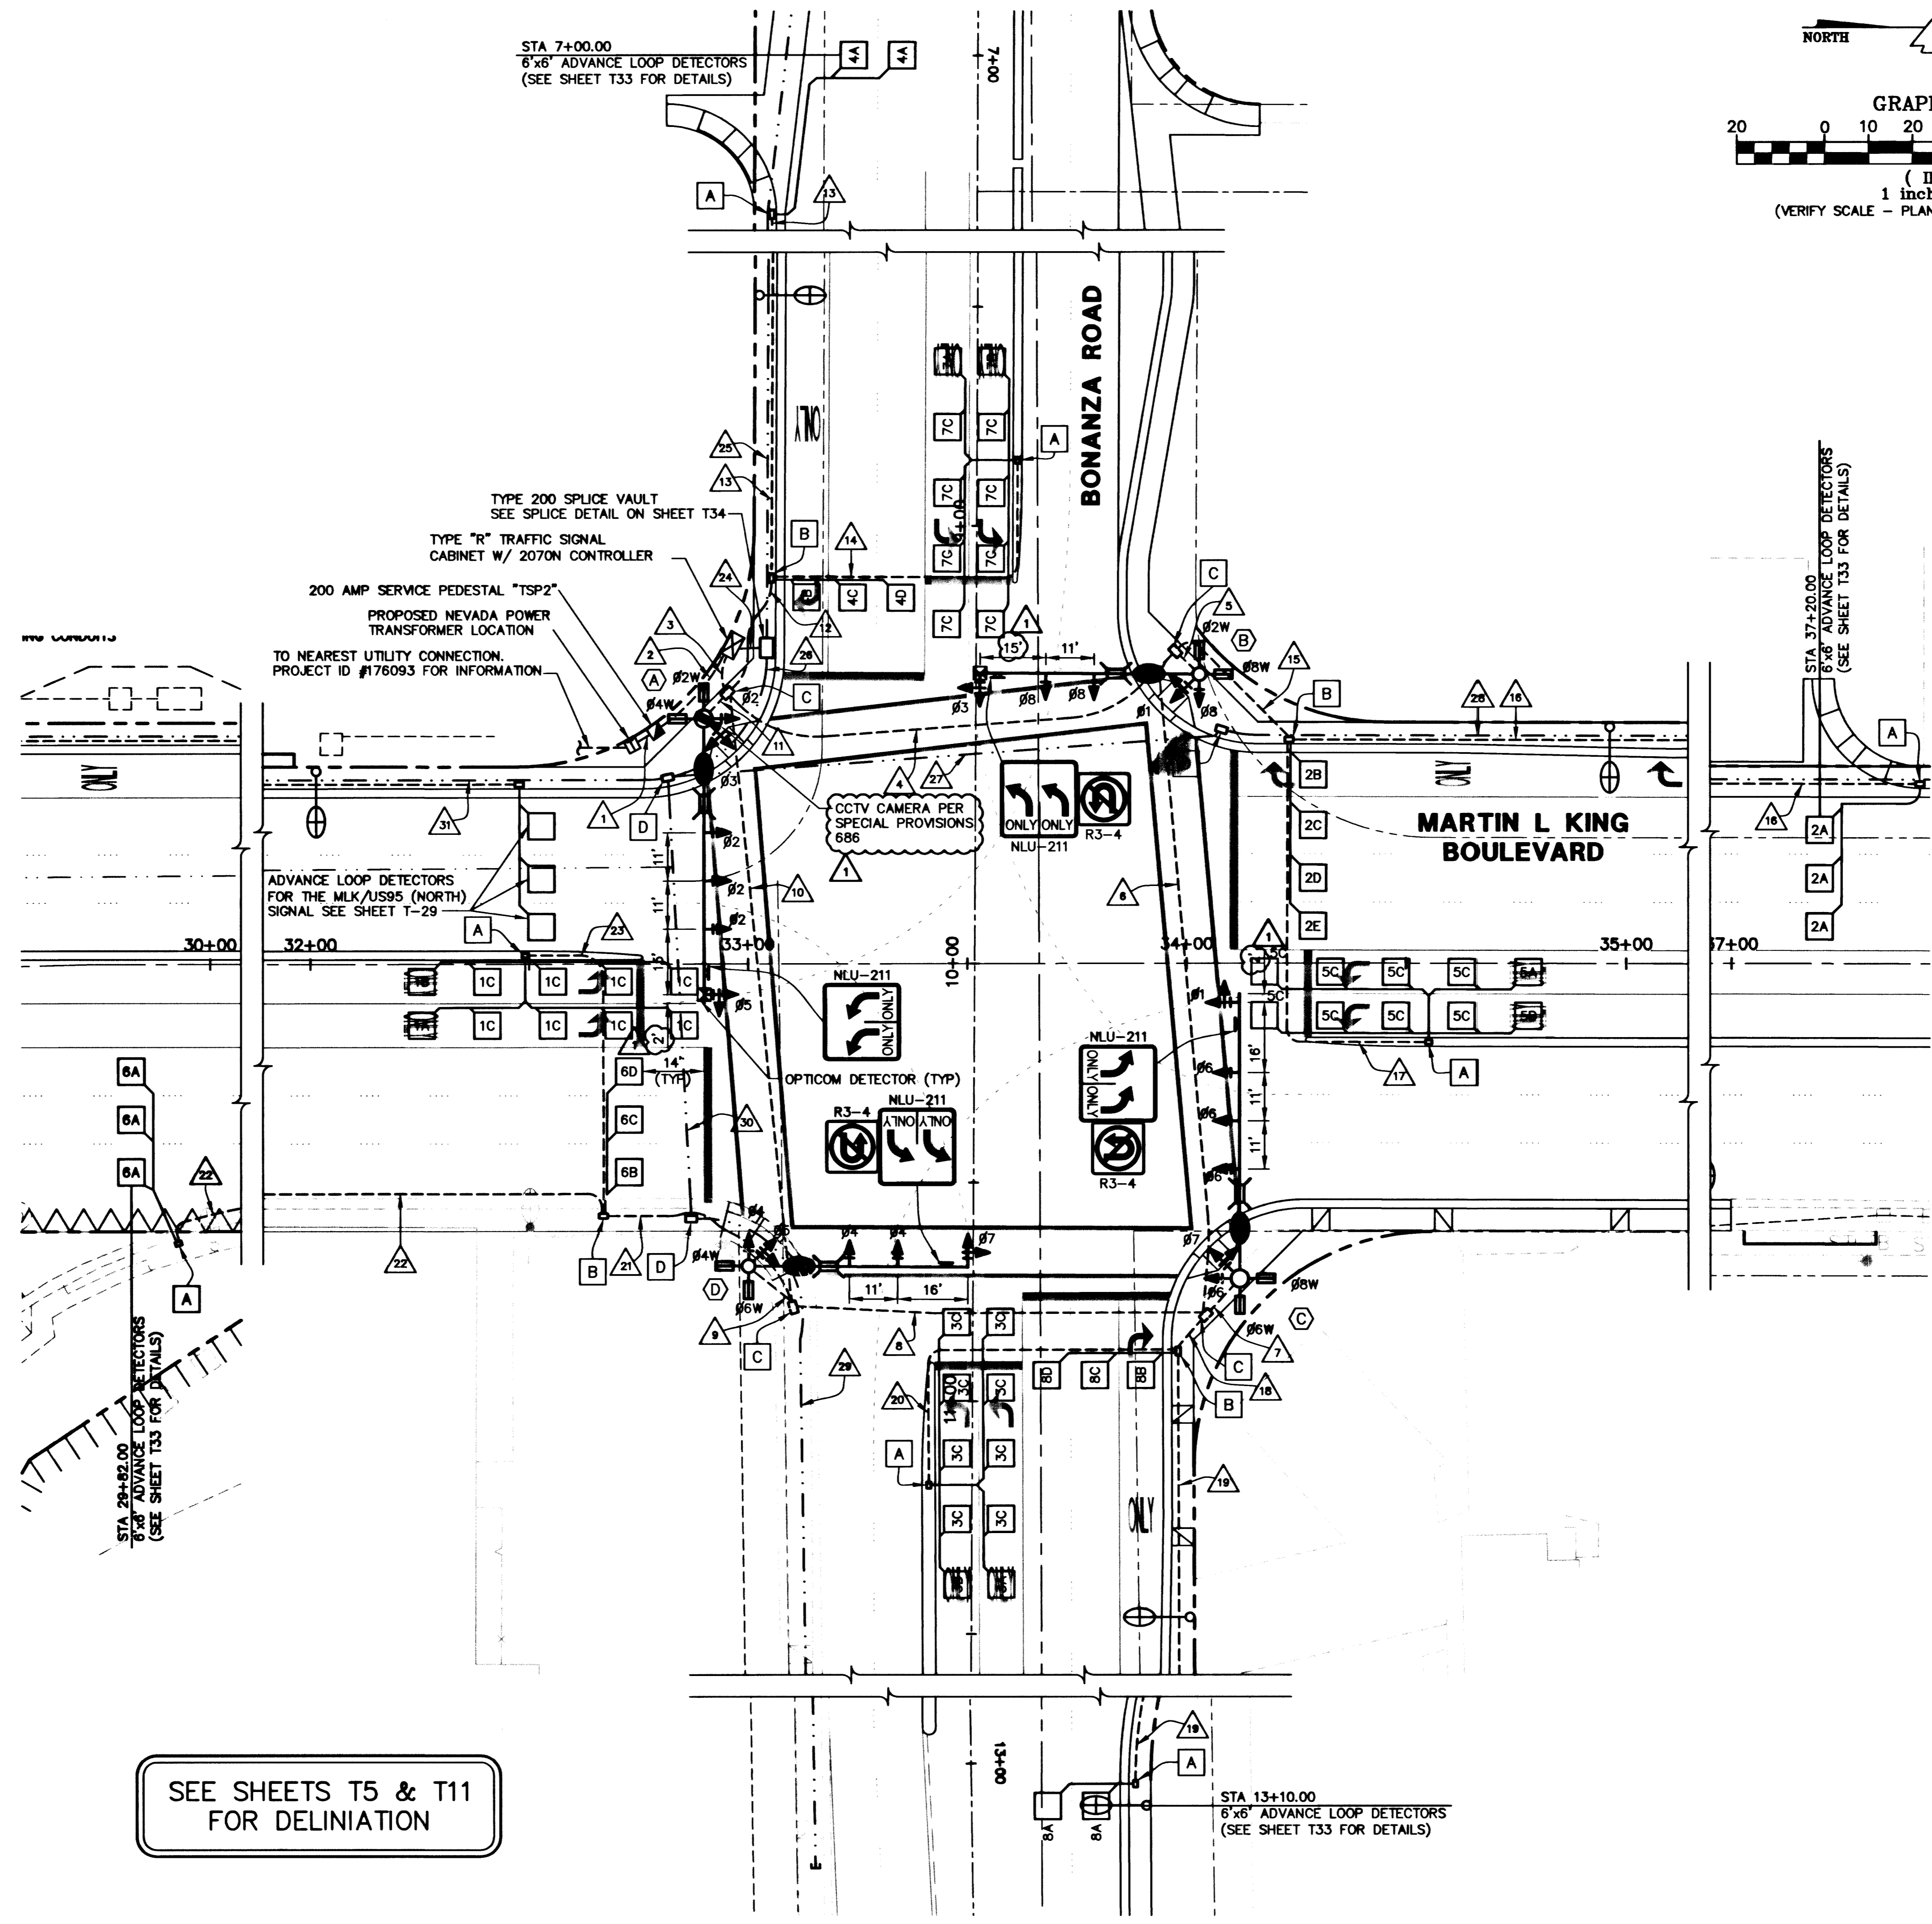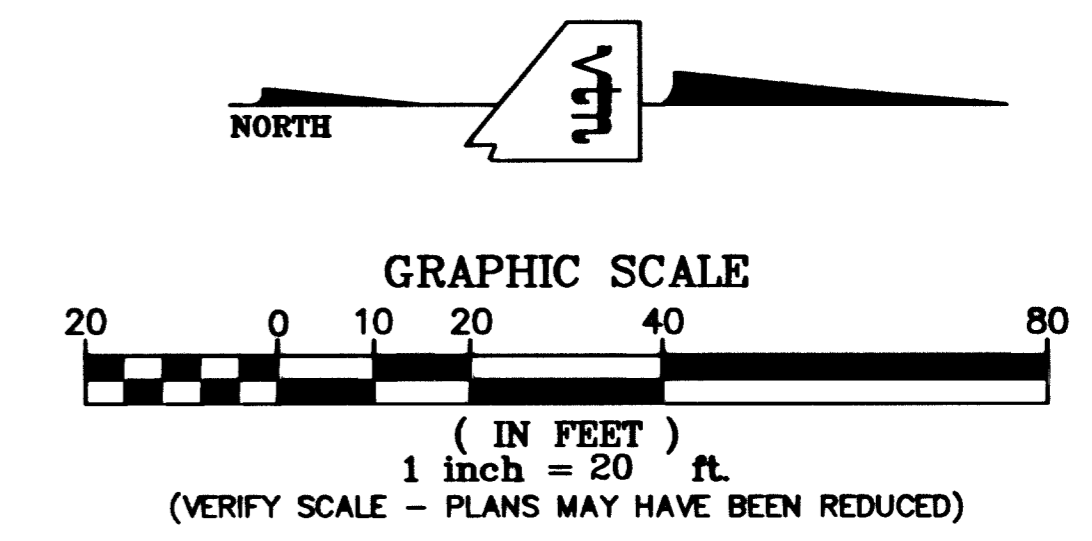

SEE SHEETS T5 & T11 FOR DELINEATION

Call before you Dig
1-800-227-2600

Call before you Overhead
1-702-227-2929

DEPARTMENT OF PUBLIC WORKS
CITY OF LAS VEGAS

CONSULTING ENGINEERS • PLANNERS • LAND SURVEYORS
2727 SOUTH RAINBOW BOULEVARD
LAS VEGAS, NEVADA 89146-5146 PHONE (702) 873-7550 FAX (702) 362-2597

REVISION
REV DATE BY
11/12/07 RCH/LMW
REV PER APPROVAL No. 4

TRAFFIC SIGNAL PLAN
MARTIN L KING BLVD & BONANZA RD

PROJECT: MARTIN L KING BLVD IMPROVEMENTS
ALTA DR TO CAREY AVE

NO. NO. 6224
DESIGNED BY RCH/LMW
DRAWN BY WBM
DATE 4/2/07
SCALE HORIZ. 1"=20'
VERT. NONE
DRAWING SHEET 14 OF SHEETS
T18R

SEAL
ROBERT HOSEA
CIVIL
12007

106768
I:\B224\Comp\Design\1224-300.dwg