



28-5-96

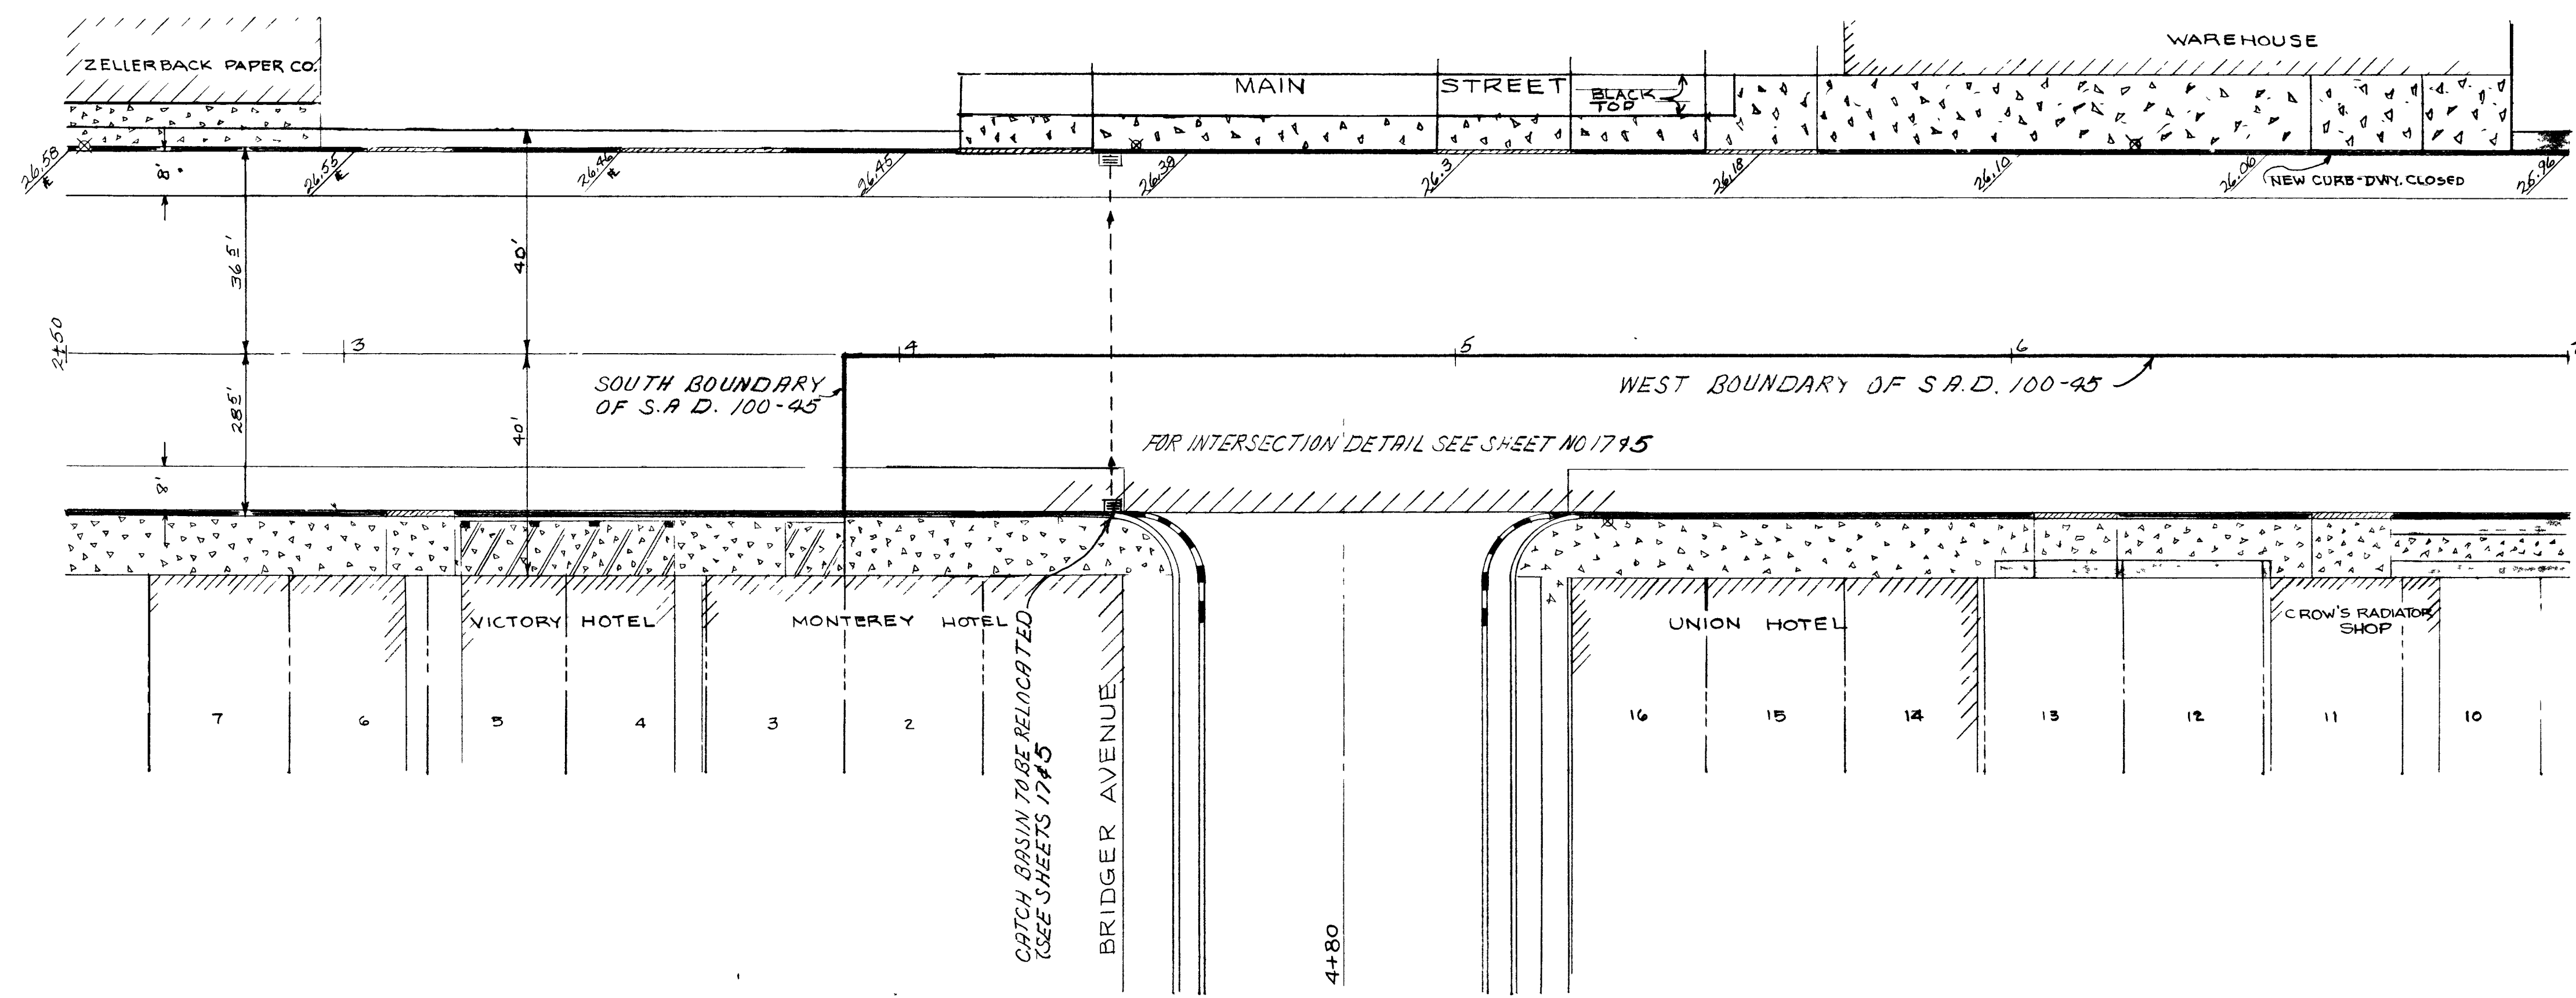

2028
2026
2024

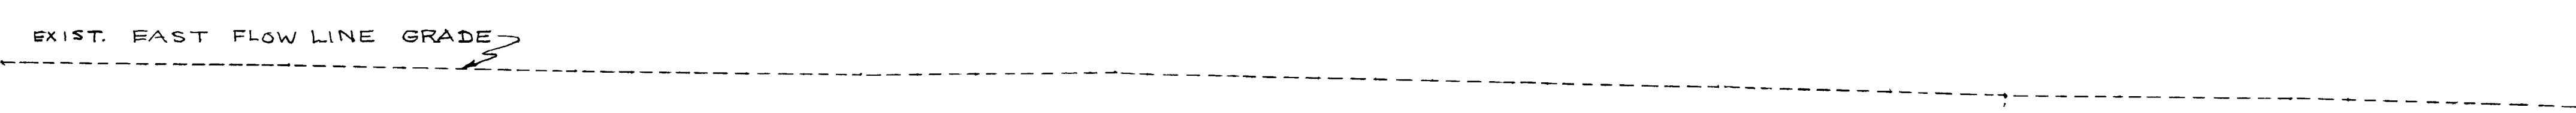

REVISED- NEW CURB CONST.
DWY CLOSED.
10-13-61 MP.

100-45

CITY OF LAS VEGAS NEVADA ENGINEERING DEPT.			
MAIN STREET STA. 2+50 TO 7+00			
DES. <i>W. Lambert</i>	DATE 3-17-61	SC. 09 1"=20'	
DIR. HARPER	11-30-60	F. BK. NO. 100-45 BK 3	
CKD.		P.I. O. NO.	
APPROVED BY CITY ENGR. <i>R. P. ...</i>		DRAWING NO.	107-16

2+50 3 4 5 6 7

SHEET 61 OF 117

2389

