



MONUMENTATION TIE MAP MIRAMONTE AT SUMMERLIN

AS SHOWN BY BOOK 112, PAGE 075 OF PLATS
ON FILE IN THE COUNTY RECORDERS OFFICE
CLARK COUNTY, NEVADA. SECTION 35,
TOWNSHIP 20 SOUTH, RANGE 59 EAST,
M.D.M., CITY OF LAS VEGAS, CLARK COUNTY, NEVADA

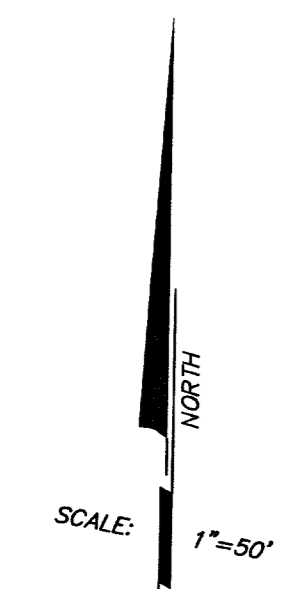


FND ALCAP AND REFERENCE
MONUMENTS STAMPED PLS
13601

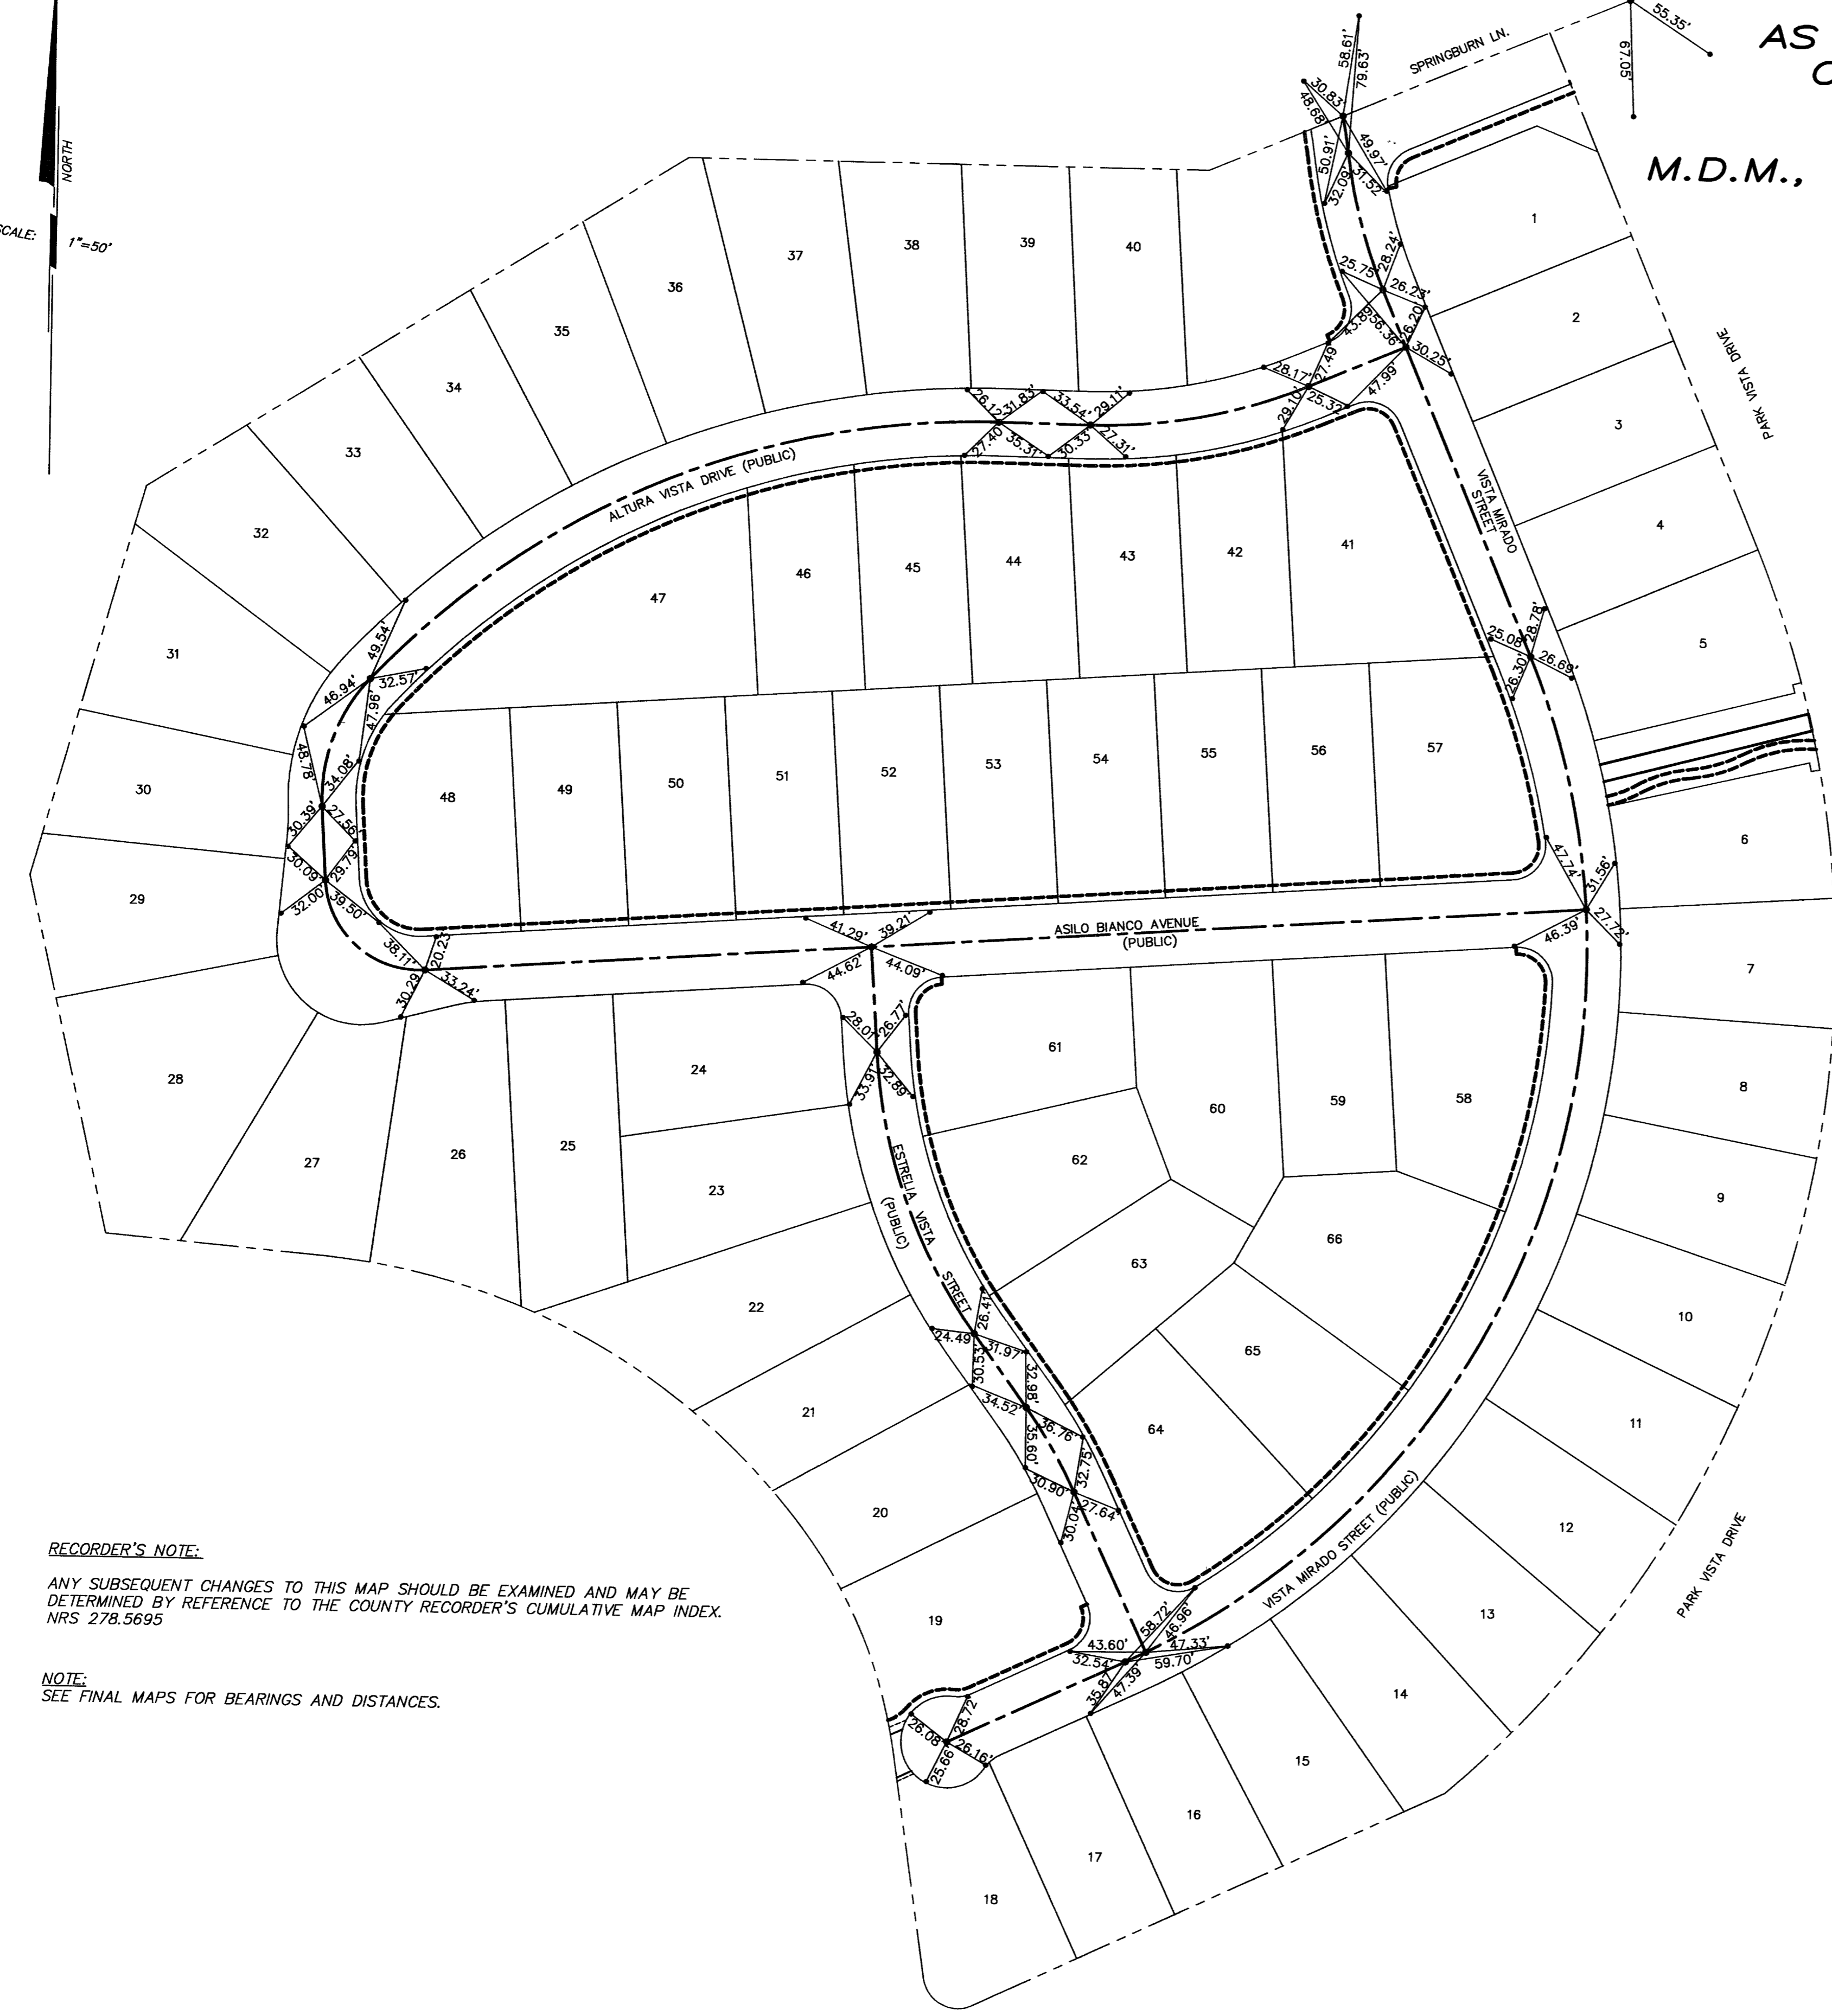

SURVEYOR'S CERTIFICATE

I, LENNIS BOSWORTH, A
LICENSED PROFESSIONAL SURVEYOR IN THE STATE OF
NEVADA, DO HEREBY CERTIFY THAT THE MONUMENTS HAVE
BEEN SET AND THE TIE DISTANCES ESTABLISHED AS SHOWN
HEREON. THIS SURVEY WAS COMPLETED ON
AUGUST 18, 2005.

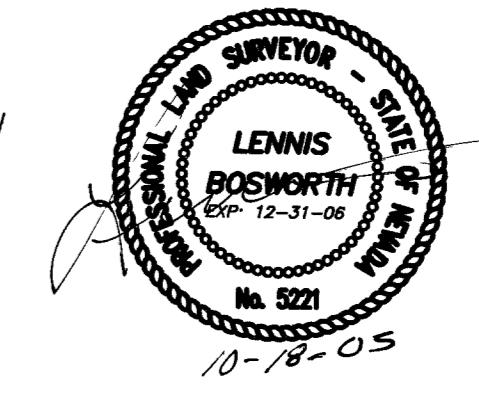

LEGEND

- SET 5/8" REBAR AND ALCAP STAMPED PLS 5221 W/ALUMINUM REFERENCE TIES IN TOP OF CURB
- ▲ SET 5/8" REBAR AND ALCAP STAMPED PLS 5221
- ⊙ FOUND MONUMENTATION AS SHOWN AND DESCRIBED
- × CALCULATED POINT
- 1 LOT NUMBER
- ⬡ BLOCK NUMBER
- SUBDIVISION BOUNDARY LINE
- STREET CENTERLINE

RECORDER'S NOTE:

ANY SUBSEQUENT CHANGES TO THIS MAP SHOULD BE EXAMINED AND MAY BE DETERMINED BY REFERENCE TO THE COUNTY RECORDER'S CUMULATIVE MAP INDEX. NRS 278.5695

NOTE:

SEE FINAL MAPS FOR BEARINGS AND DISTANCES.

PERMIT#10744767 FMP# 2632

MONUMENTATION TIE MAP
FOR
PULTE HOMES

SECTION 35, TOWNSHIP 20 SOUTH, RANGE 59 EAST,
M.D.M., CITY OF LAS VEGAS, CLARK COUNTY, NEVADA

DATE: 08-21-05 FILE: MARATM1 058-4767

Surveyors Inc.

5828 W. SPRING MOUNTAIN RD. LAS VEGAS, NV 89146 (702) 363-0021

89258