


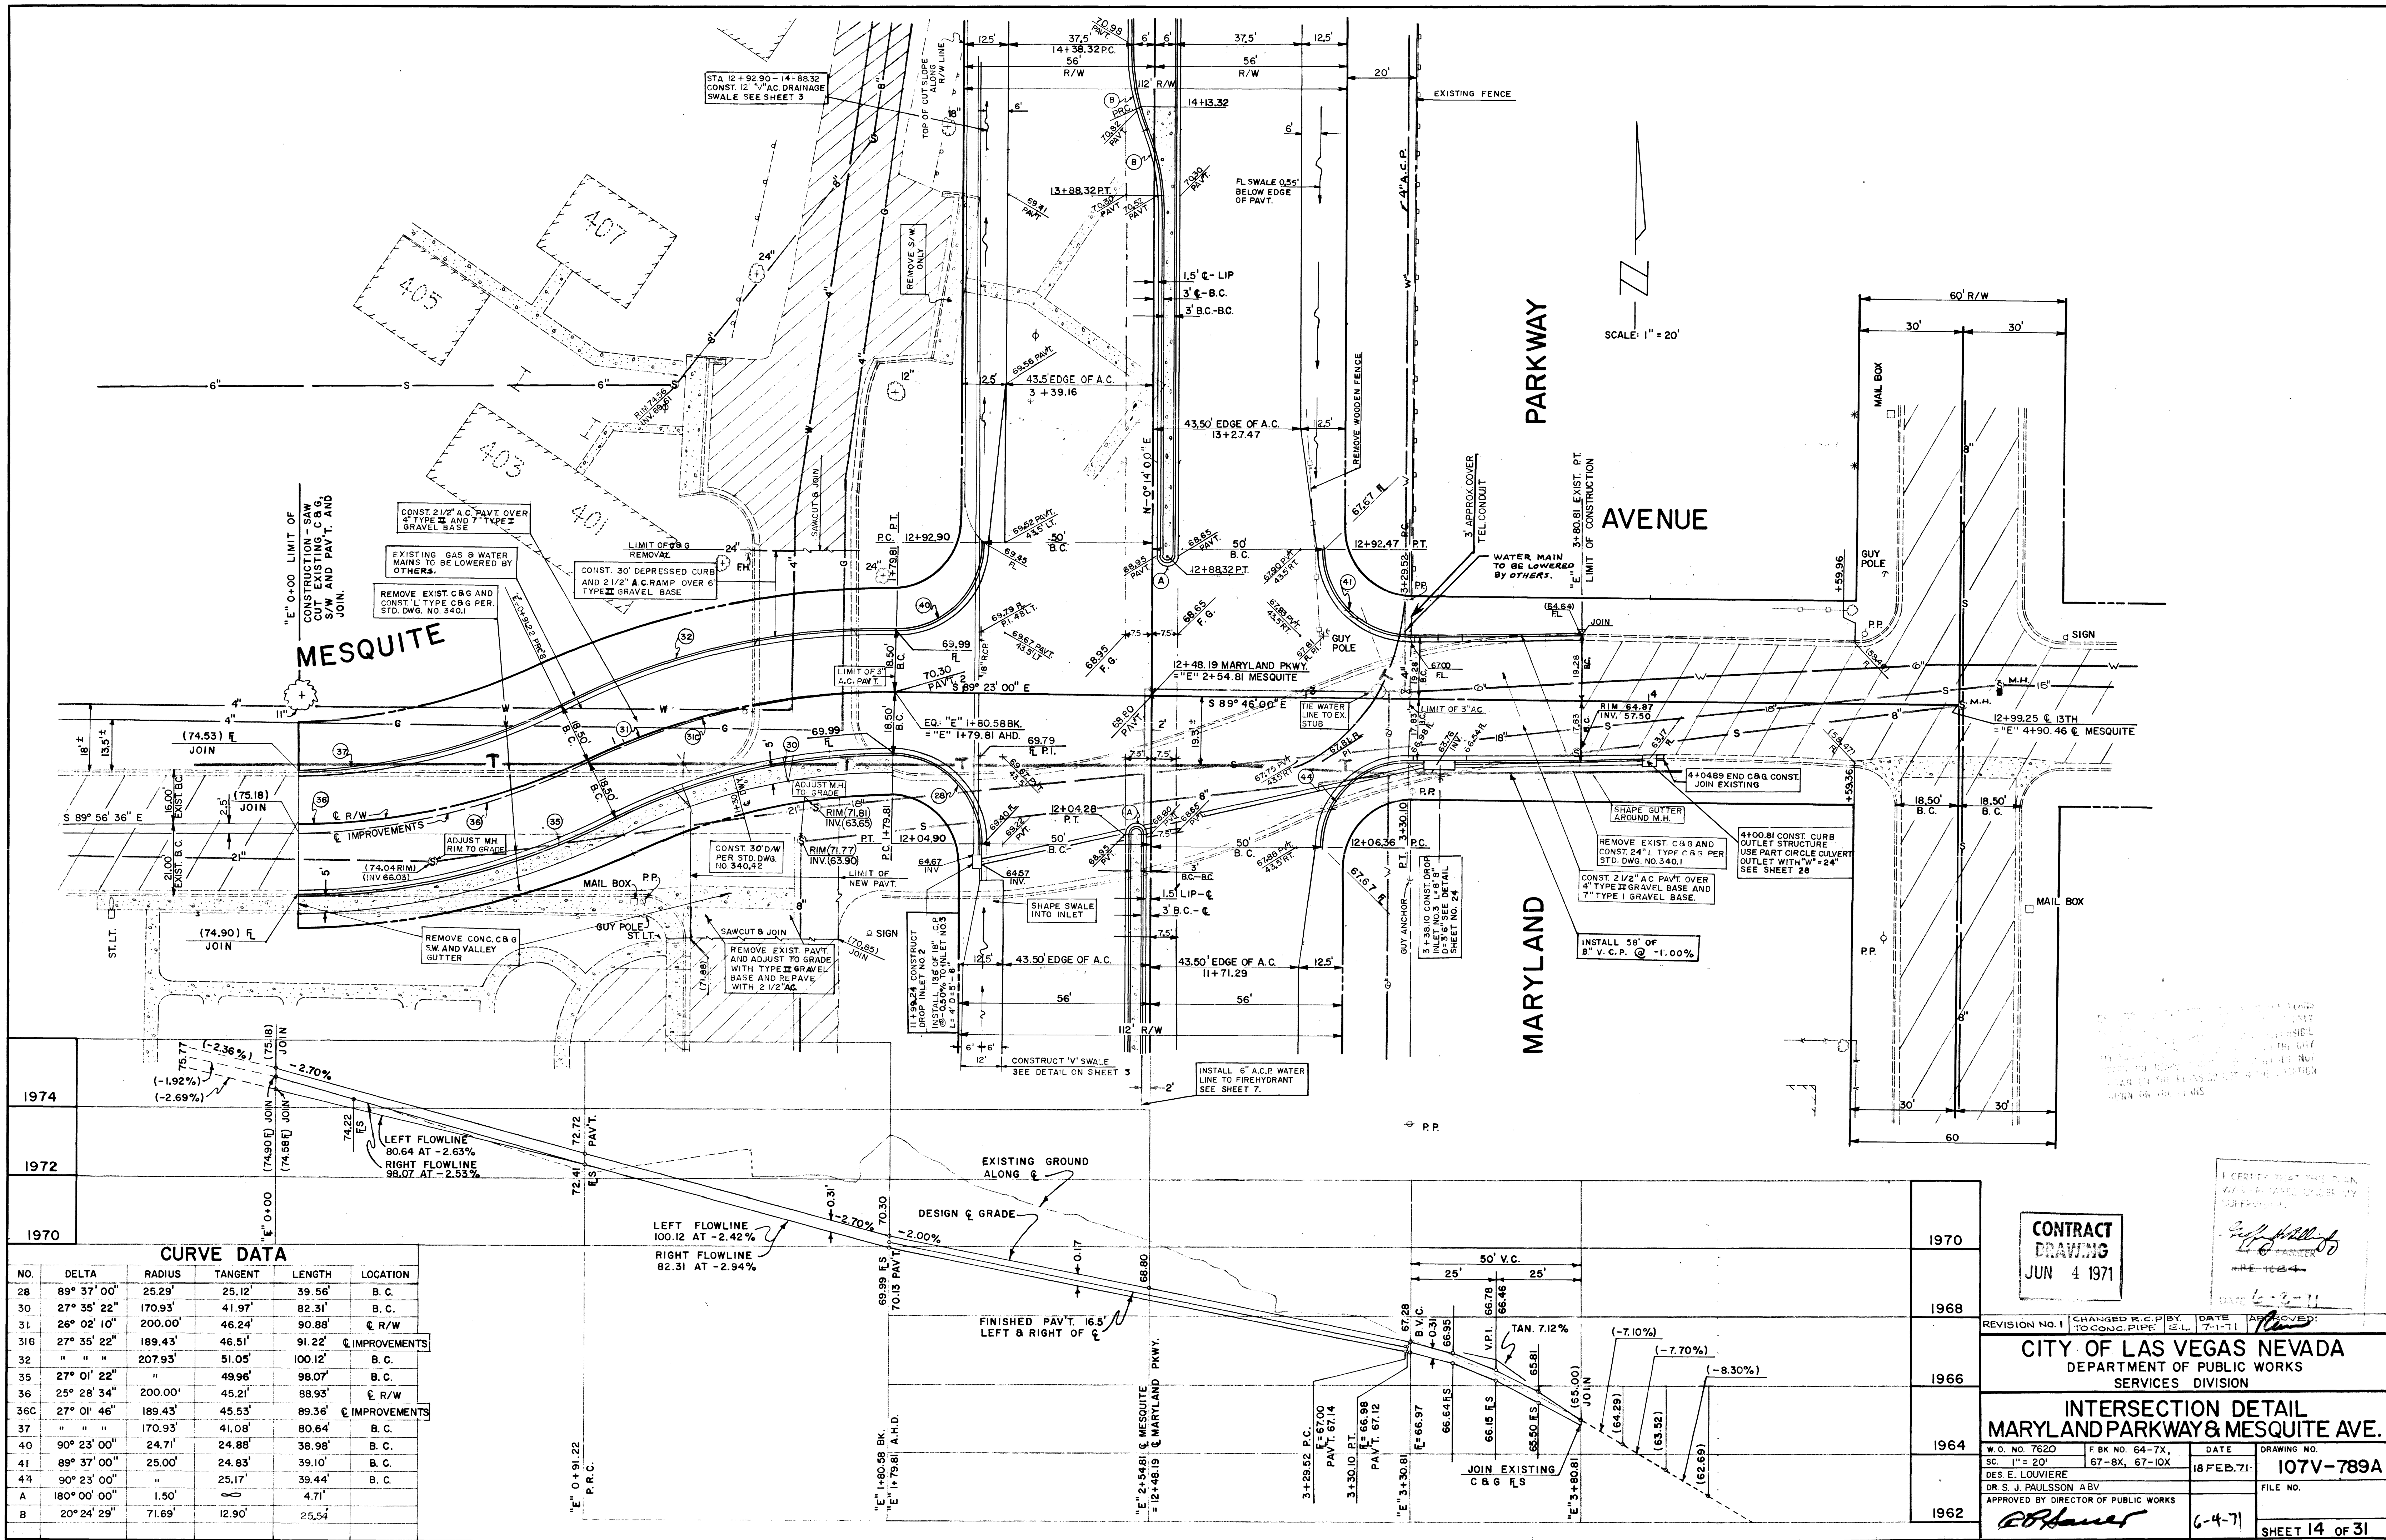

1974
1972
1970

CURVE DATA					
NO.	DELTA	RADIUS	TANGENT	LENGTH	LOCATION
28	89° 37' 00"	25.29'	25.12'	39.56'	B. C.
30	27° 35' 22"	170.93'	41.97'	82.31'	B. C.
31	26° 02' 10"	200.00'	46.24'	90.88'	℄ R/W
316	27° 35' 22"	189.43'	46.51'	91.22'	℄ IMPROVEMENTS
32	" "	207.93'	51.05'	100.12'	B. C.
35	27° 01' 22"	" "	49.96'	98.07'	B. C.
36	25° 28' 34"	200.00'	45.21'	88.93'	℄ R/W
36C	27° 01' 46"	189.43'	45.53'	89.36'	℄ IMPROVEMENTS
37	" "	170.93'	41.08'	80.64'	B. C.
40	90° 23' 00"	24.71'	24.88'	38.98'	B. C.
41	89° 37' 00"	25.00'	24.83'	39.10'	B. C.
44	90° 23' 00"	" "	25.17'	39.44'	B. C.
A	180° 00' 00"	1.50'	" "	4.71'	" "
B	20° 24' 29"	71.69'	12.90'	25.54'	" "

CONTRACT
DRAWING
JUN 4 1971

DATE 6-3-71

REVISION NO. 1

CHANGED R.C.P. BY TO CONC. PIPE

DATE 7-1-71

APPROVED: [Signature]

CITY OF LAS VEGAS NEVADA

DEPARTMENT OF PUBLIC WORKS

SERVICES DIVISION

INTERSECTION DETAIL

MARYLAND PARKWAY & MESQUITE AVE.

W.O. NO. 7620

DATE 18 FEB. 71

DRAWING NO. 107V-789A

DR. S. J. PAULSSON ABV

APPROVED BY DIRECTOR OF PUBLIC WORKS

FILE NO.

6-4-71

SHEET 14 OF 31

23203