


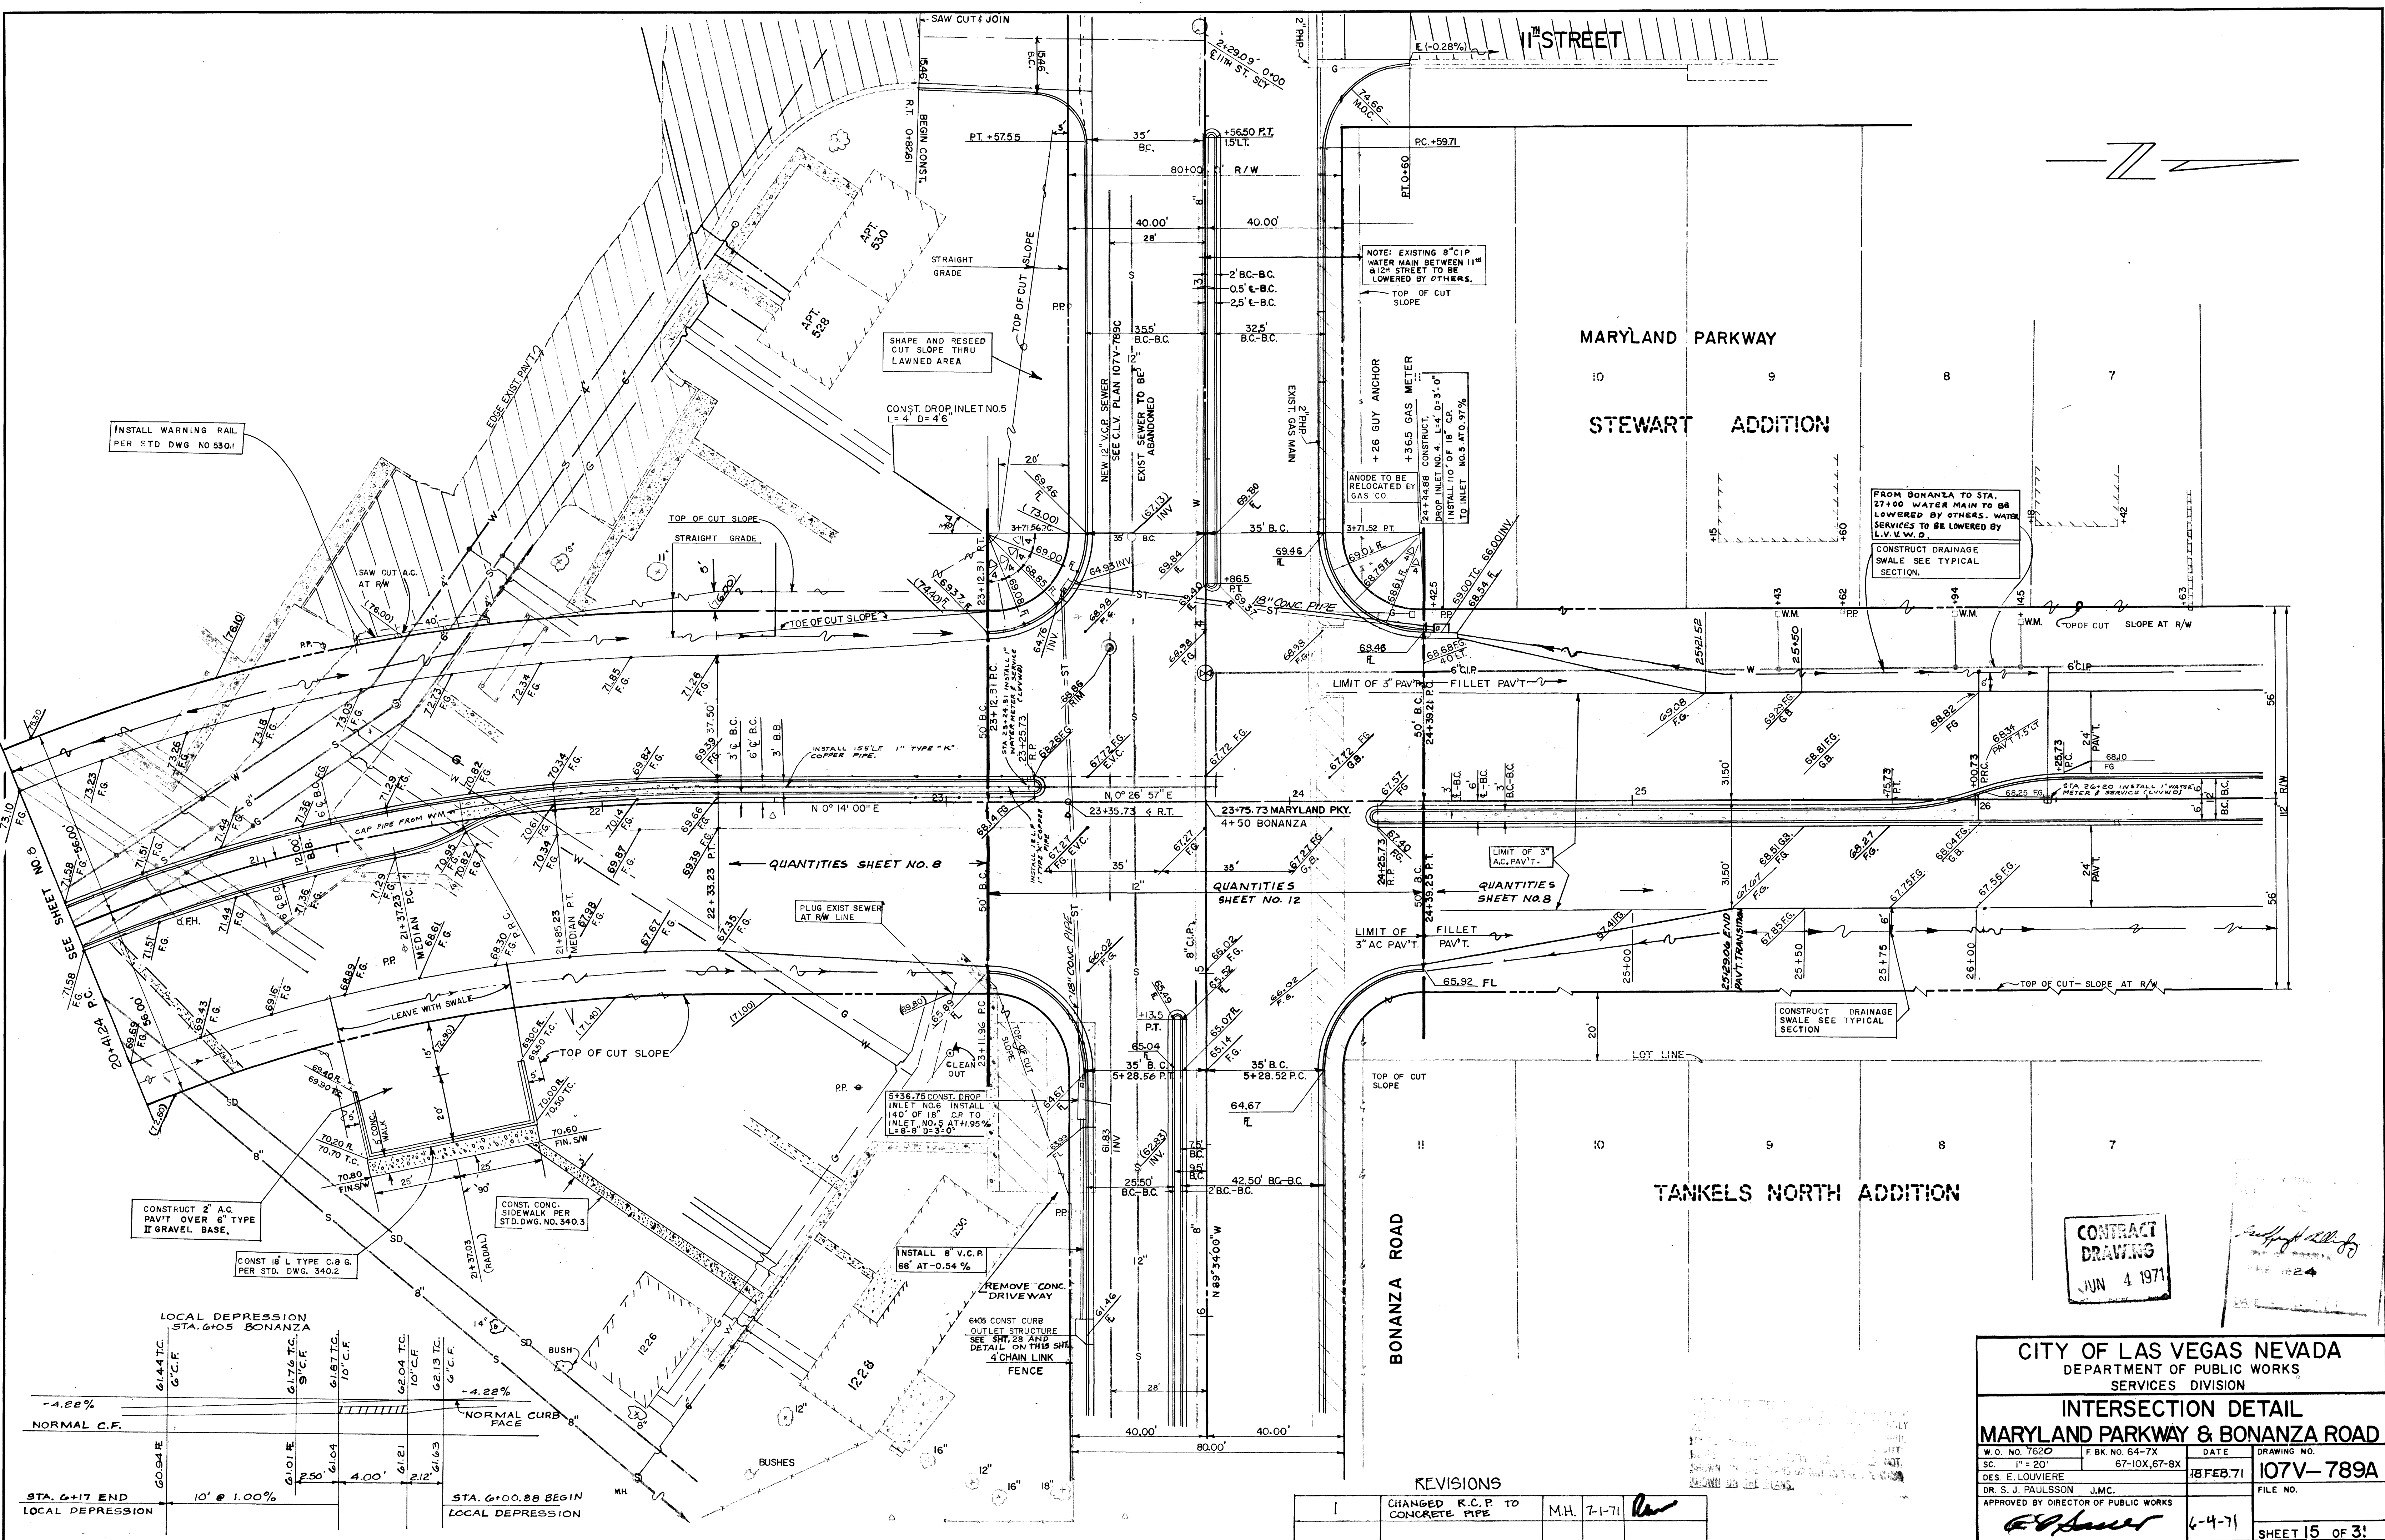

CONTRACT
DRAWING
JUN 4 1971

CITY OF LAS VEGAS NEVADA DEPARTMENT OF PUBLIC WORKS SERVICES DIVISION			
INTERSECTION DETAIL MARYLAND PARKWAY & BONANZA ROAD			
W.O. NO. 7620	F.B.K. NO. 64-7X	DATE	DRAWING NO.
SC. 1" = 20'	67-10X, 67-8X	18 FEB 71	107V-789A
DES. E. LOUIVIERE			FILE NO.
DR. S. J. PAULSSON J.M.C.			
APPROVED BY DIRECTOR OF PUBLIC WORKS		6-4-71	SHEET 15 OF 31

REVISIONS			
1	CHANGED R.C.P. TO CONCRETE PIPE	M.H.	7-1-71

23204