


APPROXIMATE QUANTITIES - THIS SHEET			
ITEM	DESCRIPTION	UNIT	QUANTITY
201.1	ROADWAY EXCAVATION - UNCLASSIFIED	CY	1854 268
200.11	REMOVE CONC. CURB & GUTTER	LF	426
200.12	REMOVE CONC. SIDEWALK	S.F.	2124
200.13	REMOVE BLOCK WALL	L.F.	351
340.1	CONSTRUCT CONC. CURB & GUTTER	LF	426 507
340.2	CONSTRUCT CONC. ISLAND CURB & GUTTER	LF	1060
340.3	CONSTRUCT CONC. SIDEWALK	S.F.	2124 2542
340.31	CONSTRUCT CONC. MEDIAN SURFACE	S.F.	729
510.2	MASONRY BLOCK RETAINER WALL	S.F.	995
302.1	TYPE I GRAVEL BASE	C.Y.	809 205
302.2	TYPE II GRAVEL BASE	C.Y.	368 35
334.6	3" ASPHALTIC CONC. PAVEMENT	TON	351 49
333.1	1/2" OPEN GRADED PLANTMIX	S.Y.	2172 282
410.2	RELOCATE CHAIN LINK FENCE (6')	LF	351
201.1	RELOCATE SPRINKLER SYSTEM	LF	190
560.08	RELOCATE FIRE HYDRANT & VALVE BOX	E.A.	1
334.503	ASPHALT CONC. ISLAND SURFACE (1 1/2")	TON	36
200.12	REMOVE & RESET WELD W. FE. & ST. POST	LF	508
334.800	BITUMINOUS PRIME COAT	GAL.	62 85
510.340	MEDIAN A.C. COLORING	S.Y.	397
560.114	1" COPPER PIPE (TYPE 'K')	LF	50

CURVE DATA					
NO.	DELTA	RADIUS	TANGENT	LENGTH	LOC.
A	180°00'00"	1.50'	∞	4.71'	BC.
B	20°24'29"	71.69'	12.90'	25.54'	BC.

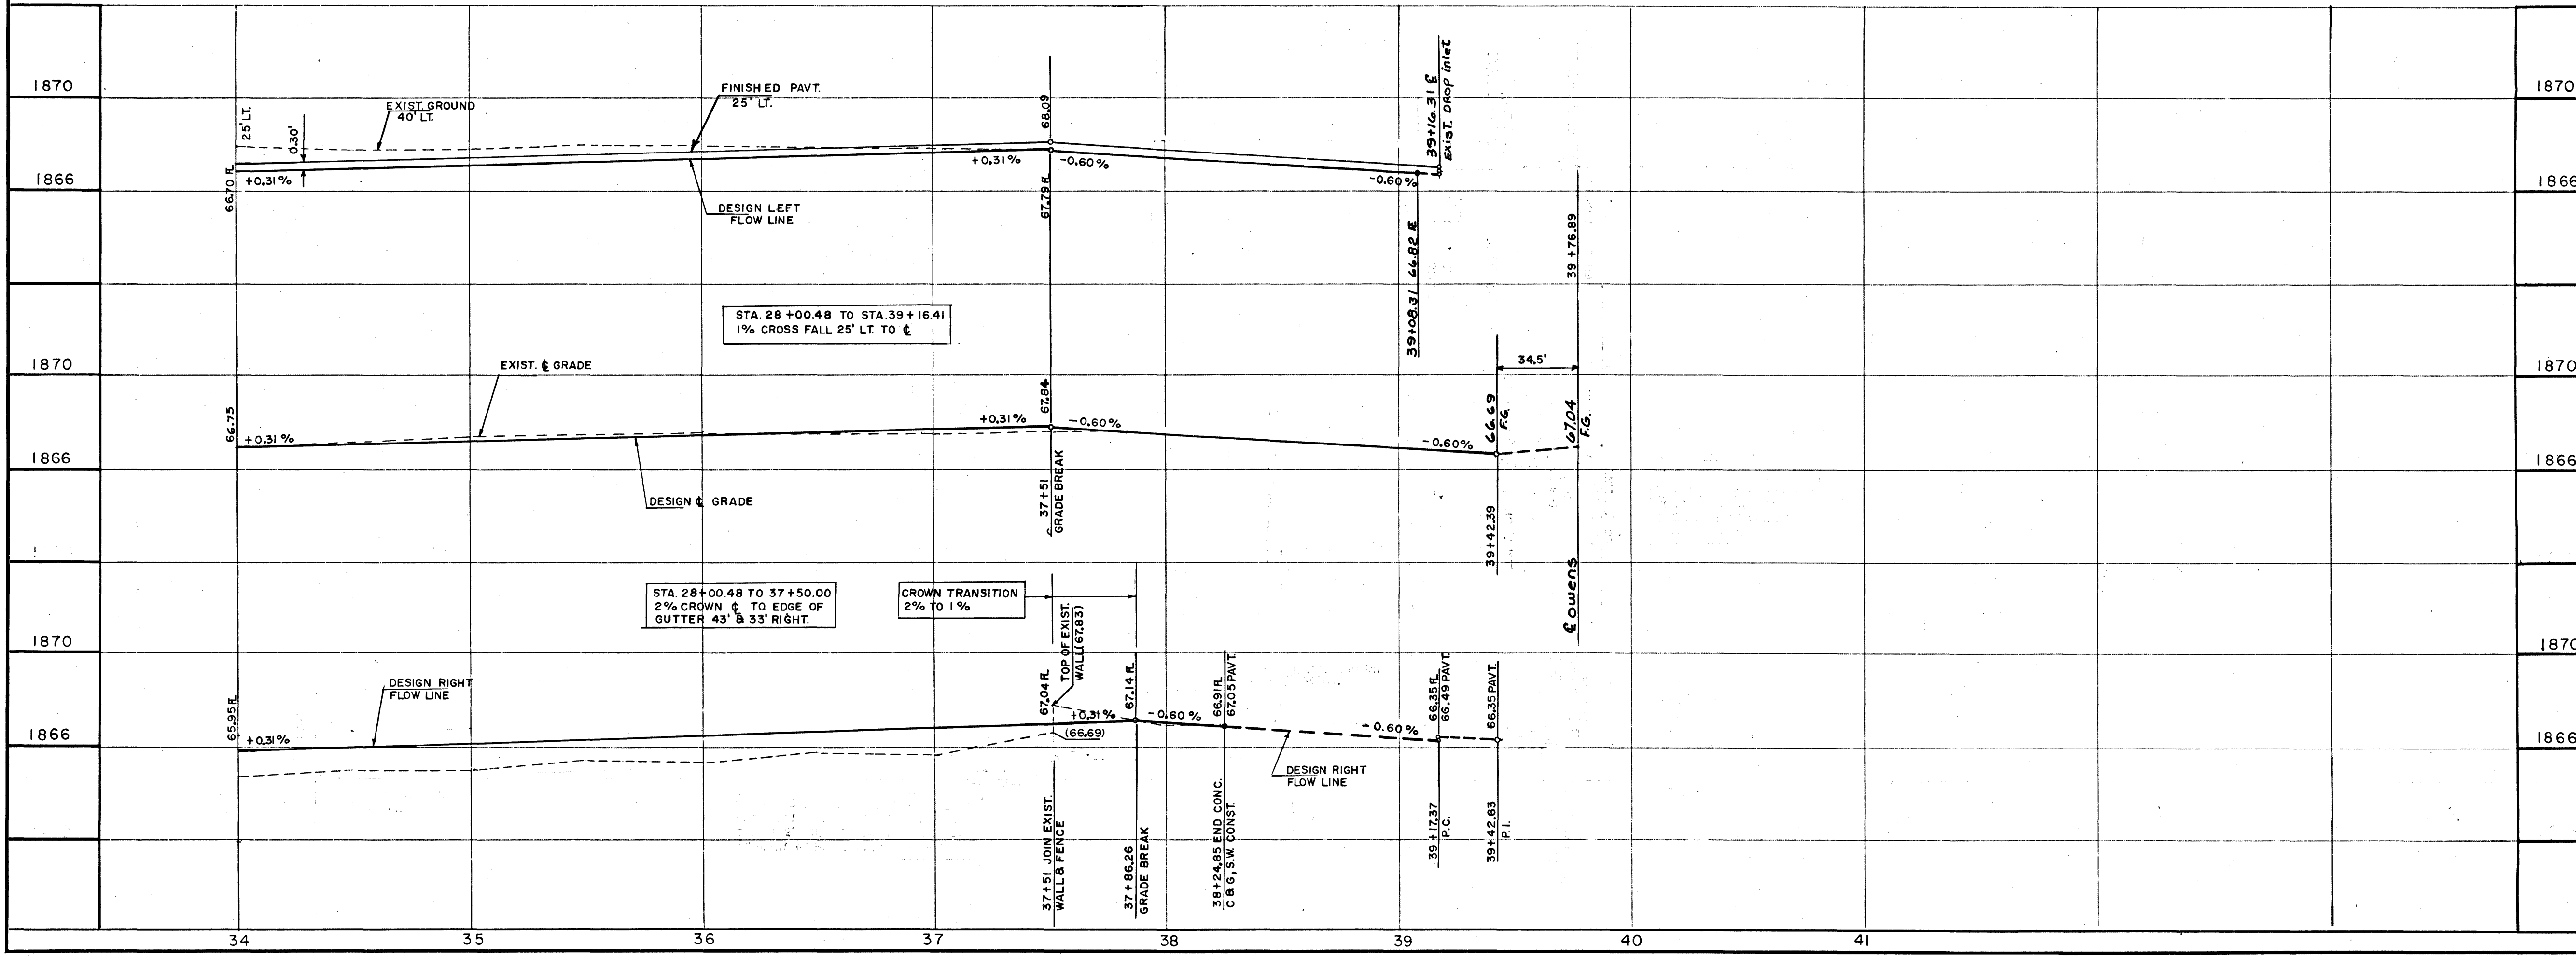

I HEREBY CERTIFY THIS PLAN  
AND SPECIFICATIONS TO BE UNDER MY  
SUPERVISION

*Jeff A. Hill*  
DATE 6-2-71

**CONTRACT  
DRAWING**  
JUN 4 1971

REVISION NO.	DESCRIPTION	BY	DATE	APPROVAL

CITY OF LAS VEGAS NEVADA  
DEPARTMENT OF PUBLIC WORKS  
SERVICES DIVISION

BRUCE STREET WIDENING  
HARRIS-OWENS STA 34+00 - 69+71

W.O. NO. 7620	F.B.K. NO. 64-7X	DATE	DRAWING NO.
SC. (H) 1"=40'	SC. (V) 1"=4'	15 FEB. 71	107V-789B
DES. LOUVIERE	DR. VANTO	APPROVED BY DIRECTOR OF PUBLIC WORKS	FILE NO.
		<i>[Signature]</i>	6-4-71

SHEET 22 OF 31