
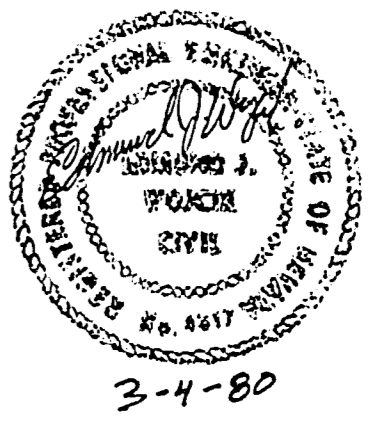


PLAN
 DRAWN BY: DMM
 CHECKED BY: JWH
 DATE: 2-79
 NO. 1074231633

PROFILE
 DRAWN BY: DMM
 CHECKED BY: JWH
 DATE: 2-79
 NO. 1074231633

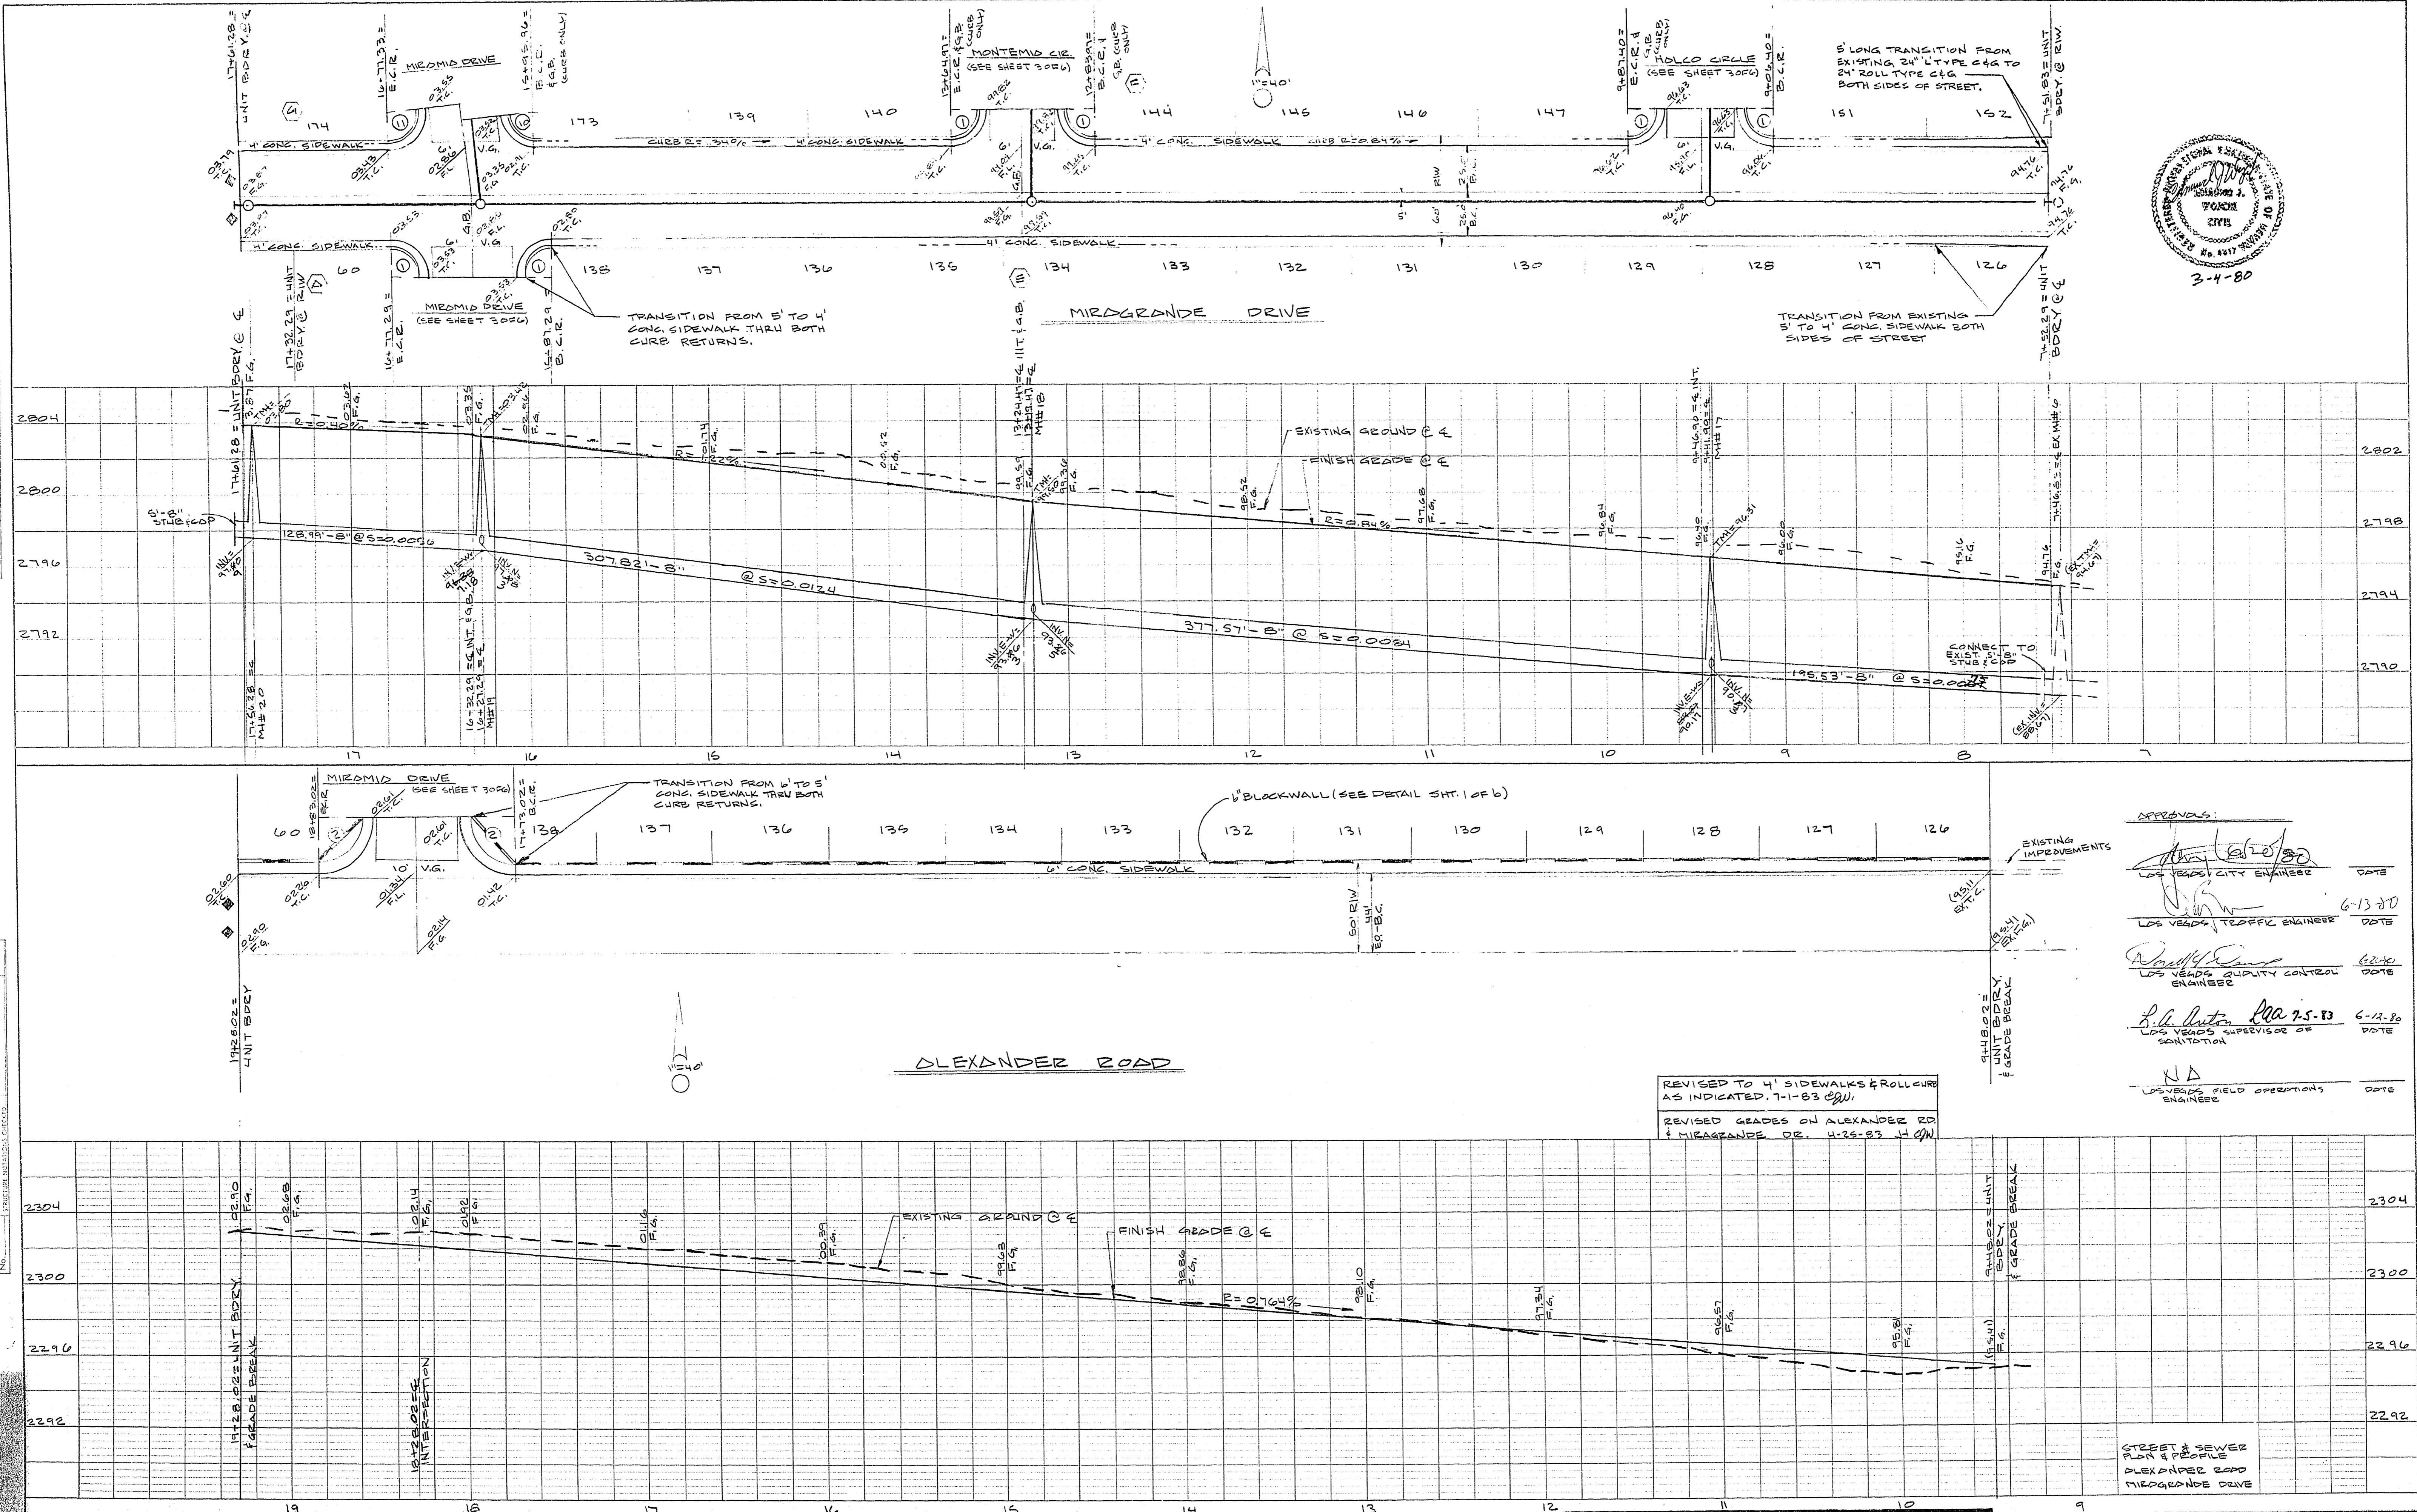

APPROVALS:

 LOS VEGAS CITY ENGINEER DATE 6-13-80

 LOS VEGAS TRAFFIC ENGINEER DATE 6-13-80




30-7-89