



Call before you Dig
1-800-227-2600

Avoid cutting underground utility lines. It's costly.

Call before you Overhead
1-702-593-6111

SEWER CONSTRUCTION NOTES

- ◇ INSTALL 8" PVC SANITARY SEWER LINE
- ◇ INSTALL 48" SANITARY SEWER MANHOLE PER DESIGN AND CONSTRUCTION STANDARDS FOR WASTEWATER COLLECTION SYSTEMS PLATE SD-1
- ◇ INSTALL 8" CAP AND 5 LF 8" PVC STUB

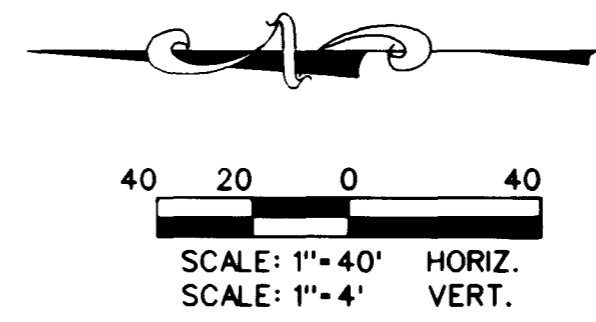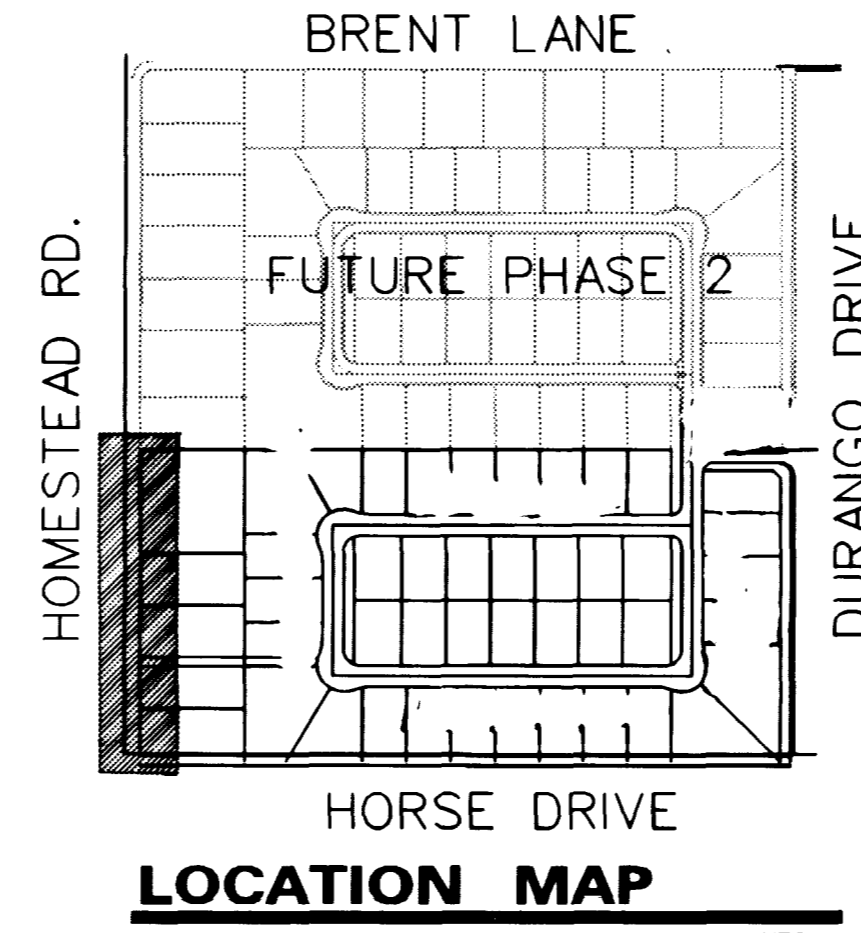


BASIS OF BEARING


NORTH 0015'13" EAST, BEING THE BEARING OF THE EAST LINE OF THE NORTHEAST QUARTER (NE 1/4) OF THE NORTHEAST QUARTER (NE 1/4) OF THE NORTHEAST QUARTER (NE 1/4) OF SECTION 8, TOWNSHIP 19 SOUTH, RANGE 60 EAST, M.D.M. CLARK COUNTY, NEVADA AS SHOWN ON THE MAP IN FILE 87, OF SURVEYS, PAGE 83, OFFICIAL RECORDS OF CLARK COUNTY, NEVADA.

BENCHMARK

C.L.V. BENCHMARK: 1LV90-8NES
BLM BRASS CAP AT THE INTERSECTION OF DURANGO DRIVE AND IRON MOUNTAIN ROAD
NAVD 1988 ELEV 771.9689 METERS (2532.70 FEET)

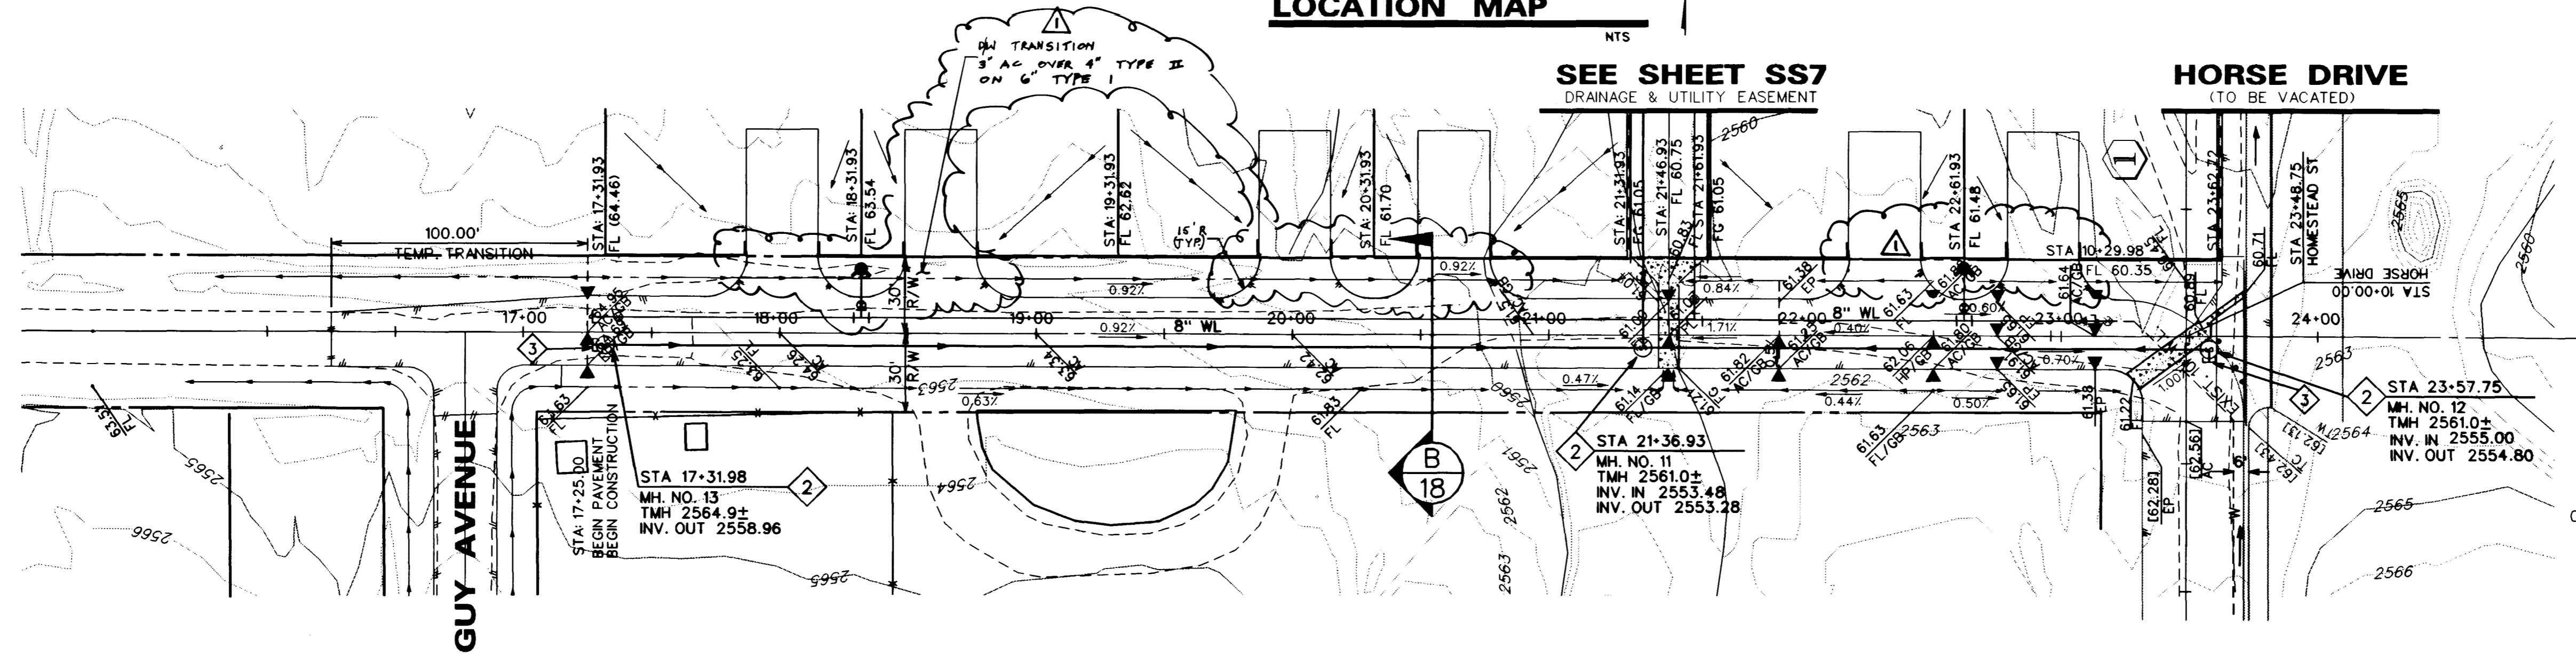

HOMESTEAD STREET (PUBLIC)

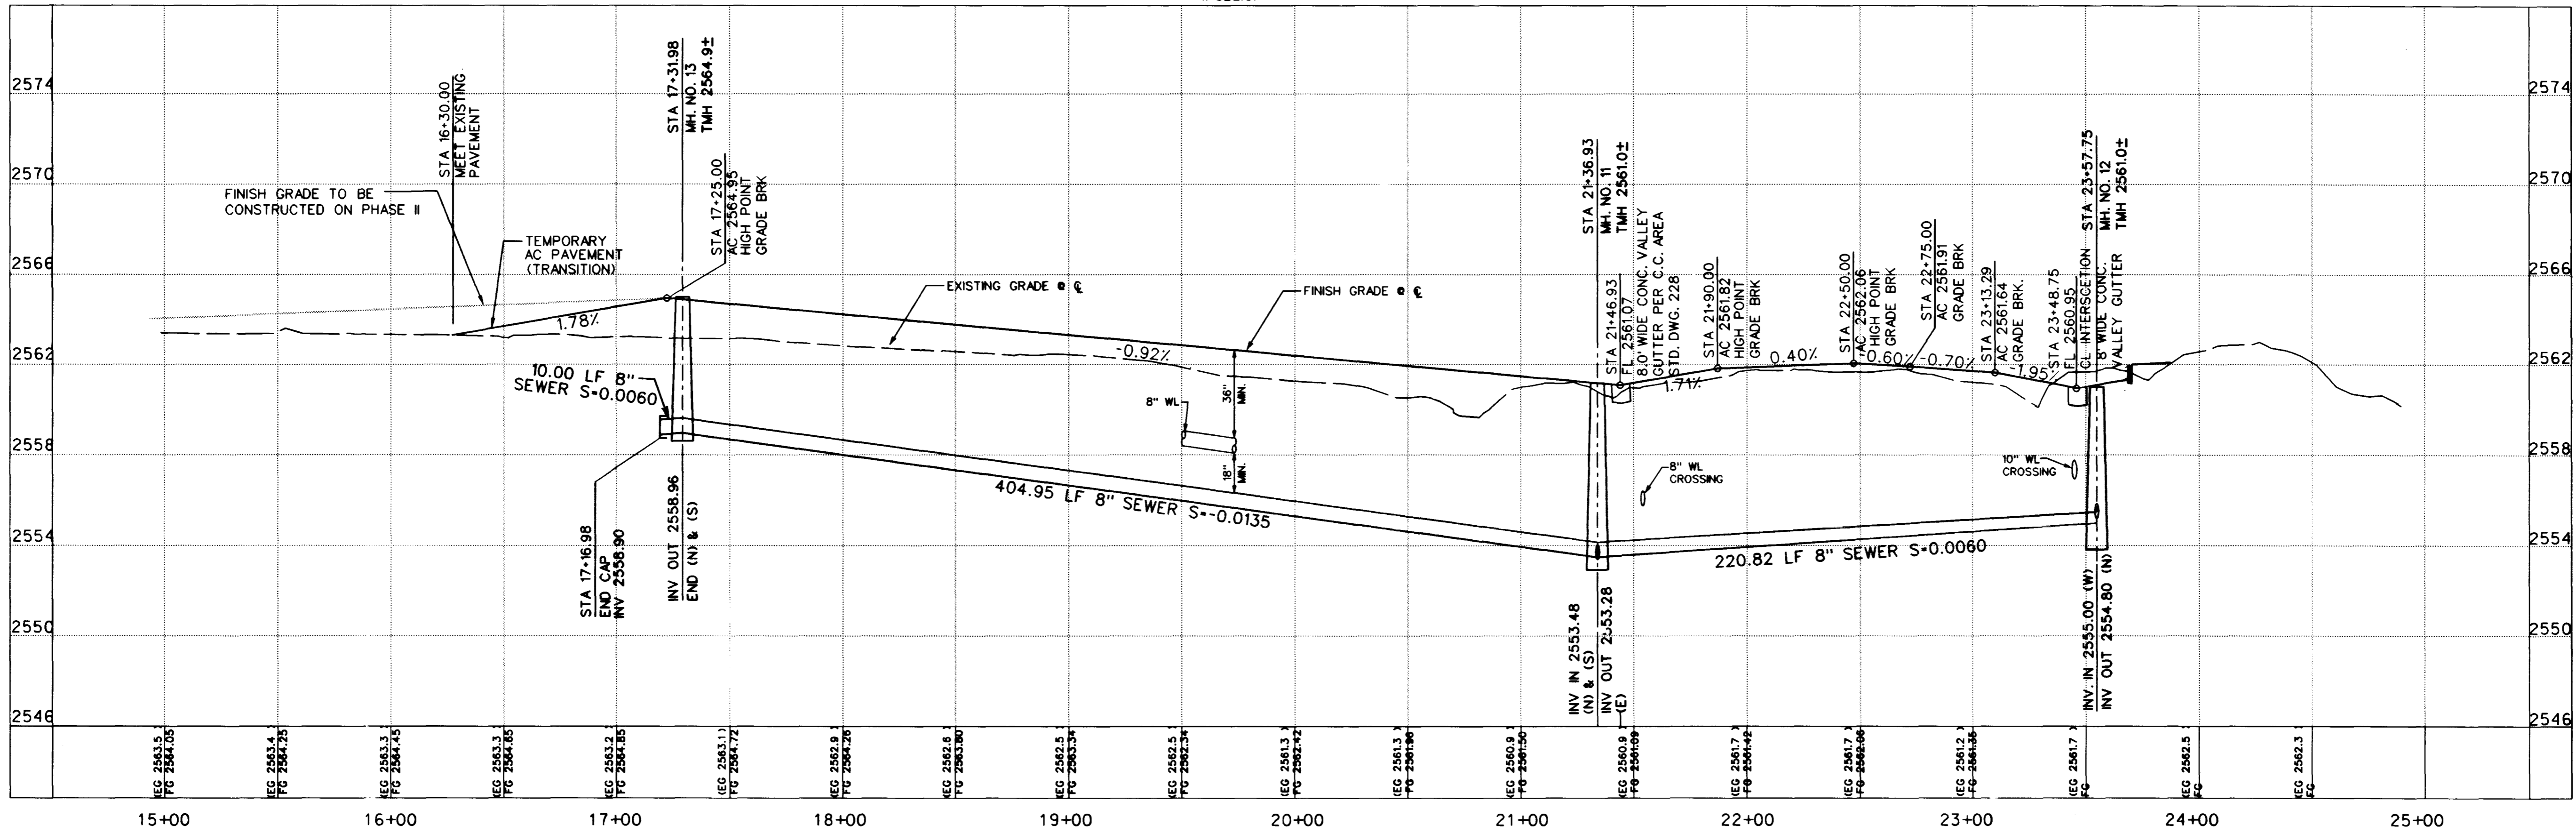

RICHMOND AMERICAN HOMES OF NEVADA INC.
6280 S. Valley View Blvd.
Suite 200
Las Vegas, NV 89118
Tel: (702) 368-0006
Fax: (702) 368-0047

PLAN AND PROFILE
HOMESTEAD STREET
STA 17+00 TO 24+00.00

MYSTIC VALLEY
PHASE I

SHEET 11/4/98

DESIGNED BY: G. HOWELL, W. KIM

CHECKED BY: E. SERRANO, M. BELEN

PROJECT NO.: 98-9031-03

SCALE: 1"=40' HORIZ. 1"=4' VERT.

DATE: 11/4/98

DATE: 4/26/99

SEAL: JAMES W. LELAND, CIVIL ENGINEER, No. 4932

SHEET SS2 OF 18 SHEETS

DRAWING NO. 1074-4599-1

15317 17022 18350

Call before
you Dig
1-800-281-2600

Call before
you Overhead
1-702-323-68















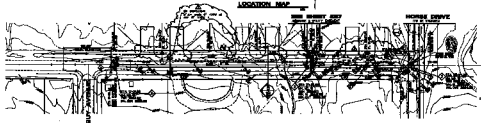

HOMESTEAD STREET

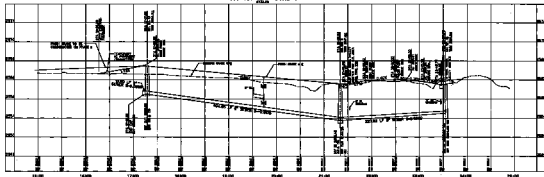









