



CHEYENNE AVENUE

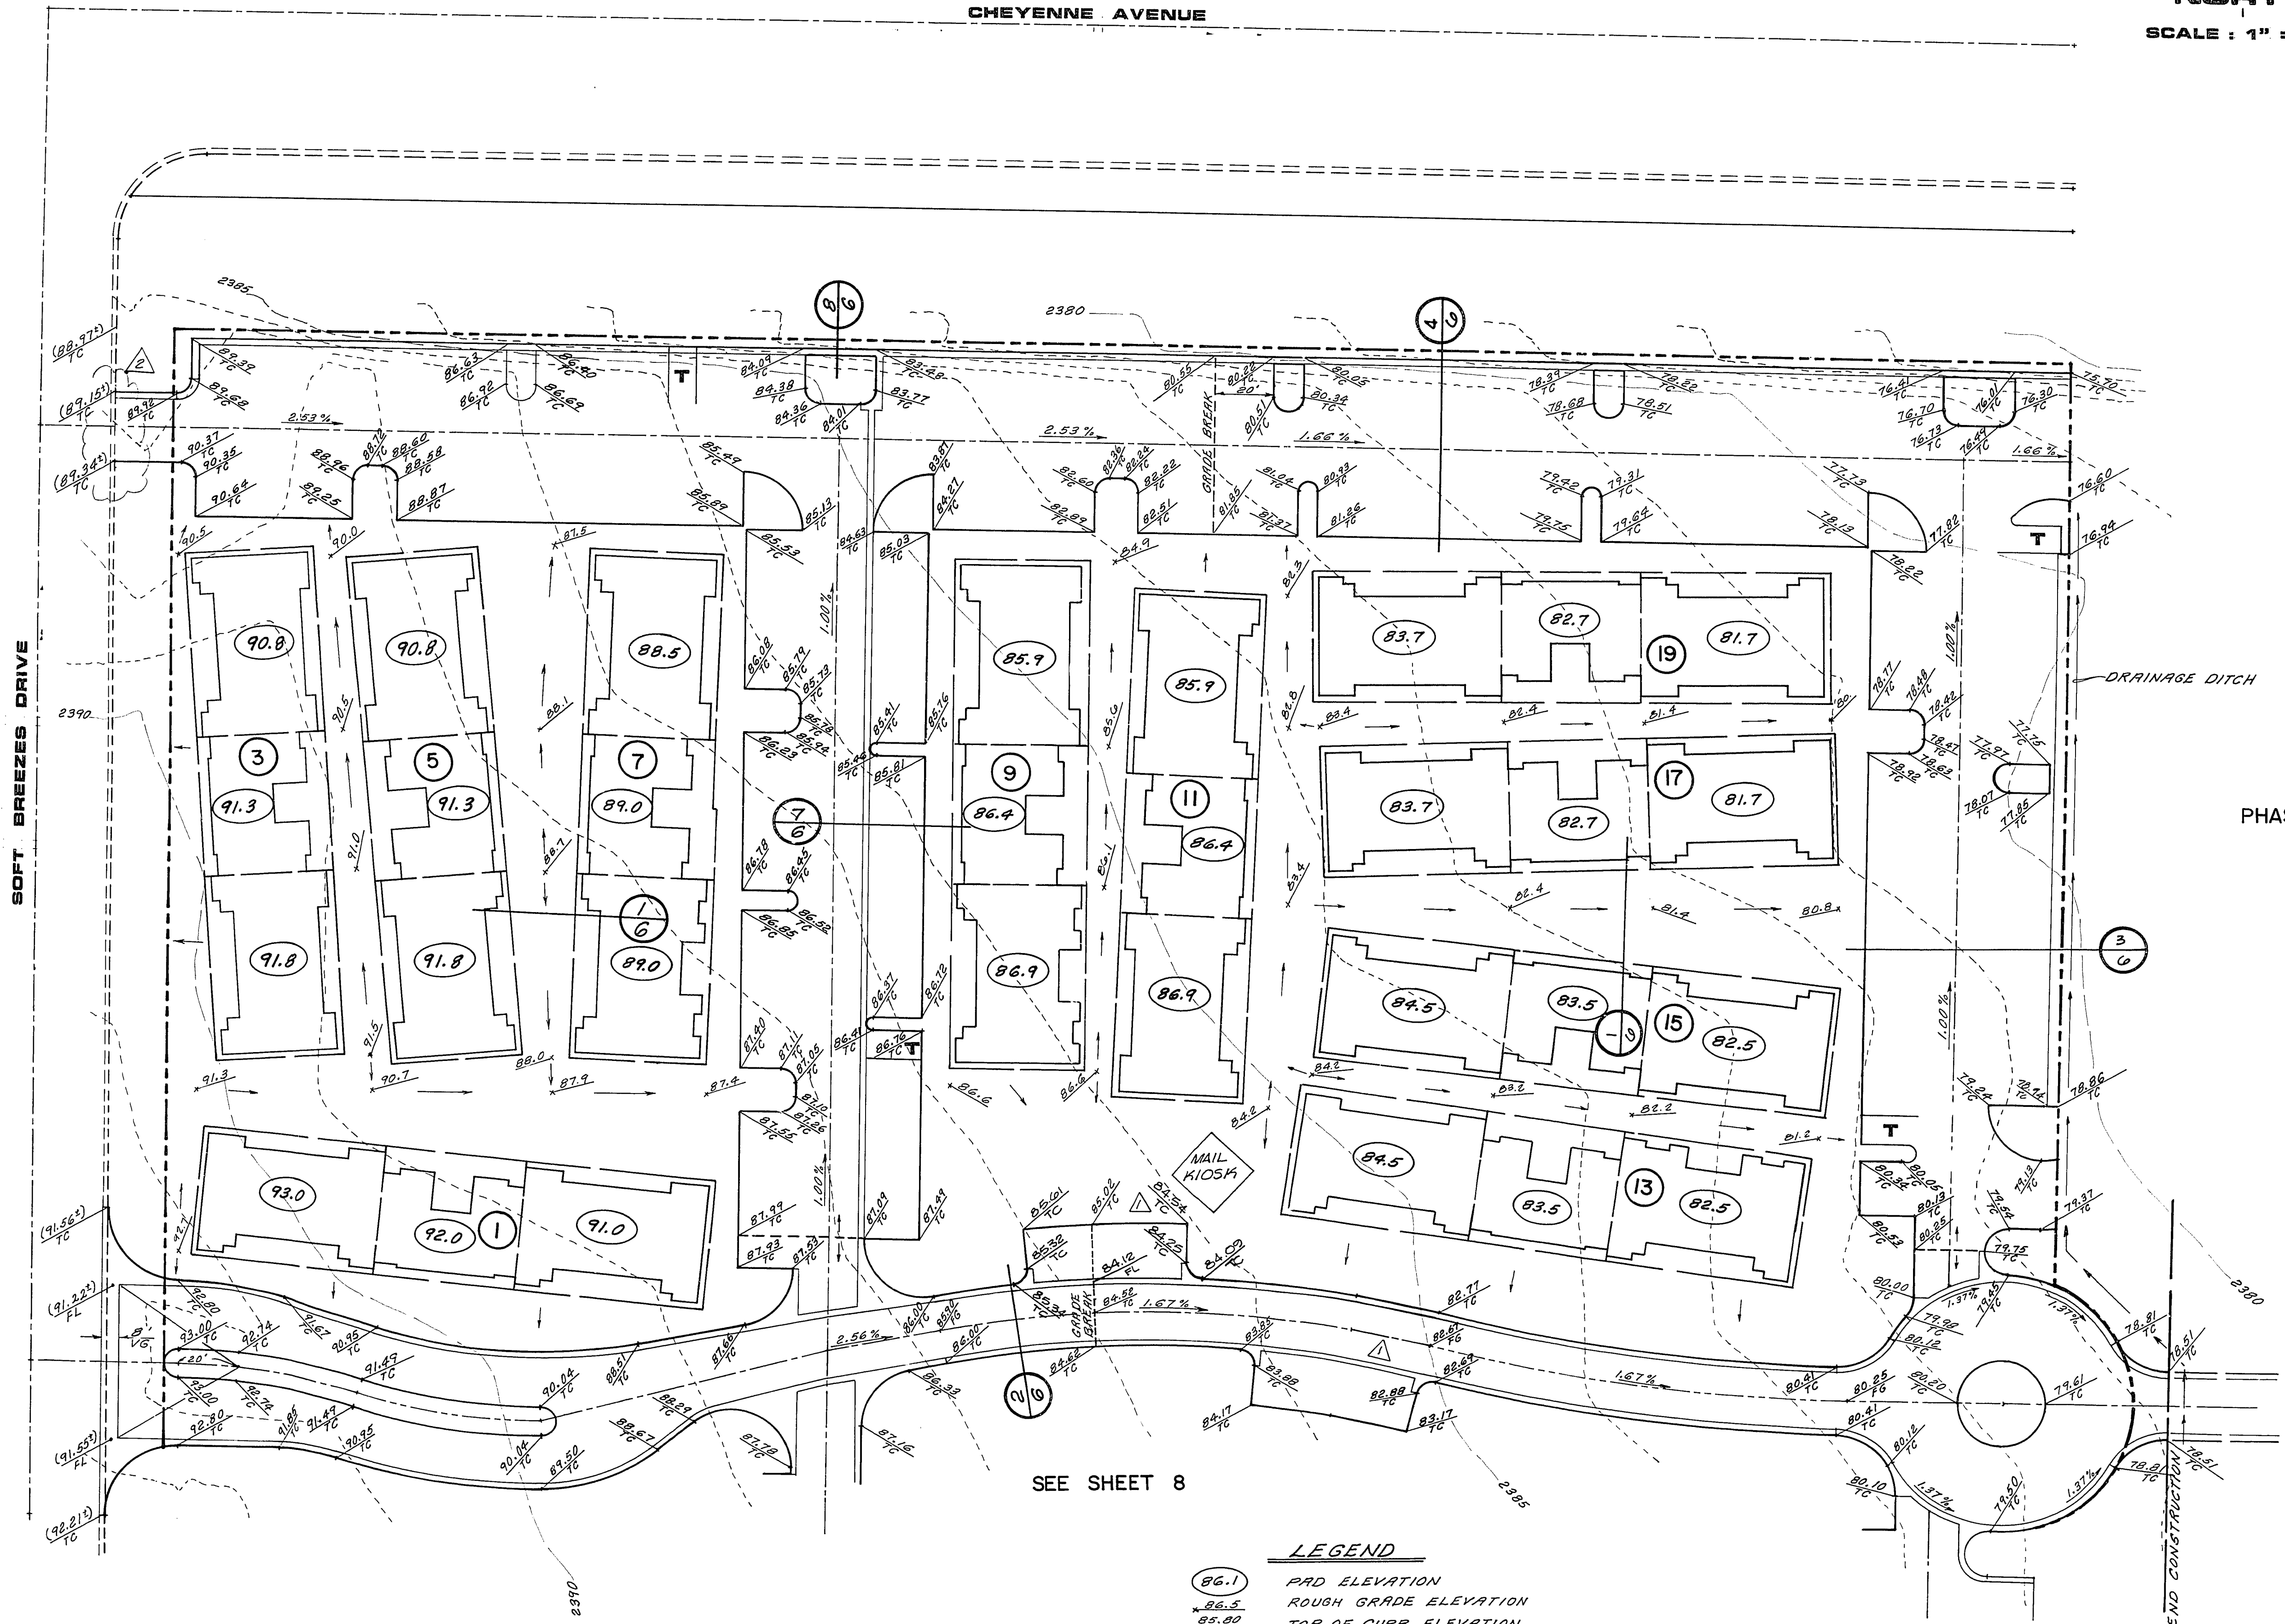

SEE SHEET 8

- LEGEND**
- 86.1 PAD ELEVATION
 - 86.4 FINISHED GRADE ELEVATION
 - 2" TYPE CURB
 - 4" TYPE CURB
 - INDICATES DIRECTION OF DRAINAGE
 - 2' CONC. VALLEY GUTTER

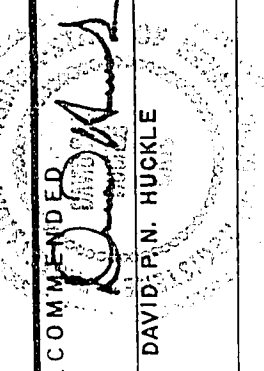

RECOMMENDED
 COMMUNITY CONSTRUCTION, CO.
 MAR - A - LAGO PHASE I
 GRADING PLAN I

G.C. WALLACE, INC.
 Engineering/Architecture
 1535 SOUTH RAINBOW BLVD. LAS VEGAS, NEVADA 89102

COMMUNITY CONSTRUCTION, CO.
 MAR - A - LAGO PHASE I
 GRADING PLAN I

SHEET
7
 OF 8 SHEETS

REV	DATE	DESCRIPTION
1	10-4-88	10448 RELEASED PER NRS 624.017 & 624.018
2		10448 DELETED DRAWING FOR ENR. ACCESS N.J.

10-3-139

107-V1621