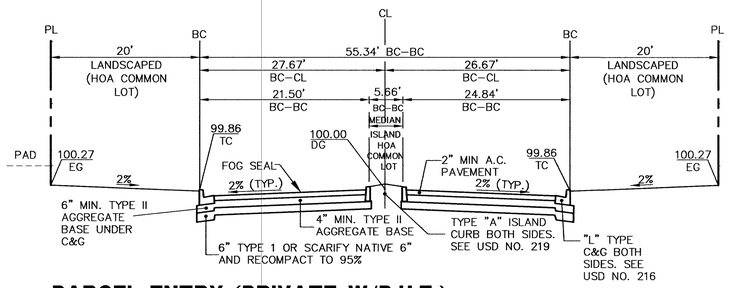

PARCEL ENTRY (PRIVATE W/P.U.E.)

(PRIVATE STREET)

NOT TO SCALE

1 / –

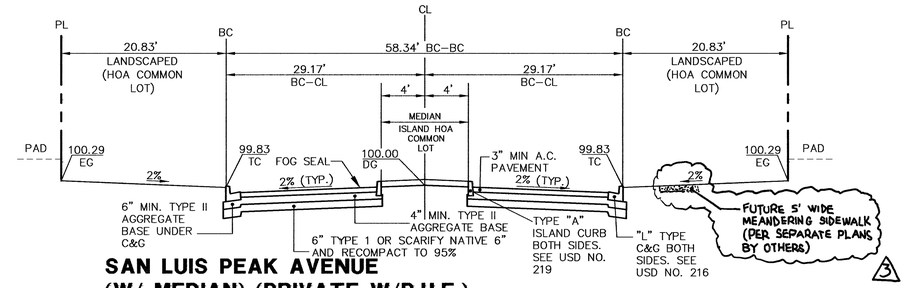

SAN LUIS PEAK AVENUE (W/ MEDIAN) (PRIVATE W/P.U.E.)

(NEIGHBORHOOD COLLECTOR)

NOT TO SCALE

4 / –

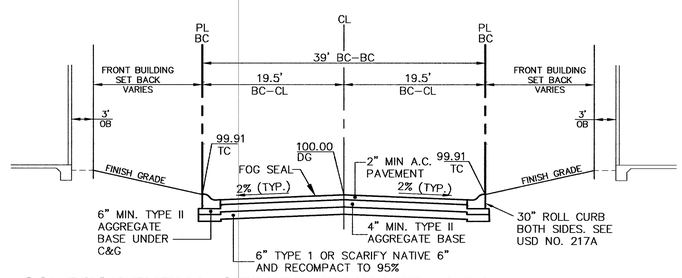

39' RESIDENTIAL STREET (PRIVATE W/P.U.E.)

(PRIVATE STREET)

NOT TO SCALE

2 / –

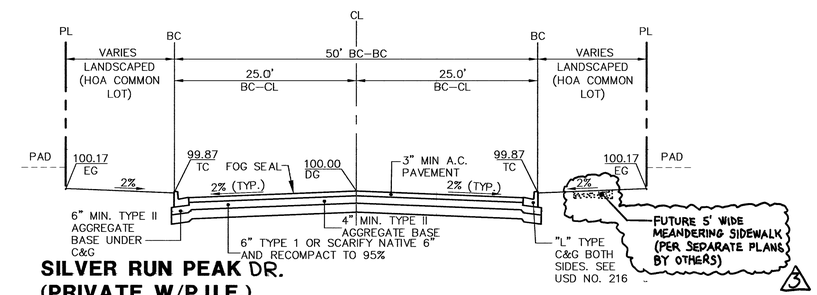

SILVER RUN PEAK DR. (PRIVATE W/P.U.E.)

(NEIGHBORHOOD COLLECTOR)

NOT TO SCALE

5 / –

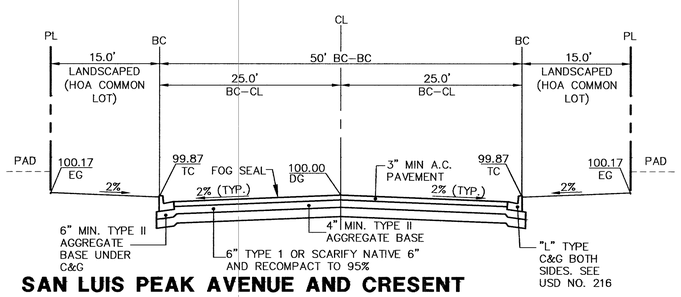

SAN LUIS PEAK AVENUE AND CRESENT MOUNTAIN STREET (W/O MEDIAN) (PRIVATE)

(NEIGHBORHOOD COLLECTOR)

NOT TO SCALE

3 / –

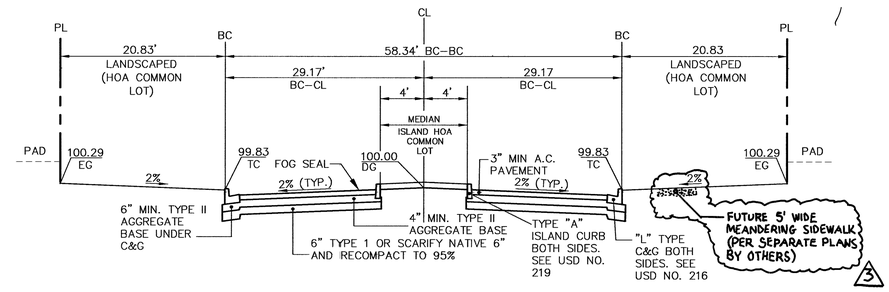

CRESCENT MOUNTAIN STREET (W/ MEDIAN) (PRIVATE W/P.U.E.)

(NEIGHBORHOOD COLLECTOR)

NOT TO SCALE

6 / –

B5391 ll 43753

CLV DRAWING NO. 107Y499(-1

DATE: 5/05

REV	DATE	DESCRIPTION	DATE AGEN. APP	DATE GCW. APP
A	5/25/06	ADD FUTURE MEANDERING SIDEWALK AND DETAIL 3	7/18/06 KB	

DESIGN:
DRAWN:
CHECK:
ISSUE DATE:
ISSUE EDITOR:
PLOT DATE: 11-15-05
PLOT TIME: 14:23:53
tbaker

G. C. WALLACE, INC.
Engineers/Planners/Surveyors
1555 SOUTH RAINBOW BLVD./LAS VEGAS, NEVADA 89146
TELEPHONE: (702) 804-2000 • FAX: (702) 804-2299
I:\Northern Terrace\Unit1\dwg\maps\NTU1c019.dwg
tbaser

MERITAGE HOMES
NORTHERN TERRACE - UNIT 1
TYPICAL SECTIONS

JOB NO. 819.002.X08

DRAWING
C-19
19 OF 39 SHTS