


DATE: 02-15-06
REV. DATE: 08-12-03
DESCRIPTION: BANDERA MOUNTAIN LANE STORM DRAIN LATERAL DETAIL STA. 20+38.51

DESIGN: G.C. WALLACE, INC.
DRAWN: G.C. WALLACE, INC.
CHECK: G.C. WALLACE, INC.
ISSUE DATE: 02-15-06
ISSUE EDITOR: G.C. WALLACE, INC.
PLOT DATE: 02-15-06
PLOT TIME: 08:12:43

G.C. WALLACE, INC.
Engineers/Planners/Surveyors
1555 SOUTH RAINBOW BLVD., LAS VEGAS, NEVADA 89146
TELEPHONE: (702) 864-2600 • FAX: (702) 864-2289
In Northern Terrace Units Nevada, NV 89134


MERTAGE CORPORATION
NORTHERN TERRACE - UNIT 4
GRADING DETAILS

DRAWING
C-13
13 OF 15 SHTS

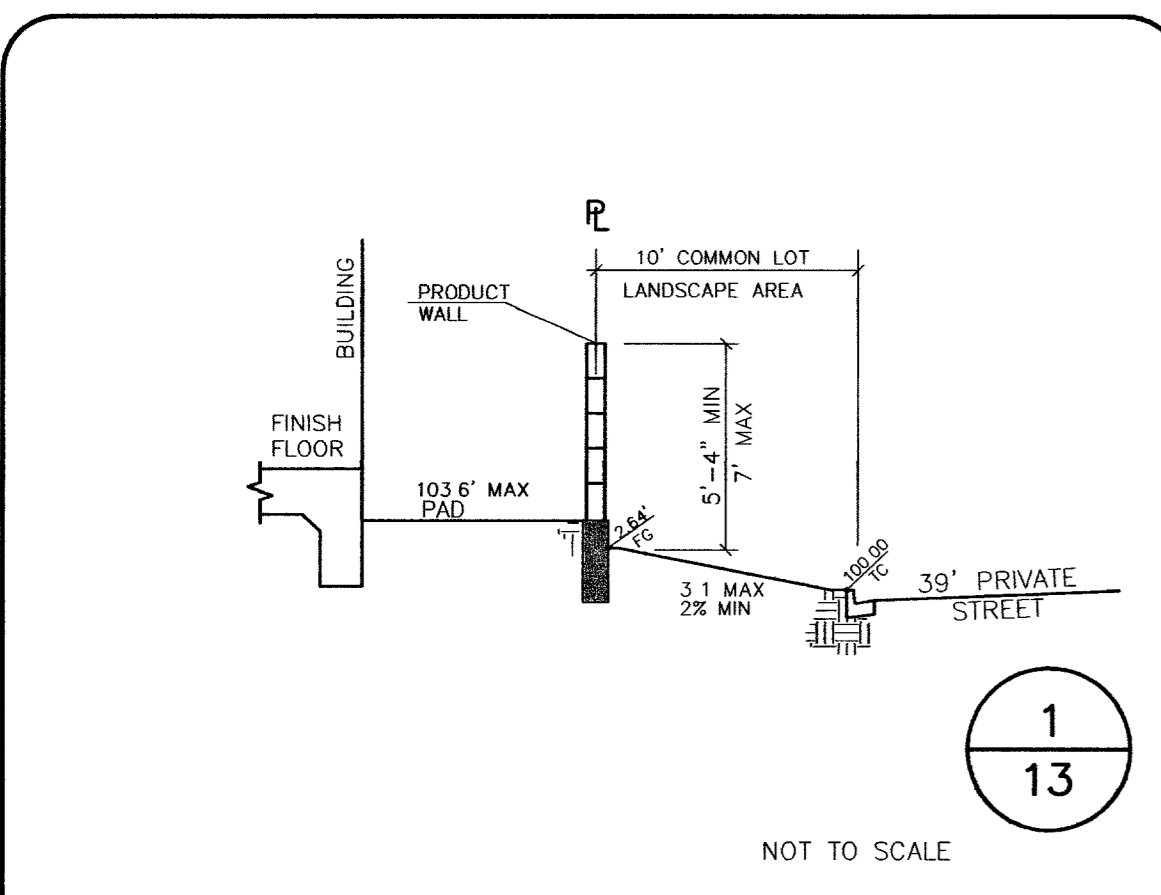


1
13

NOT TO SCALE

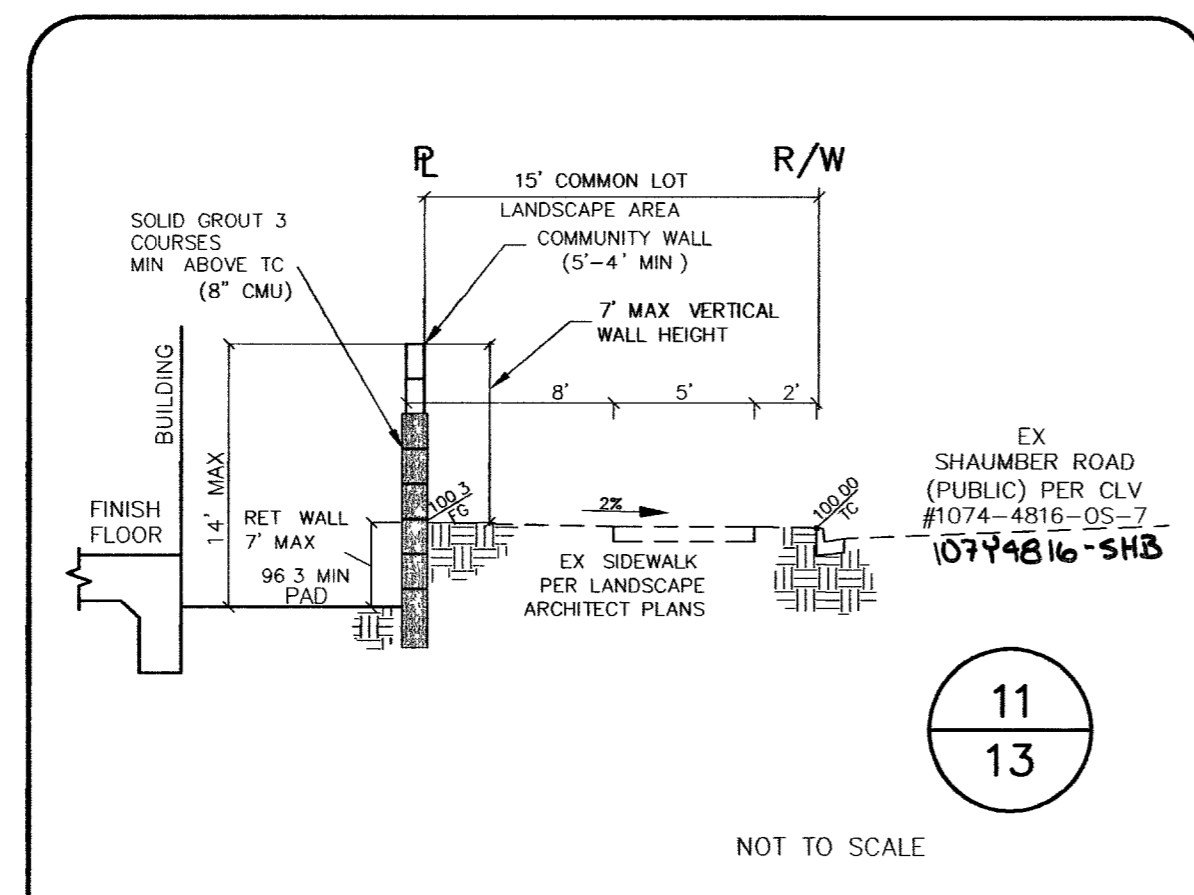


11
13

NOT TO SCALE

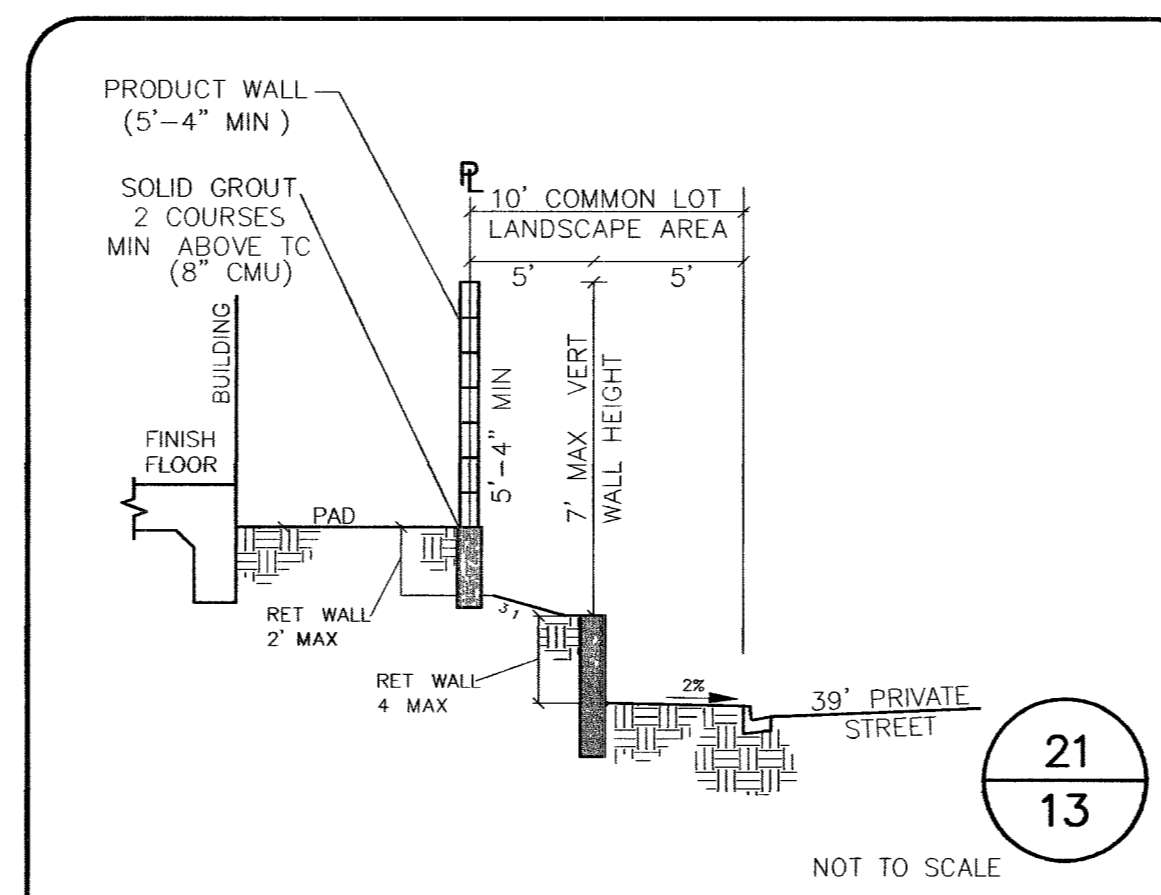


21
13

NOT TO SCALE

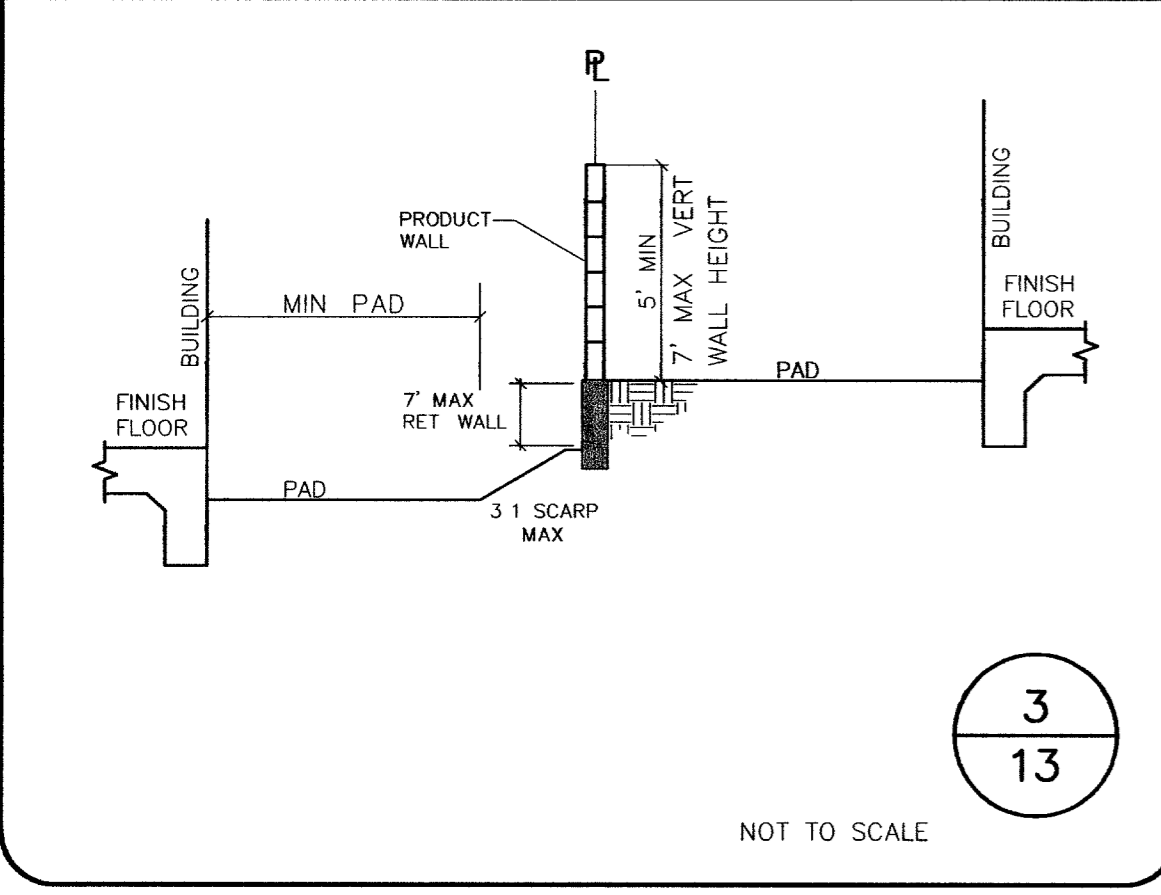


3
13

NOT TO SCALE

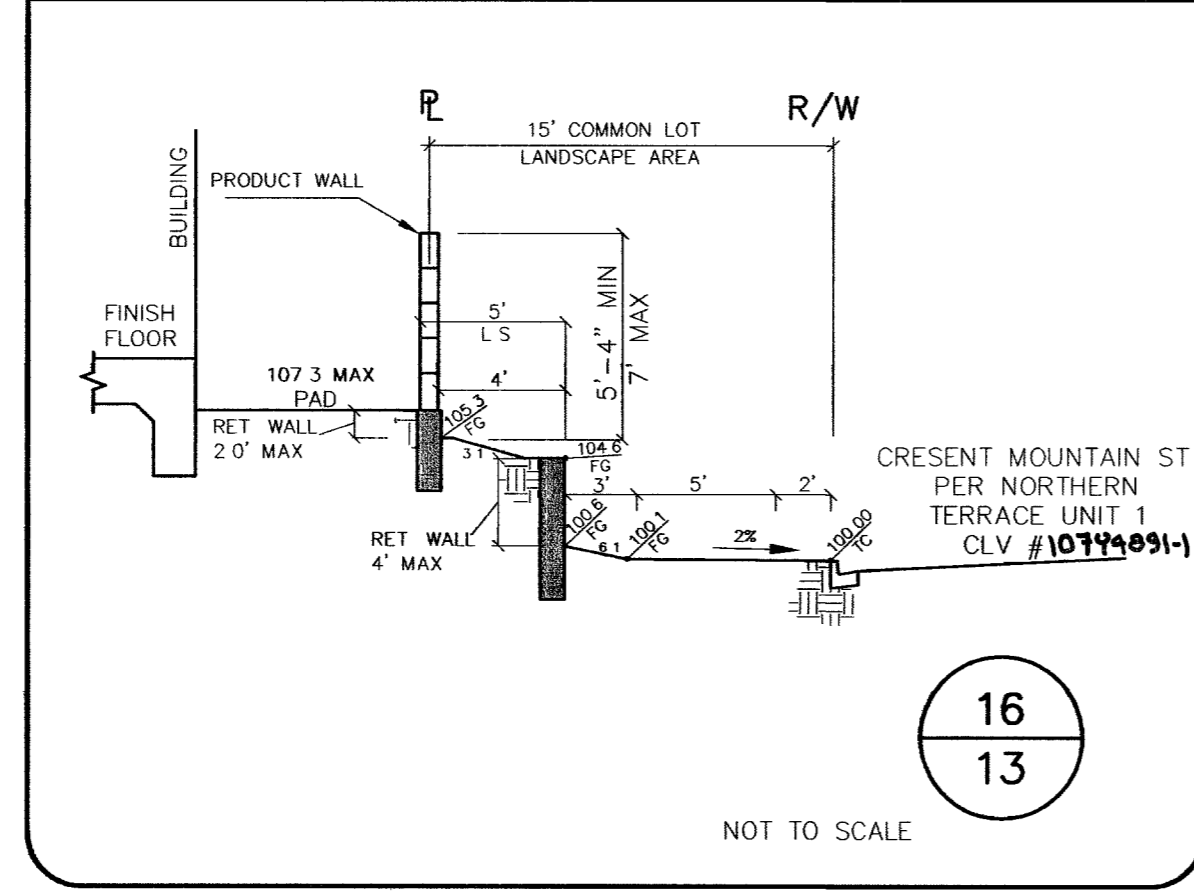


16
13

NOT TO SCALE

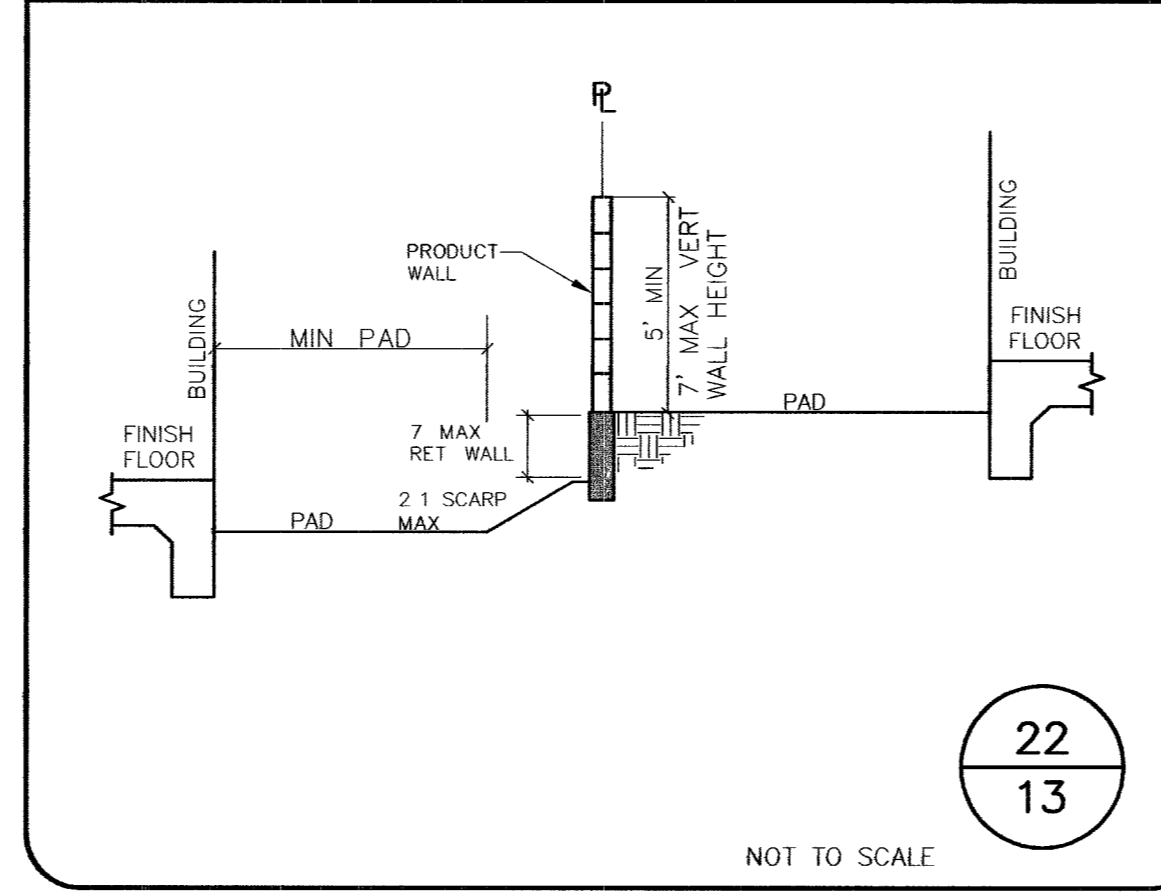

22
13


NOT TO SCALE

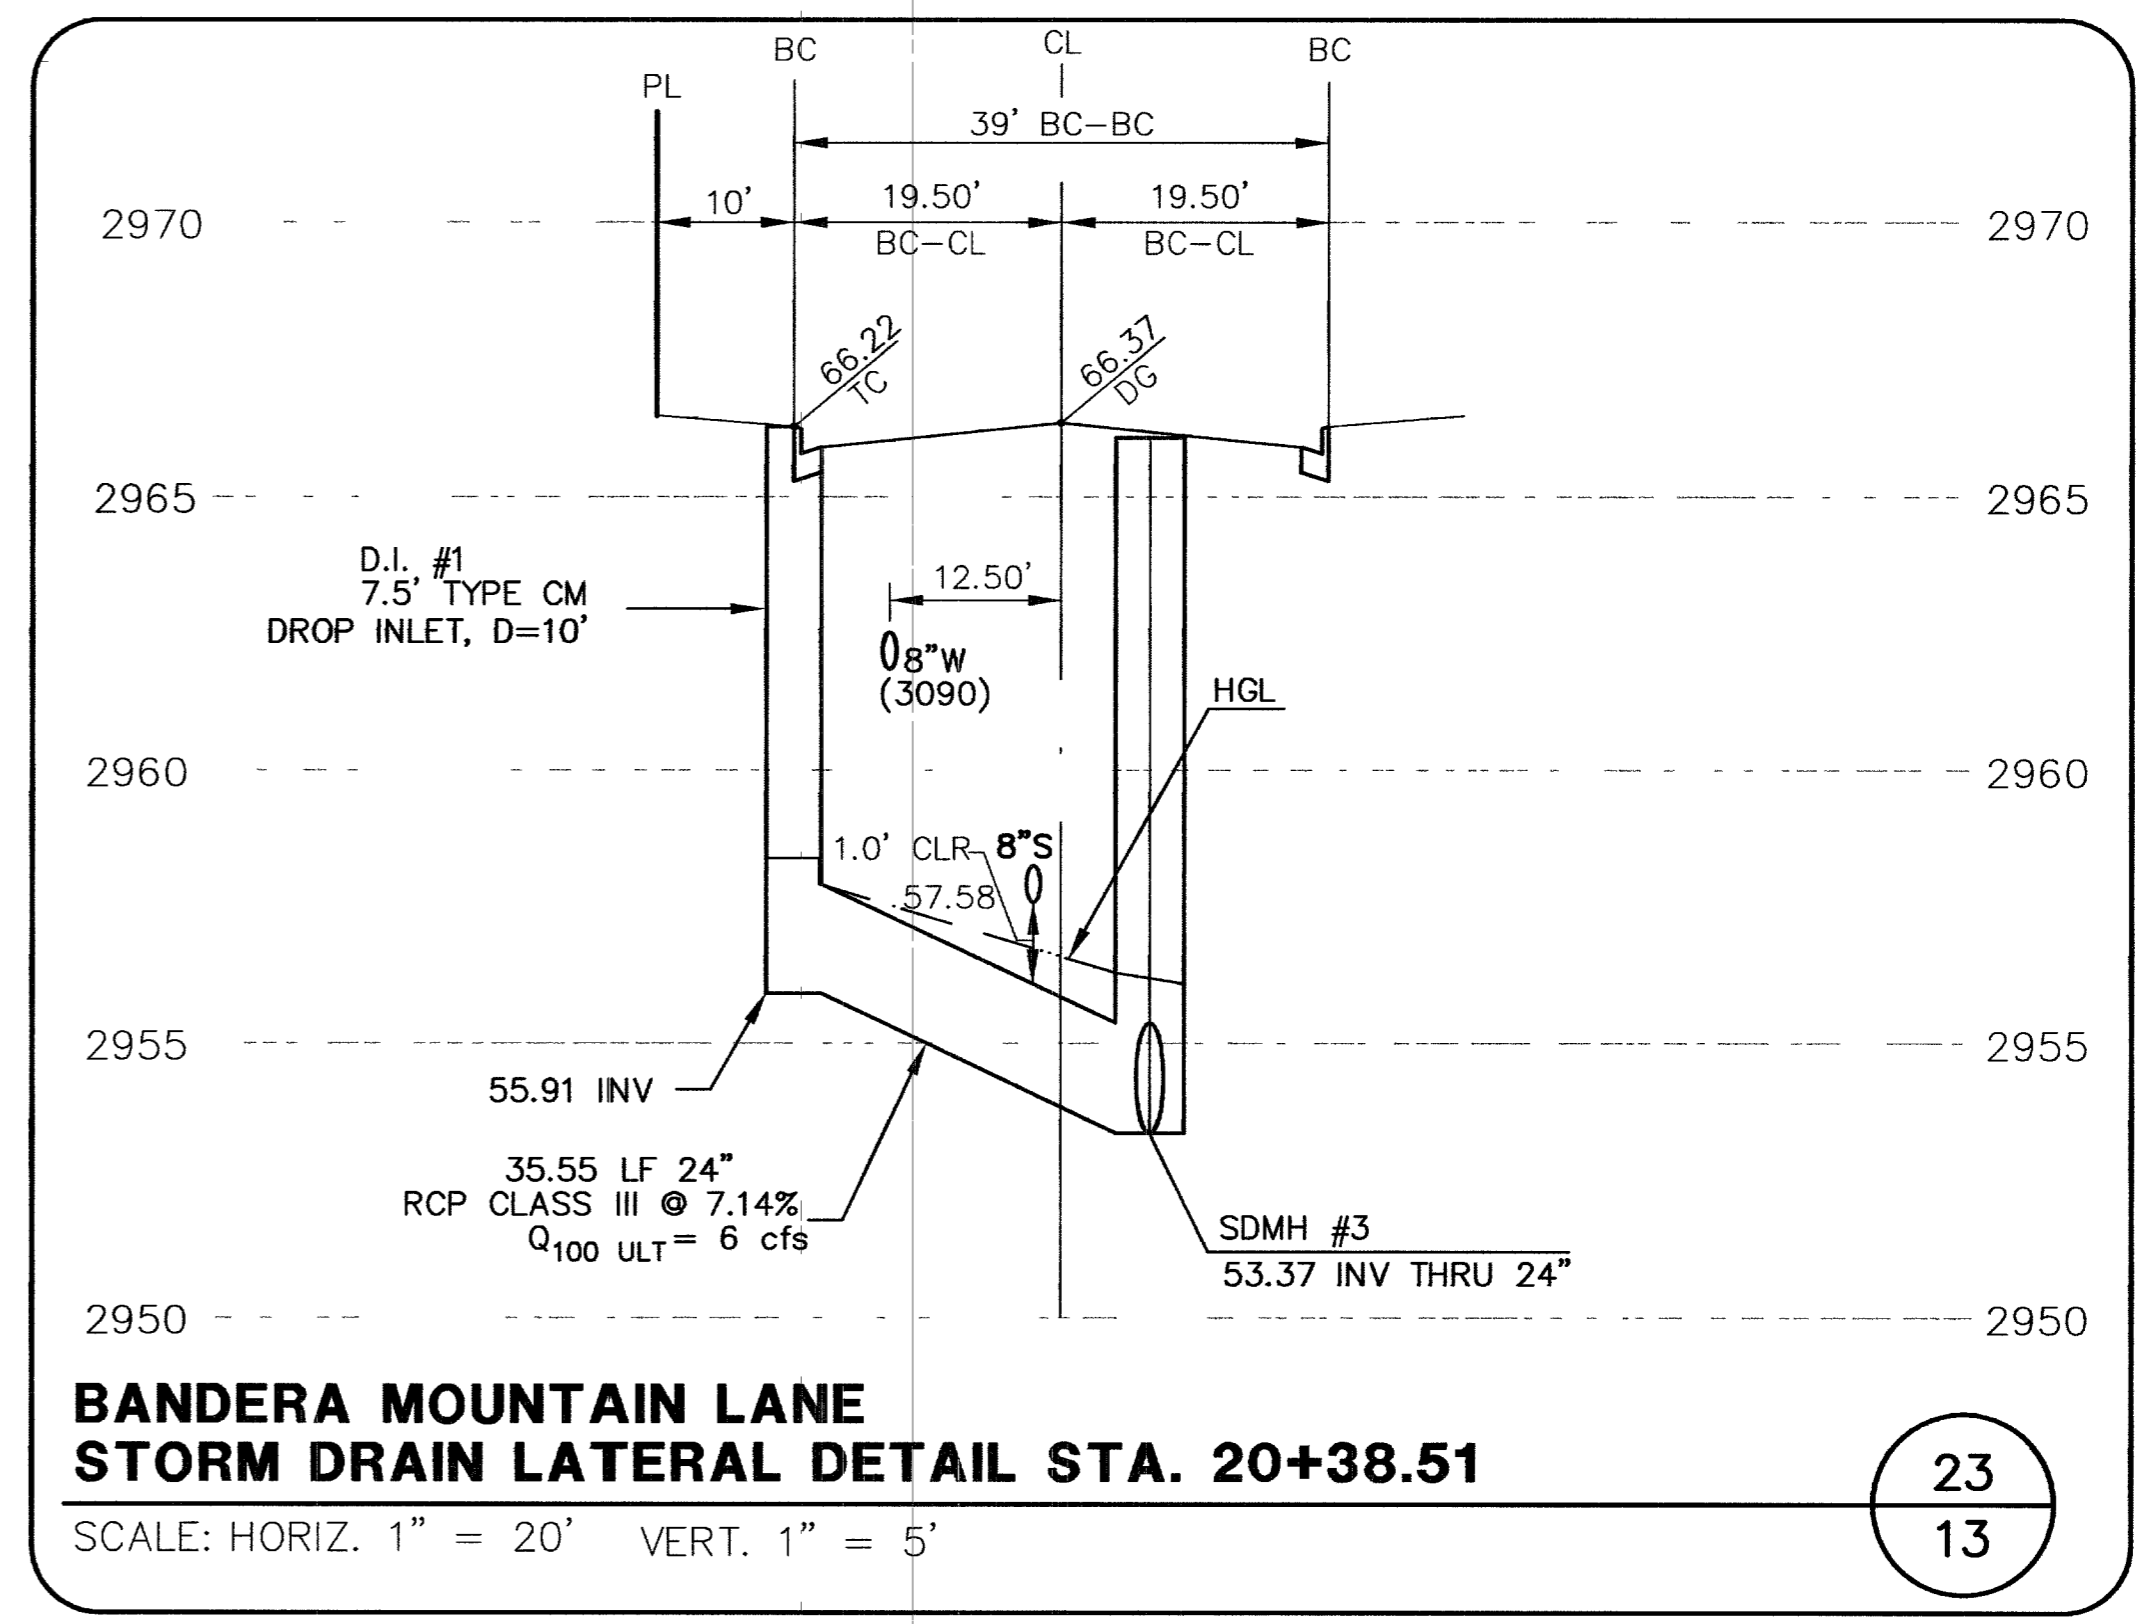

23
13


BANDERA MOUNTAIN LANE STORM DRAIN LATERAL DETAIL STA. 20+38.51

SCALE: HORIZ. 1" = 20' VERT. 1" = 5'

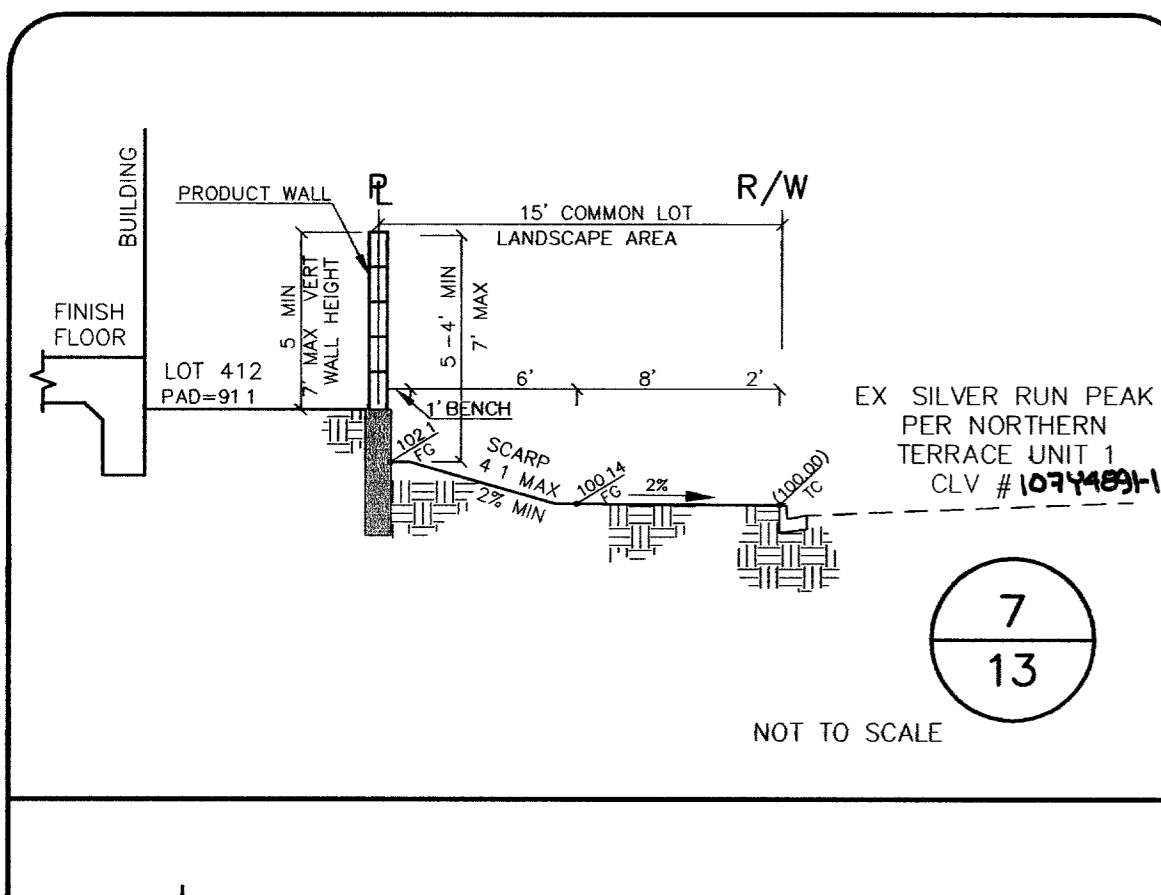


7
13

NOT TO SCALE

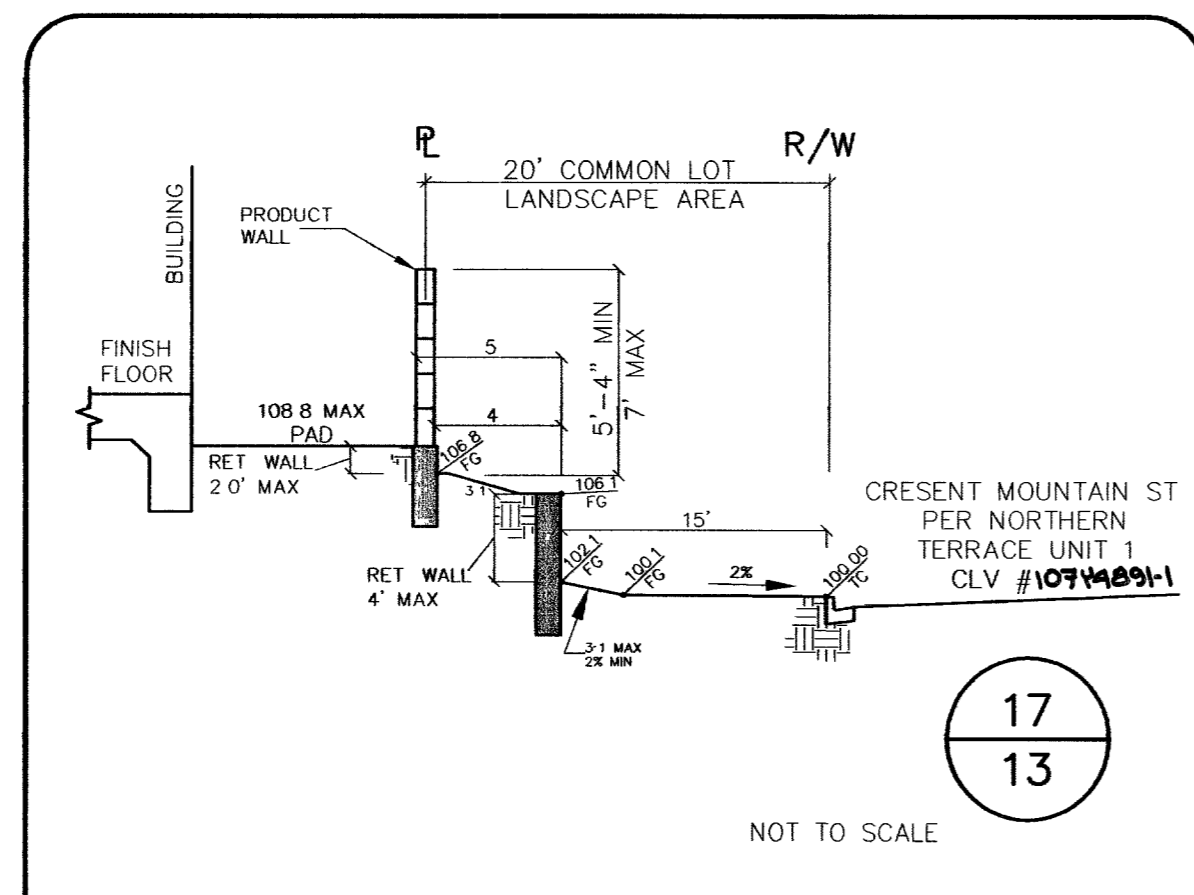


17
13

NOT TO SCALE

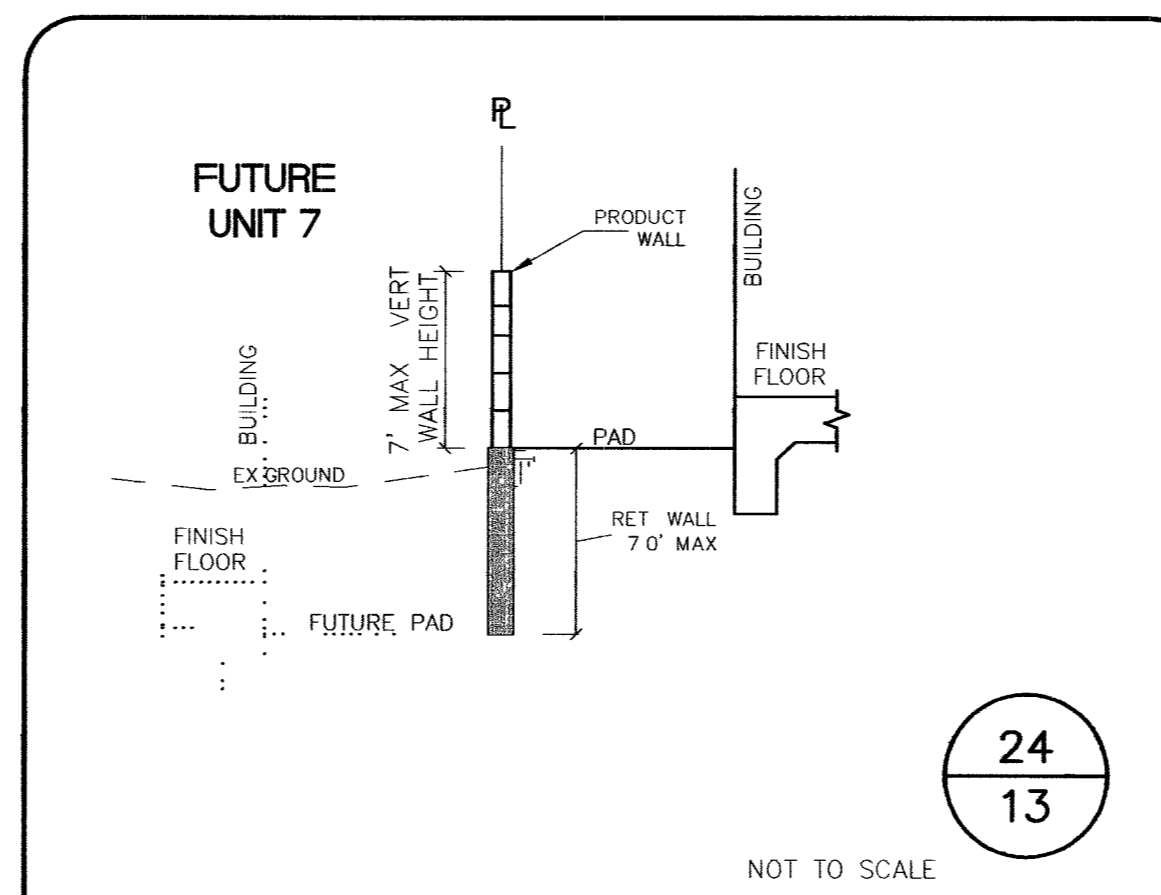


24
13

NOT TO SCALE

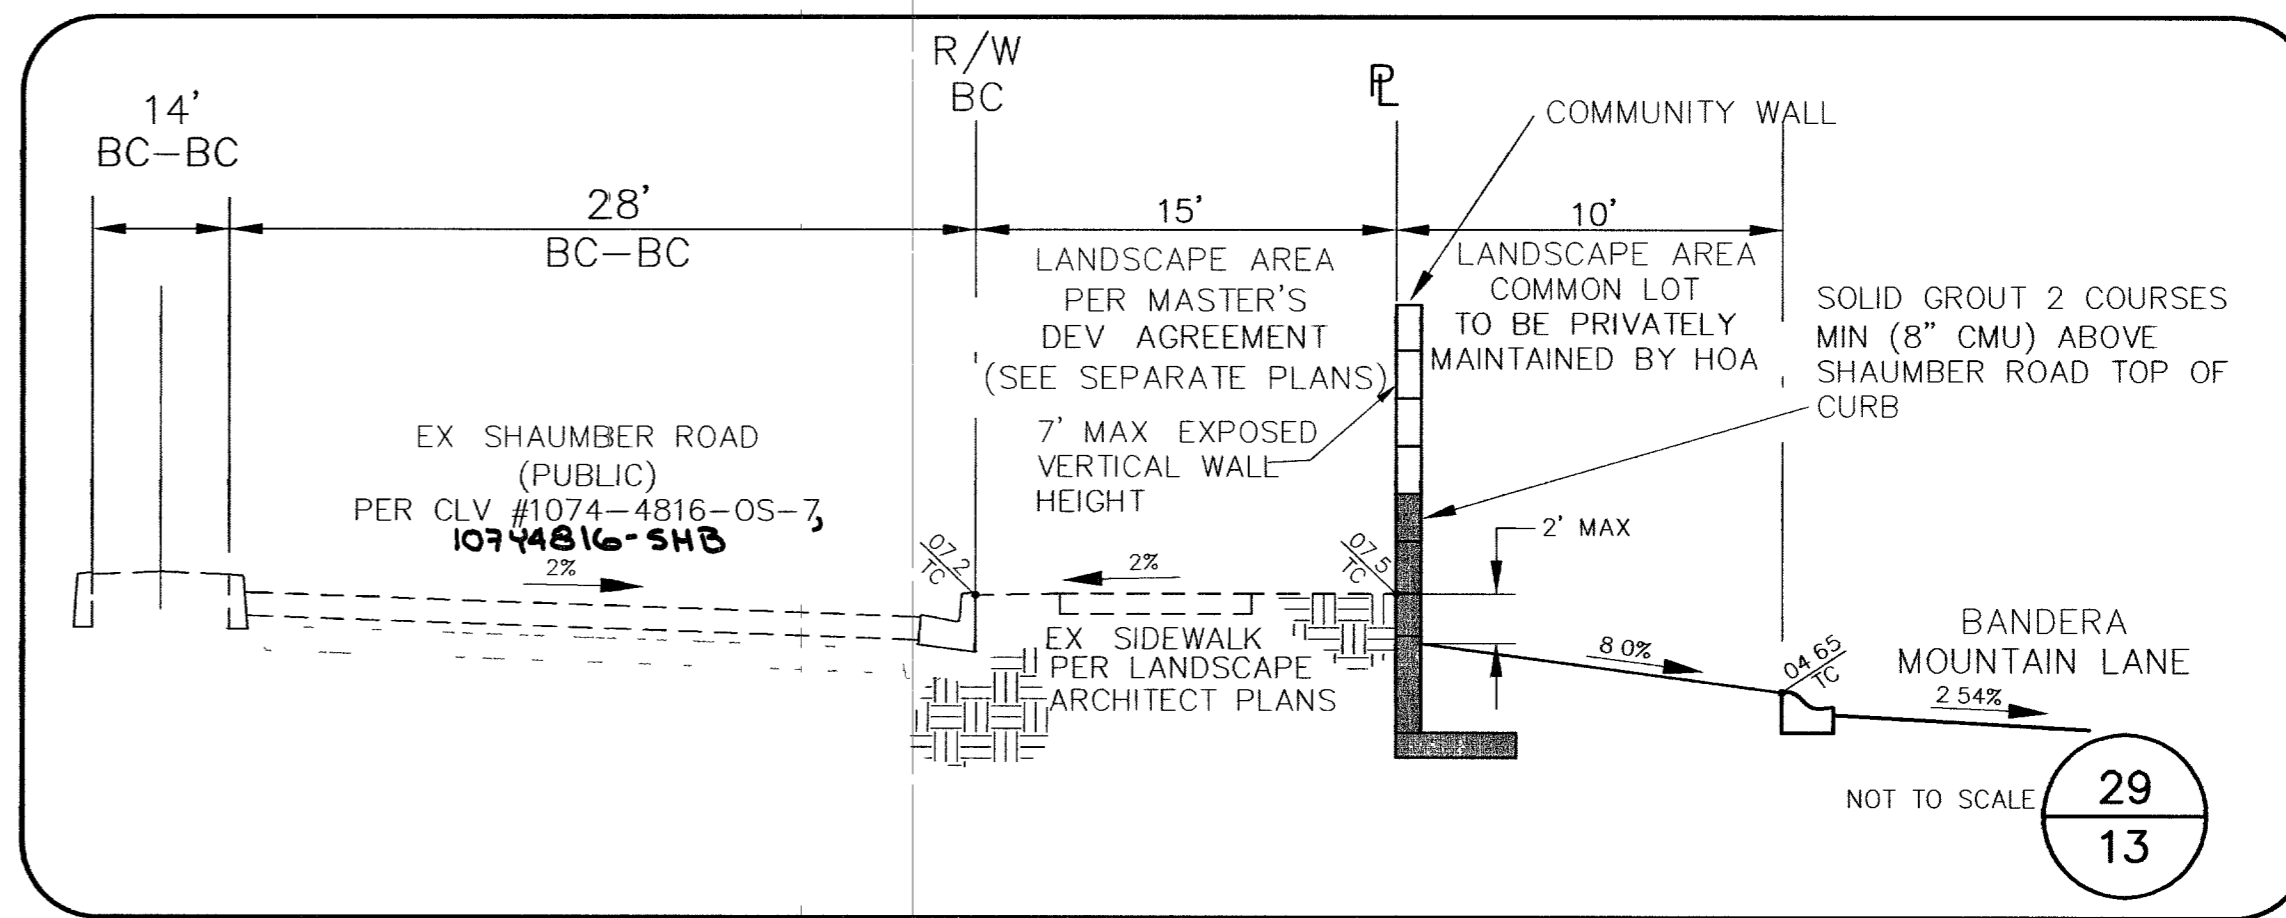


29
13

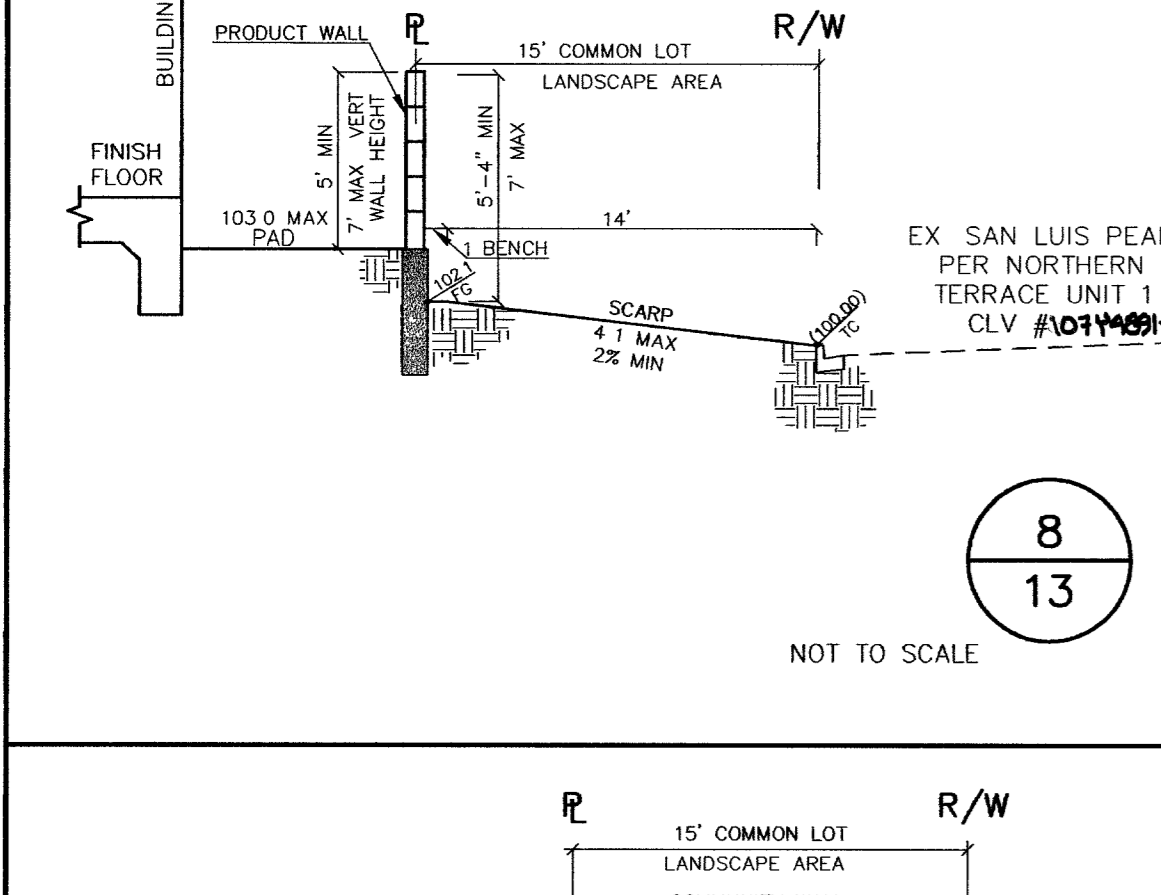


8
13

NOT TO SCALE

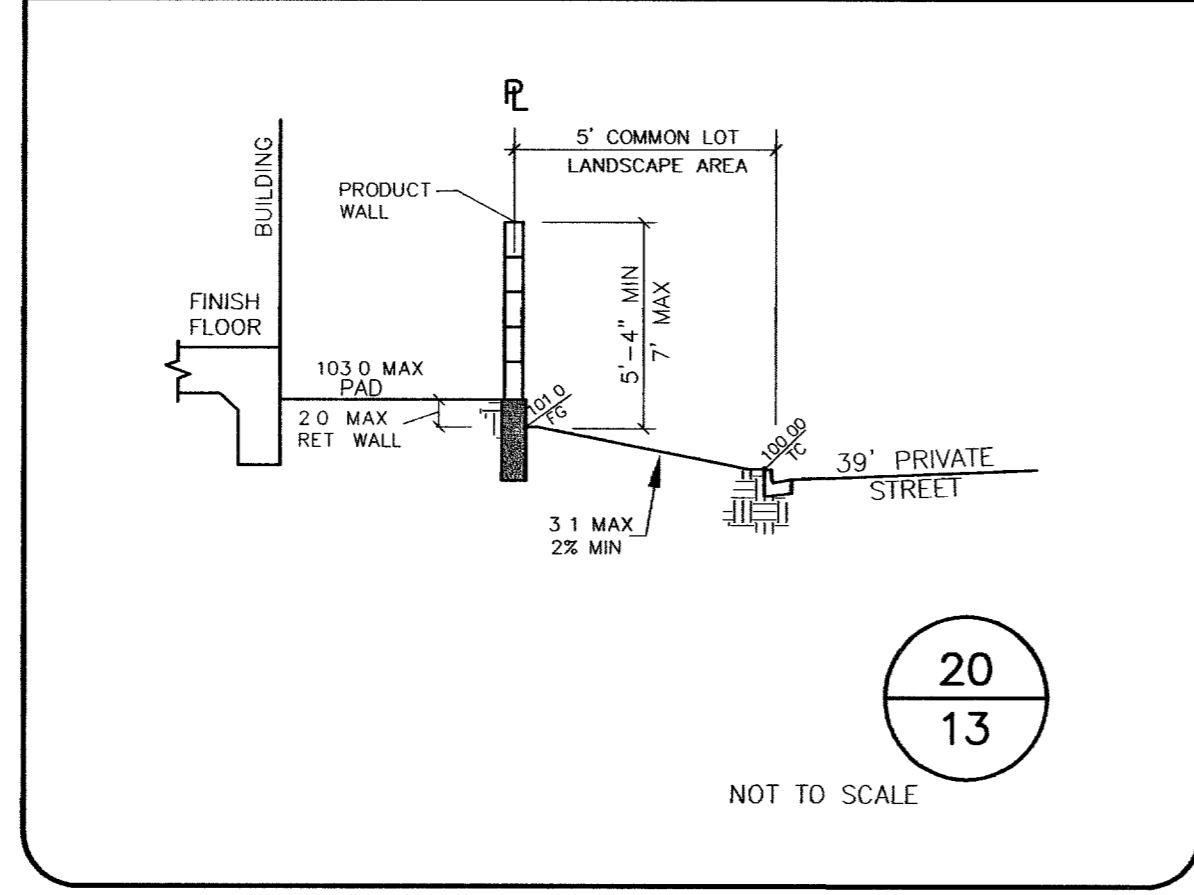


20
13

NOT TO SCALE

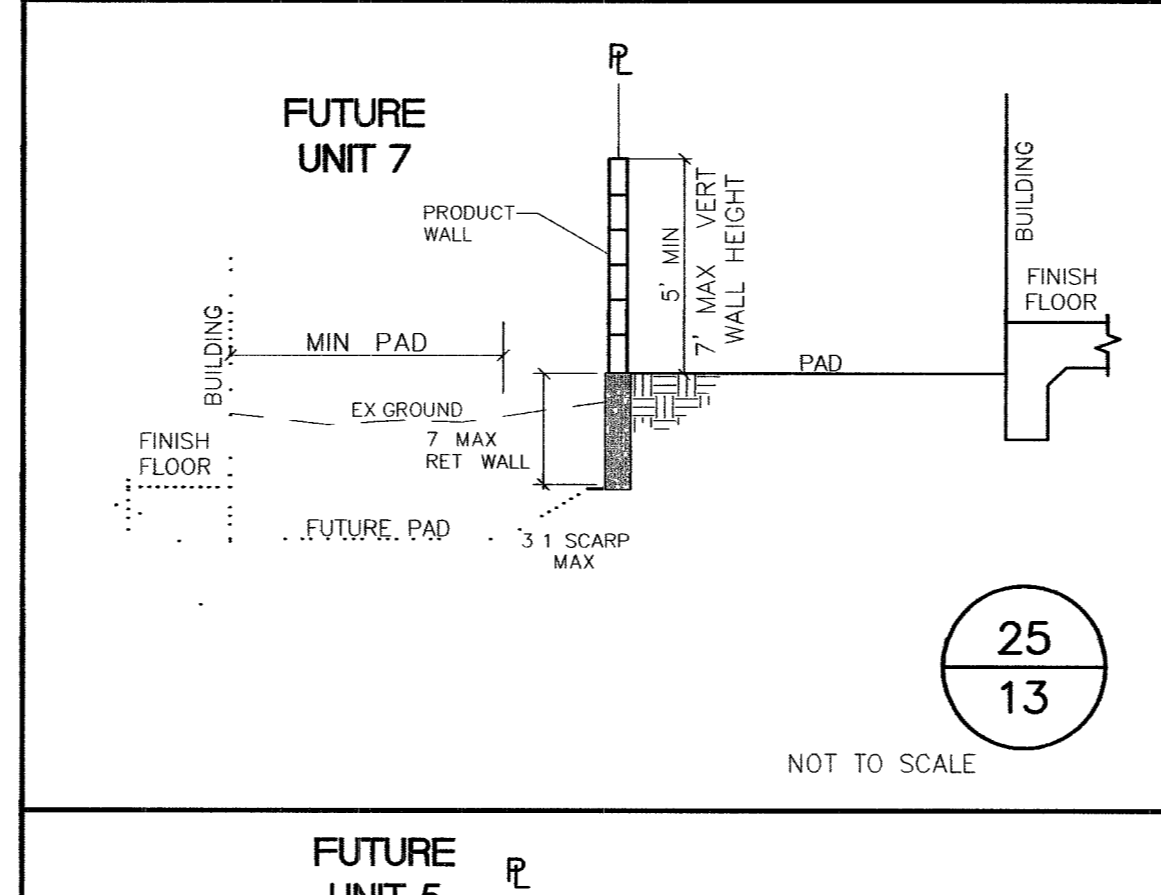

25
13


NOT TO SCALE

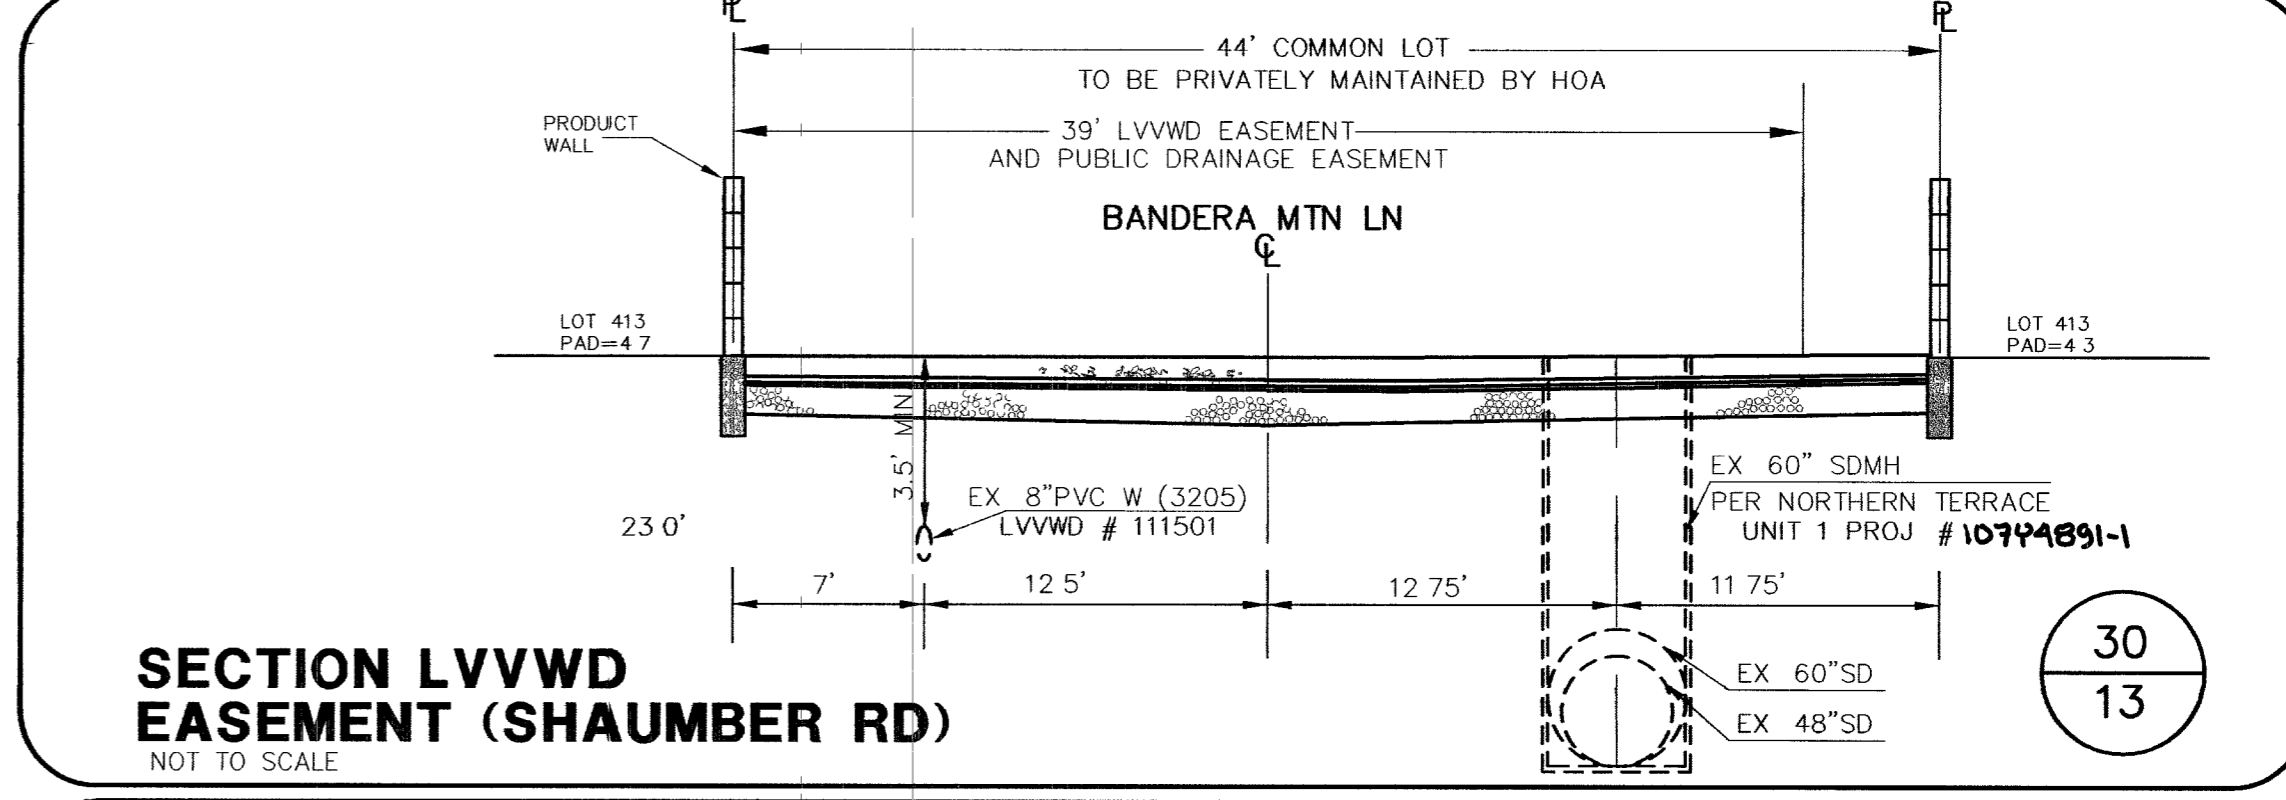

30
13


SECTION LVVWD EASEMENT (SHAUMBER RD)

NOT TO SCALE

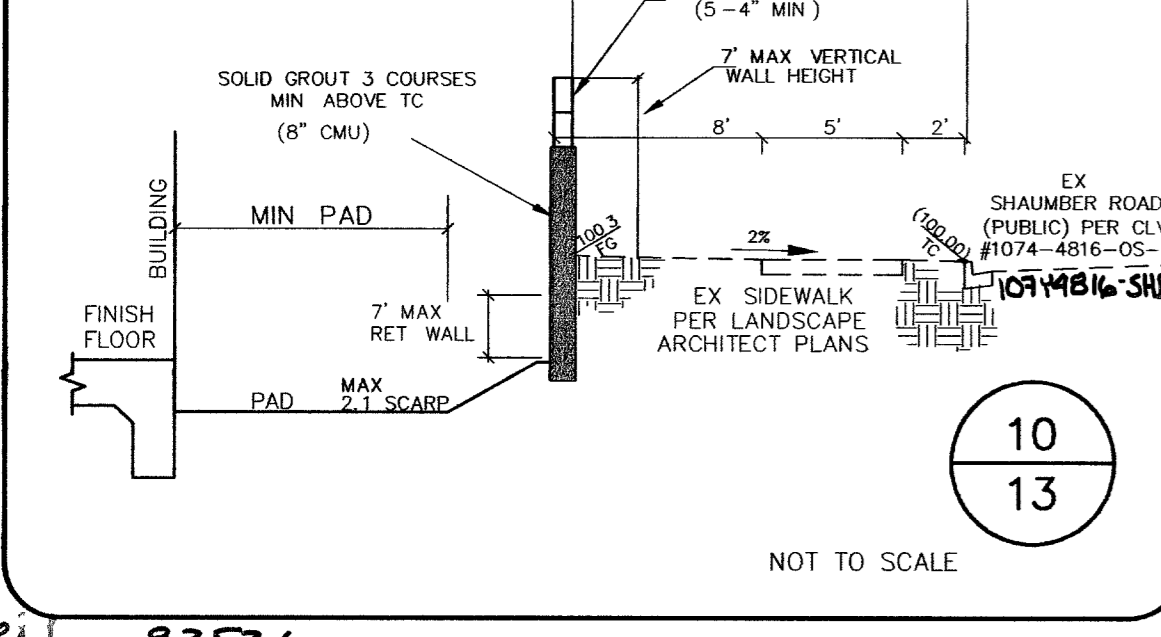


10
13

NOT TO SCALE

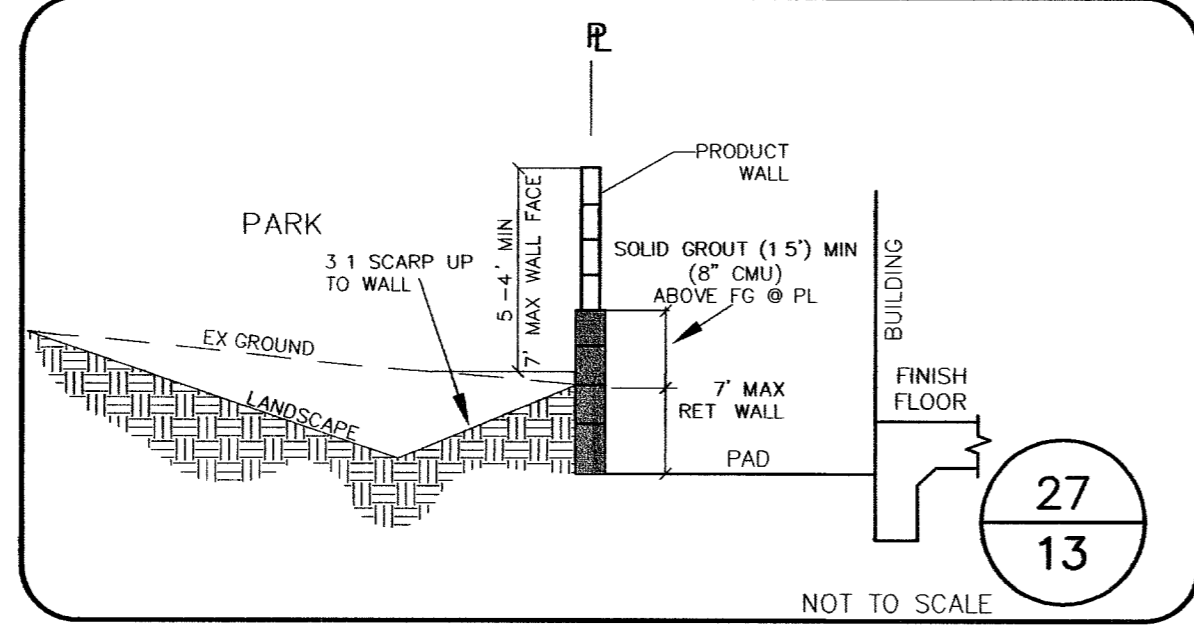


27
13

NOT TO SCALE

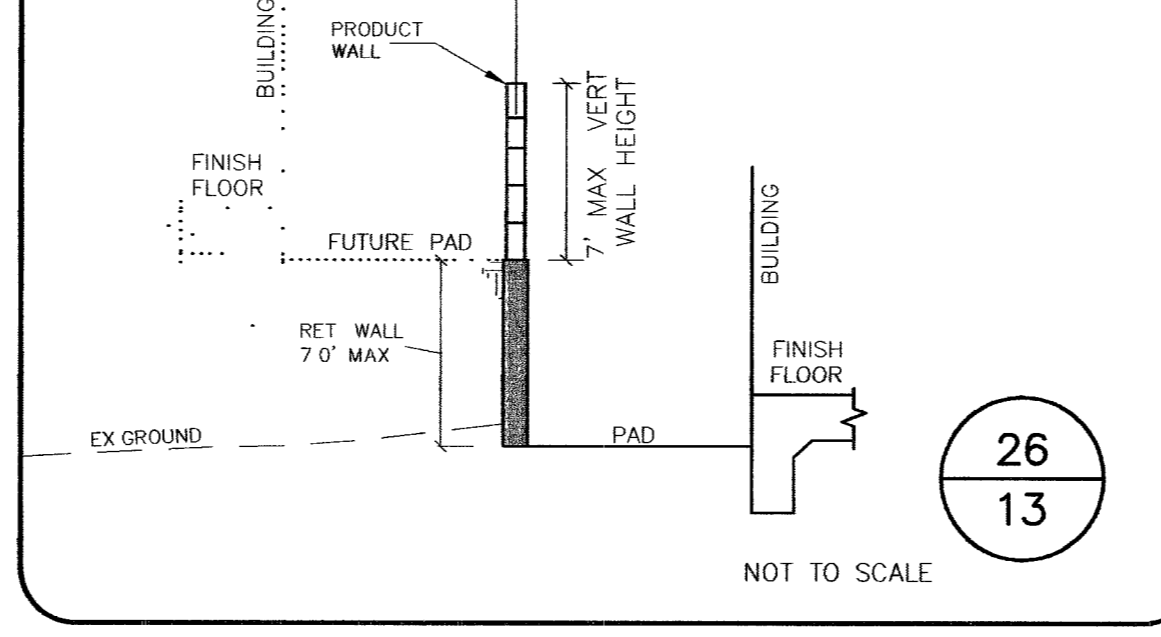

26
13

NOT TO SCALE

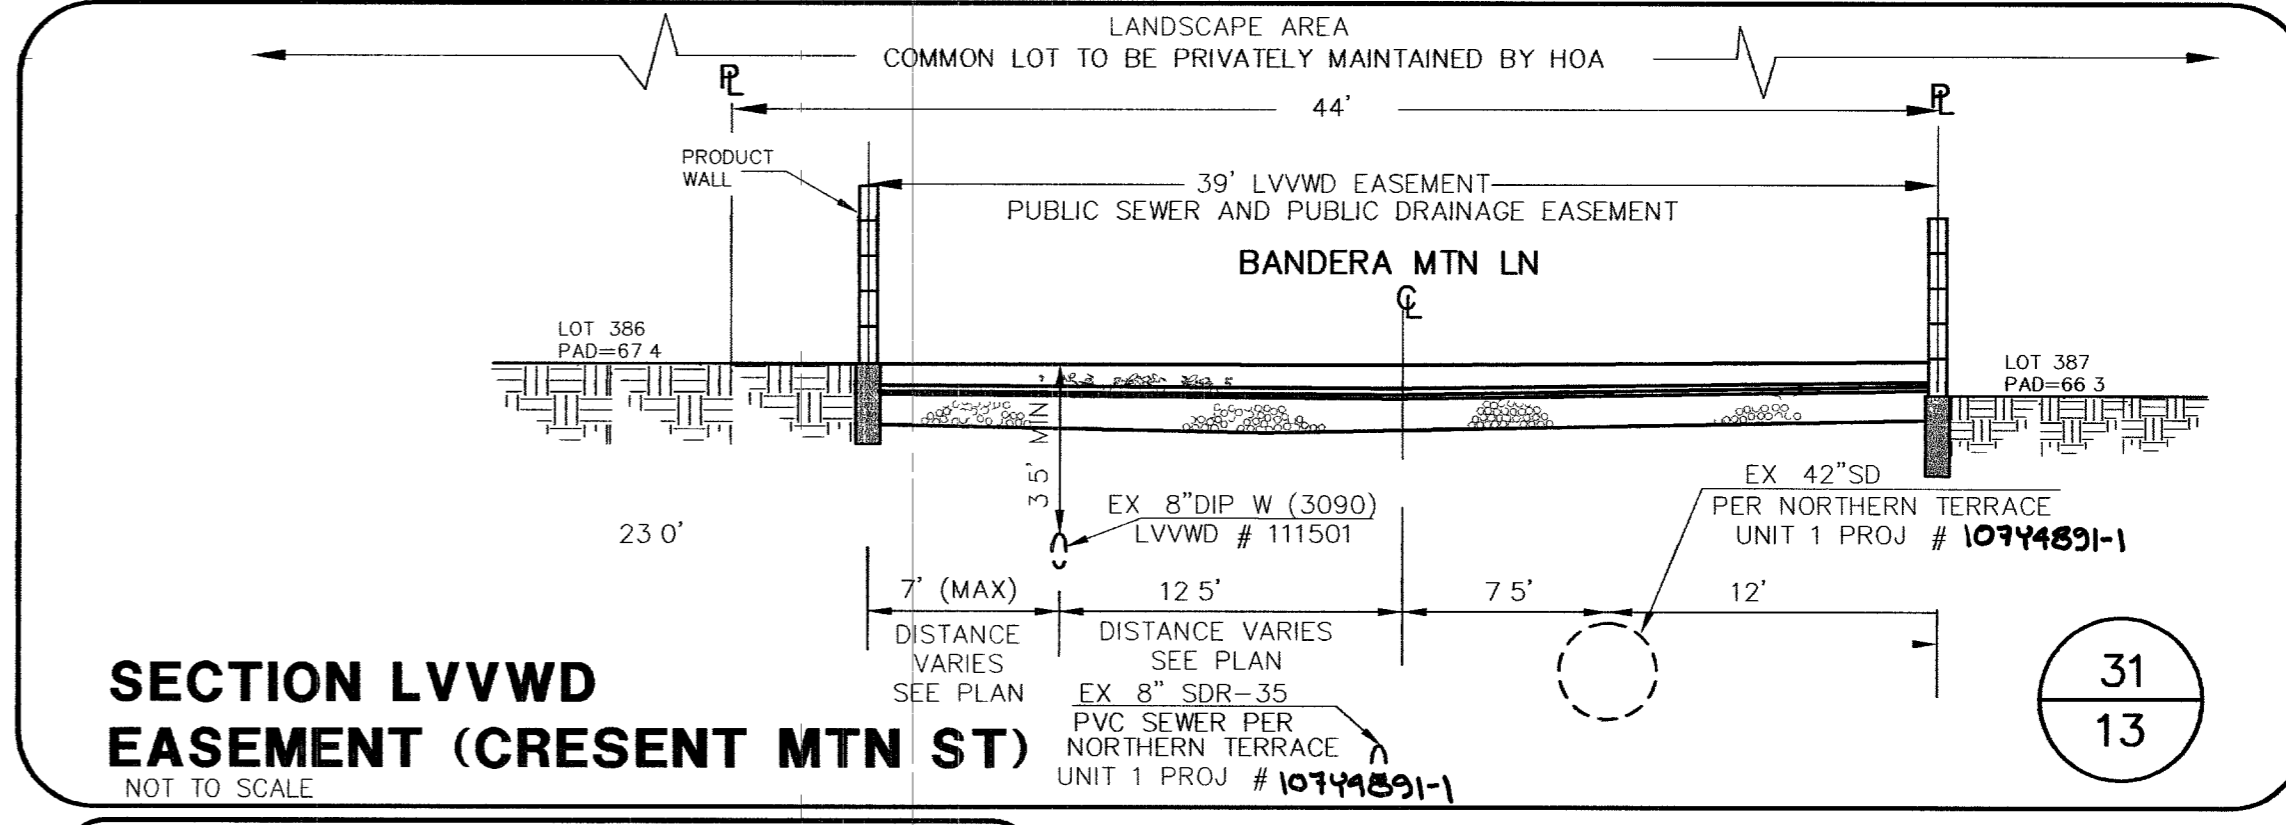

31
13

SECTION LVVWD EASEMENT (CRESENT MTN ST)

NOT TO SCALE

APPROVAL: [Signature]
LAS VEGAS VALLEY WATER DISTRICT
LVVWD # 111607
DATE: 6-15-06

CLV DRAWING NO. 10744891-4

88586 2253