

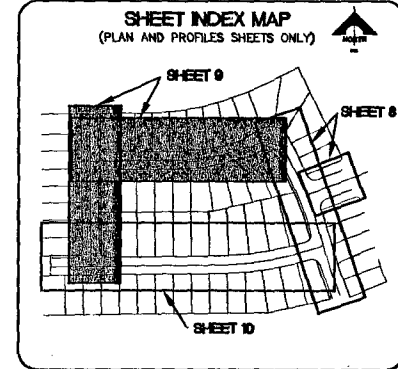
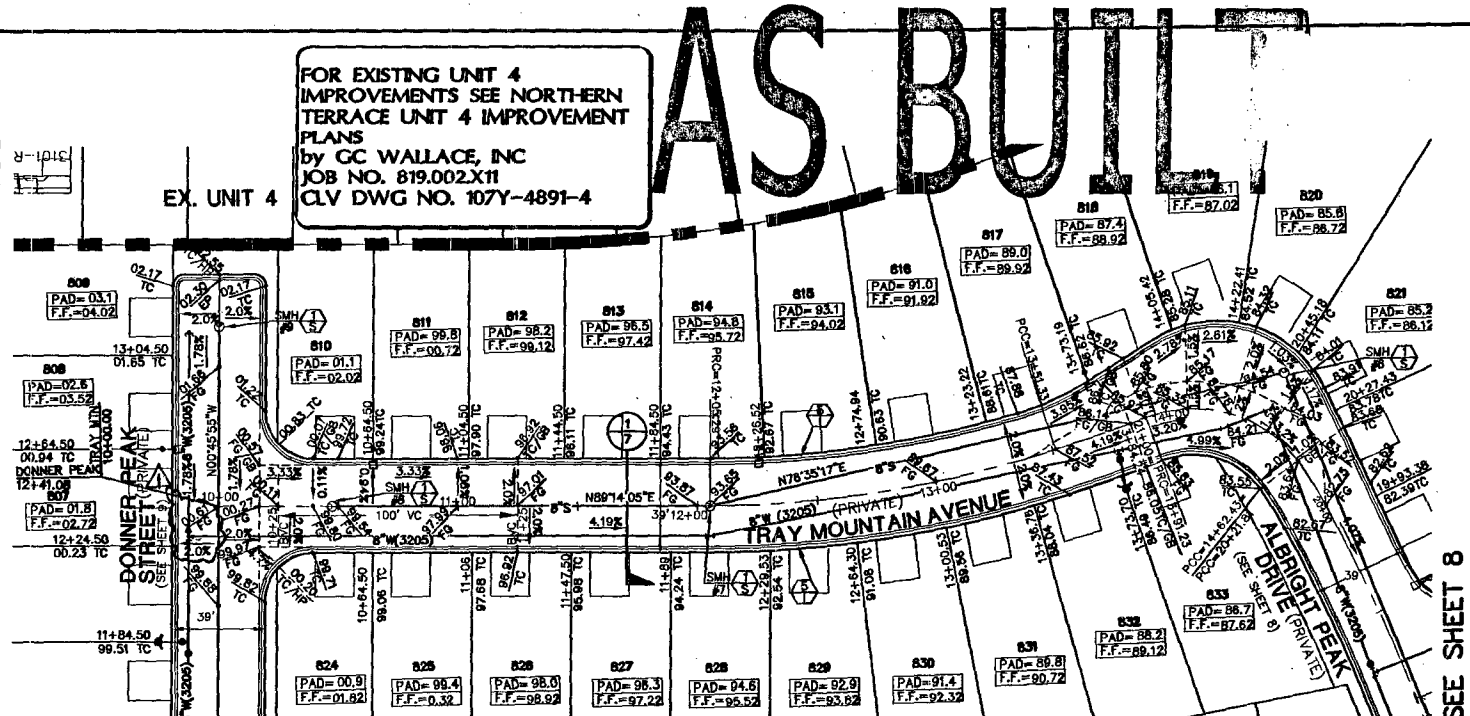


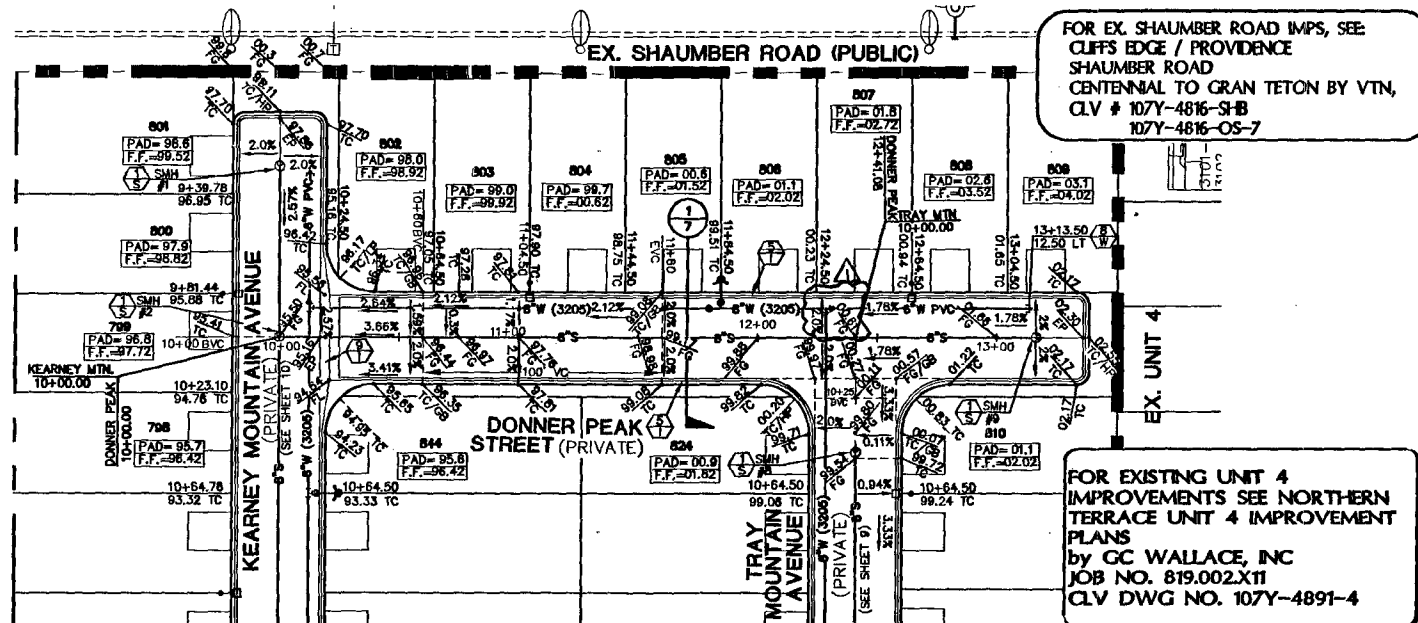

BASIS OF BEARINGS

N 88°21'18" E BEING THE SOUTH LINE OF THE SOUTHWEST QUARTER (SW 1/4) OF THE NORTHEAST QUARTER (NE 1/4) OF SECTION 13, T19S, R59E, M.D.M., AS SHOWN BY RECORD OF SURVEY ON FILE IN THE CLARK COUNTY, NEVADA RECORDER'S OFFICE IN FILE 124 OF SURVEYS AT PAGE 94.

BENCHMARK		
DESC.	NAVD 88 DATUM	NAVD 88 DATUM
BLV99 RIVET AND PLATE IN CONCRETE CYLINDER AT THE NORTHWEST CORNER OF HUALAPAI WAY AND FARM ROAD.	2560.79 (FEET)	871.971 (METERS)

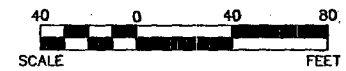

NOTE ON PRIVATE STREETS

PRIVATE STREETS ARE P.U.E.'S, CLV PUBLIC SEWER EASEMENTS, AND PUBLIC DRAINAGE EASEMENTS TO BE PRIVATELY MAINTAINED.

NOTES:

- SEE SHEET C-2 FOR CONSTRUCTION NOTES.
- SEE SHEET C-5 FOR LINE AND CURVE TABLE SHOWING FOR CENTERLINE BEARING/DIRECTION AND BACK OF CURB INFORMATION.

Call before you Dig.

1-702-455-7511

1-702-229-6811

Call before you Dig.

1-800-227-2600

UNDERGROUND SERVICE ALERT (USA)

CALL BEFORE YOU DO OVERHEAD

1-702-227-2929



APPROVAL

LVWD NO. 111780

7-25-06

DATE

LAS VEGAS VALLEY WATER DISTRICT

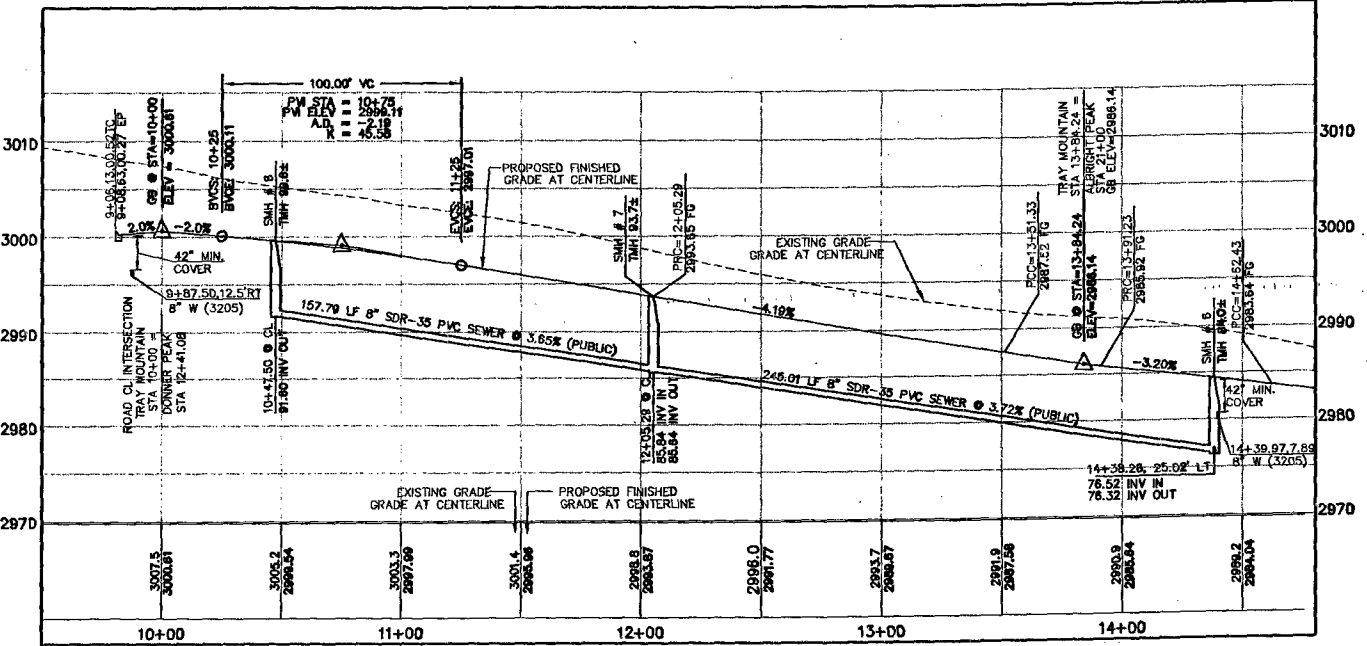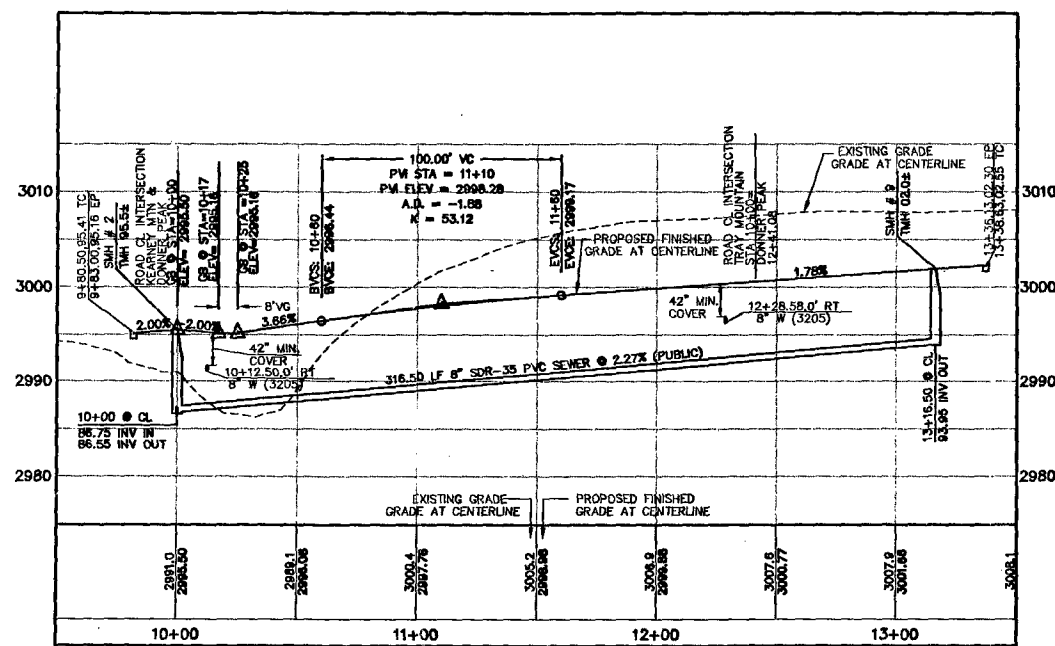

DATE: 5/1/06

DESIGNER: G.C. WALLACE, INC.

CHECKED: G.C. WALLACE, INC.

ISSUE DATE: 7-25-06

ISSUE EDITOR: G.C. WALLACE, INC.

PLOT DATE: 05-17-06

PLOT TIME: 10:19:43

G.C. WALLACE, INC.

Engineers/Planners/Surveyors

1545 N. RAYMOND AVE. SUITE 200

LAS VEGAS, NV 89104

TELEPHONE: (702) 894-2000 FAX: (702) 894-2000

E-MAIL: gwallace@wallaceinc.com

MERTAGE CORPORATION

NORTHERN TERRACE - UNIT 7

DONNER PEAK STREET AND

TRAY MOUNTAIN AVENUE PLAN AND PROFILE

CLV DRAWING NO. 107Y4891-7

JOB NO. 819.002.X11