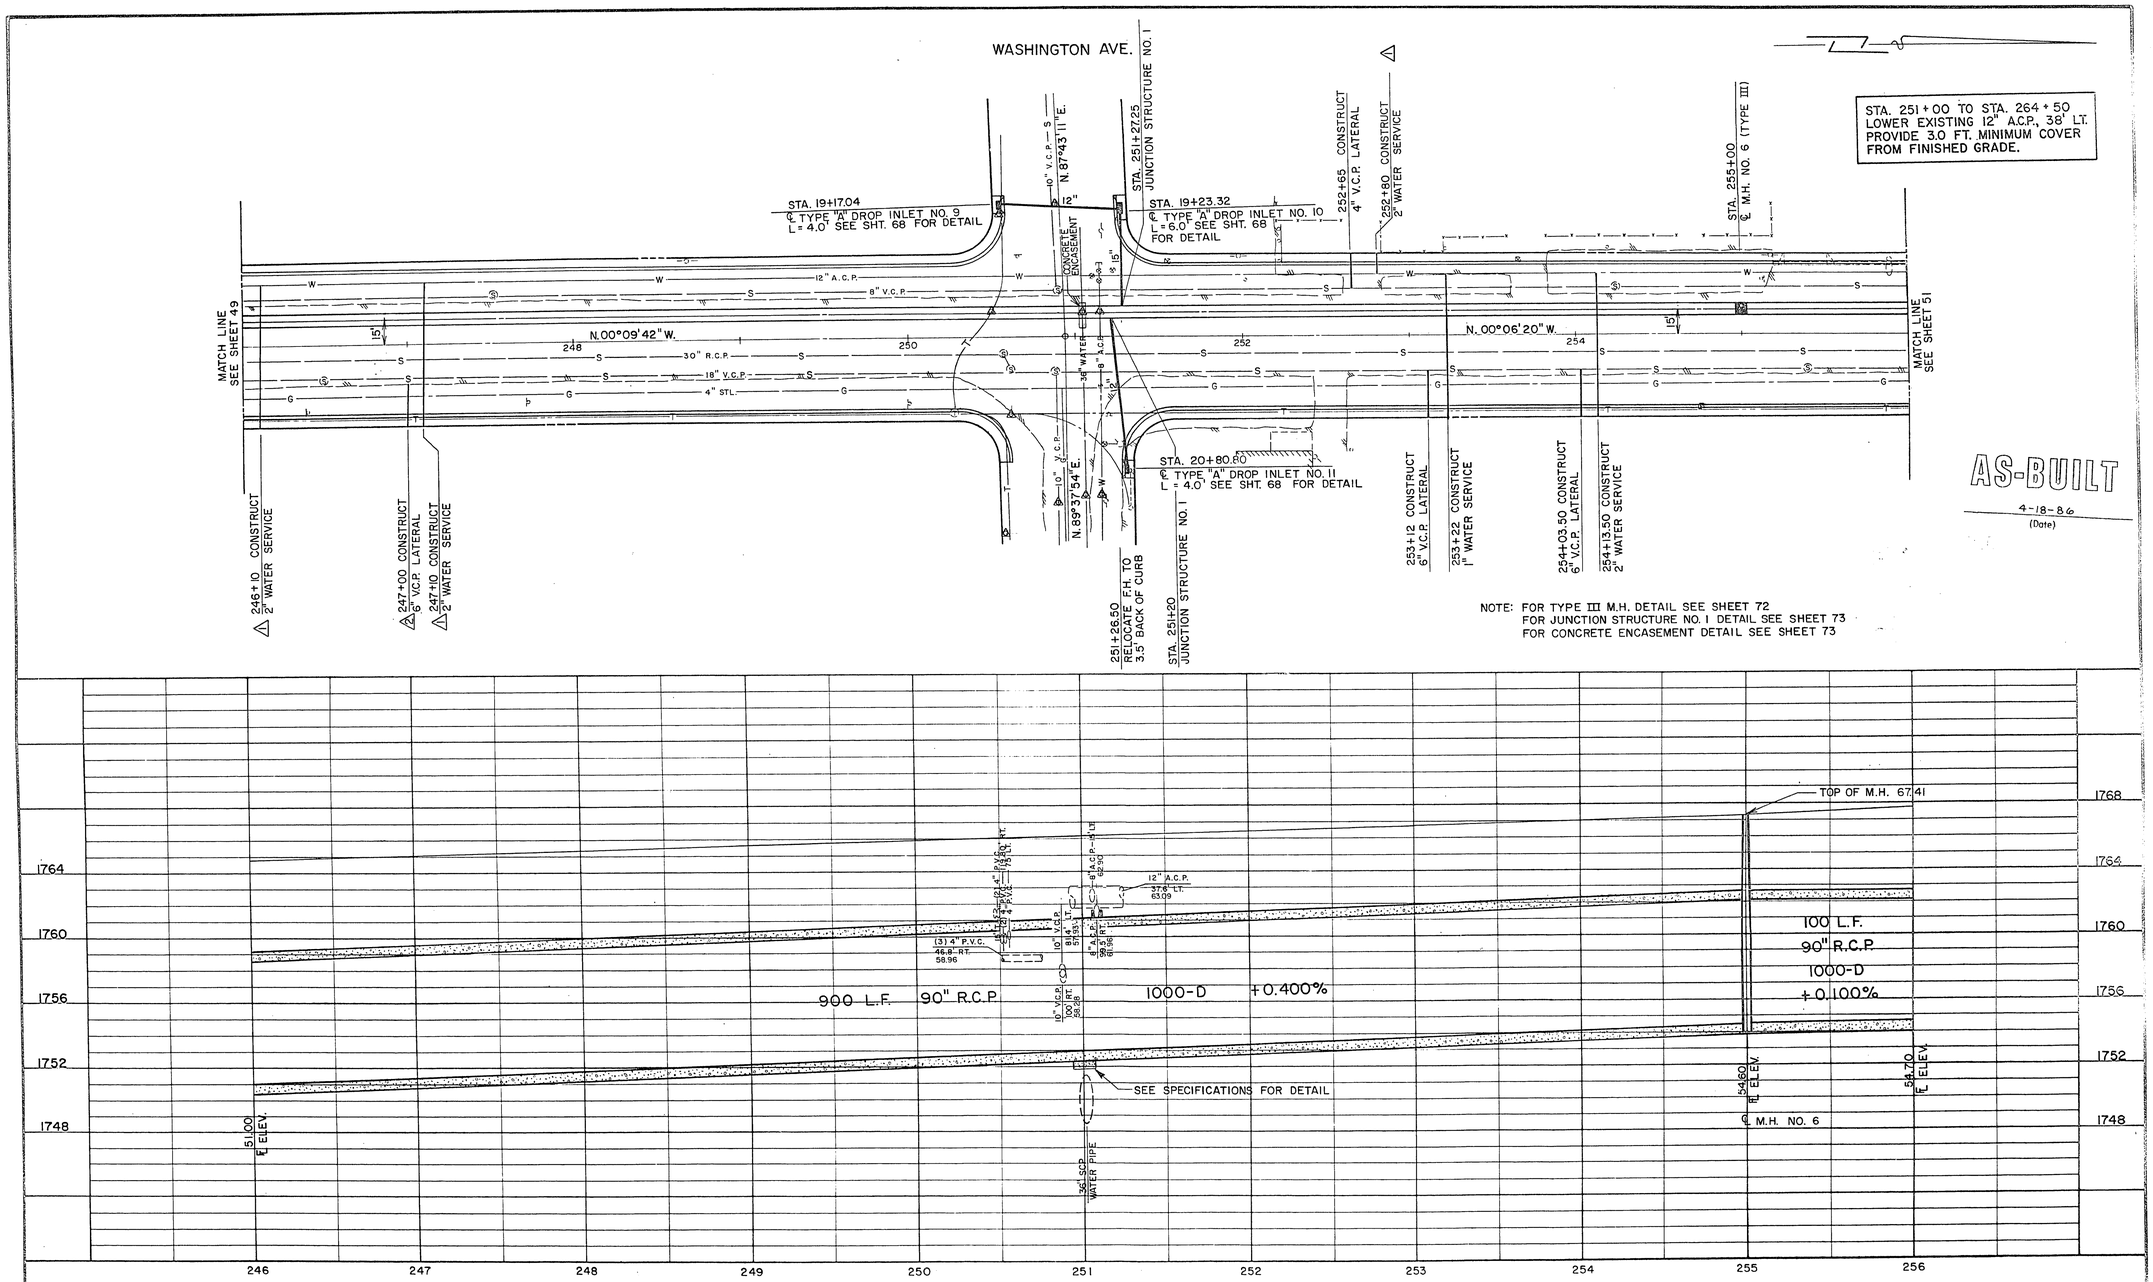

REV. NO.	DATE	DESCRIPTION	APPROVED
2	3/28/86	ADDED SEWER LATERAL	GRB
1	3/28/86	ADDED WATER SERVICE'S	GRB

DESIGNED BY: Kent B. Anderson
DRAWN BY: GCS
CHECKED BY: R. Weinberg

CLARK COUNTY NEVADA
DEPARTMENT OF PUBLIC WORKS

NELLIS BOULEVARD
STORM DRAIN PLAN
STA. 246+00 TO STA. 256+00

SCALE: HORZ.: 1" = 40' VERT.: 1" = 4'
PROJECT NO.: B810563
B810233

DRAWING NO. L-1017
SHT. 50 OF 92

107-V1789

21-3-42