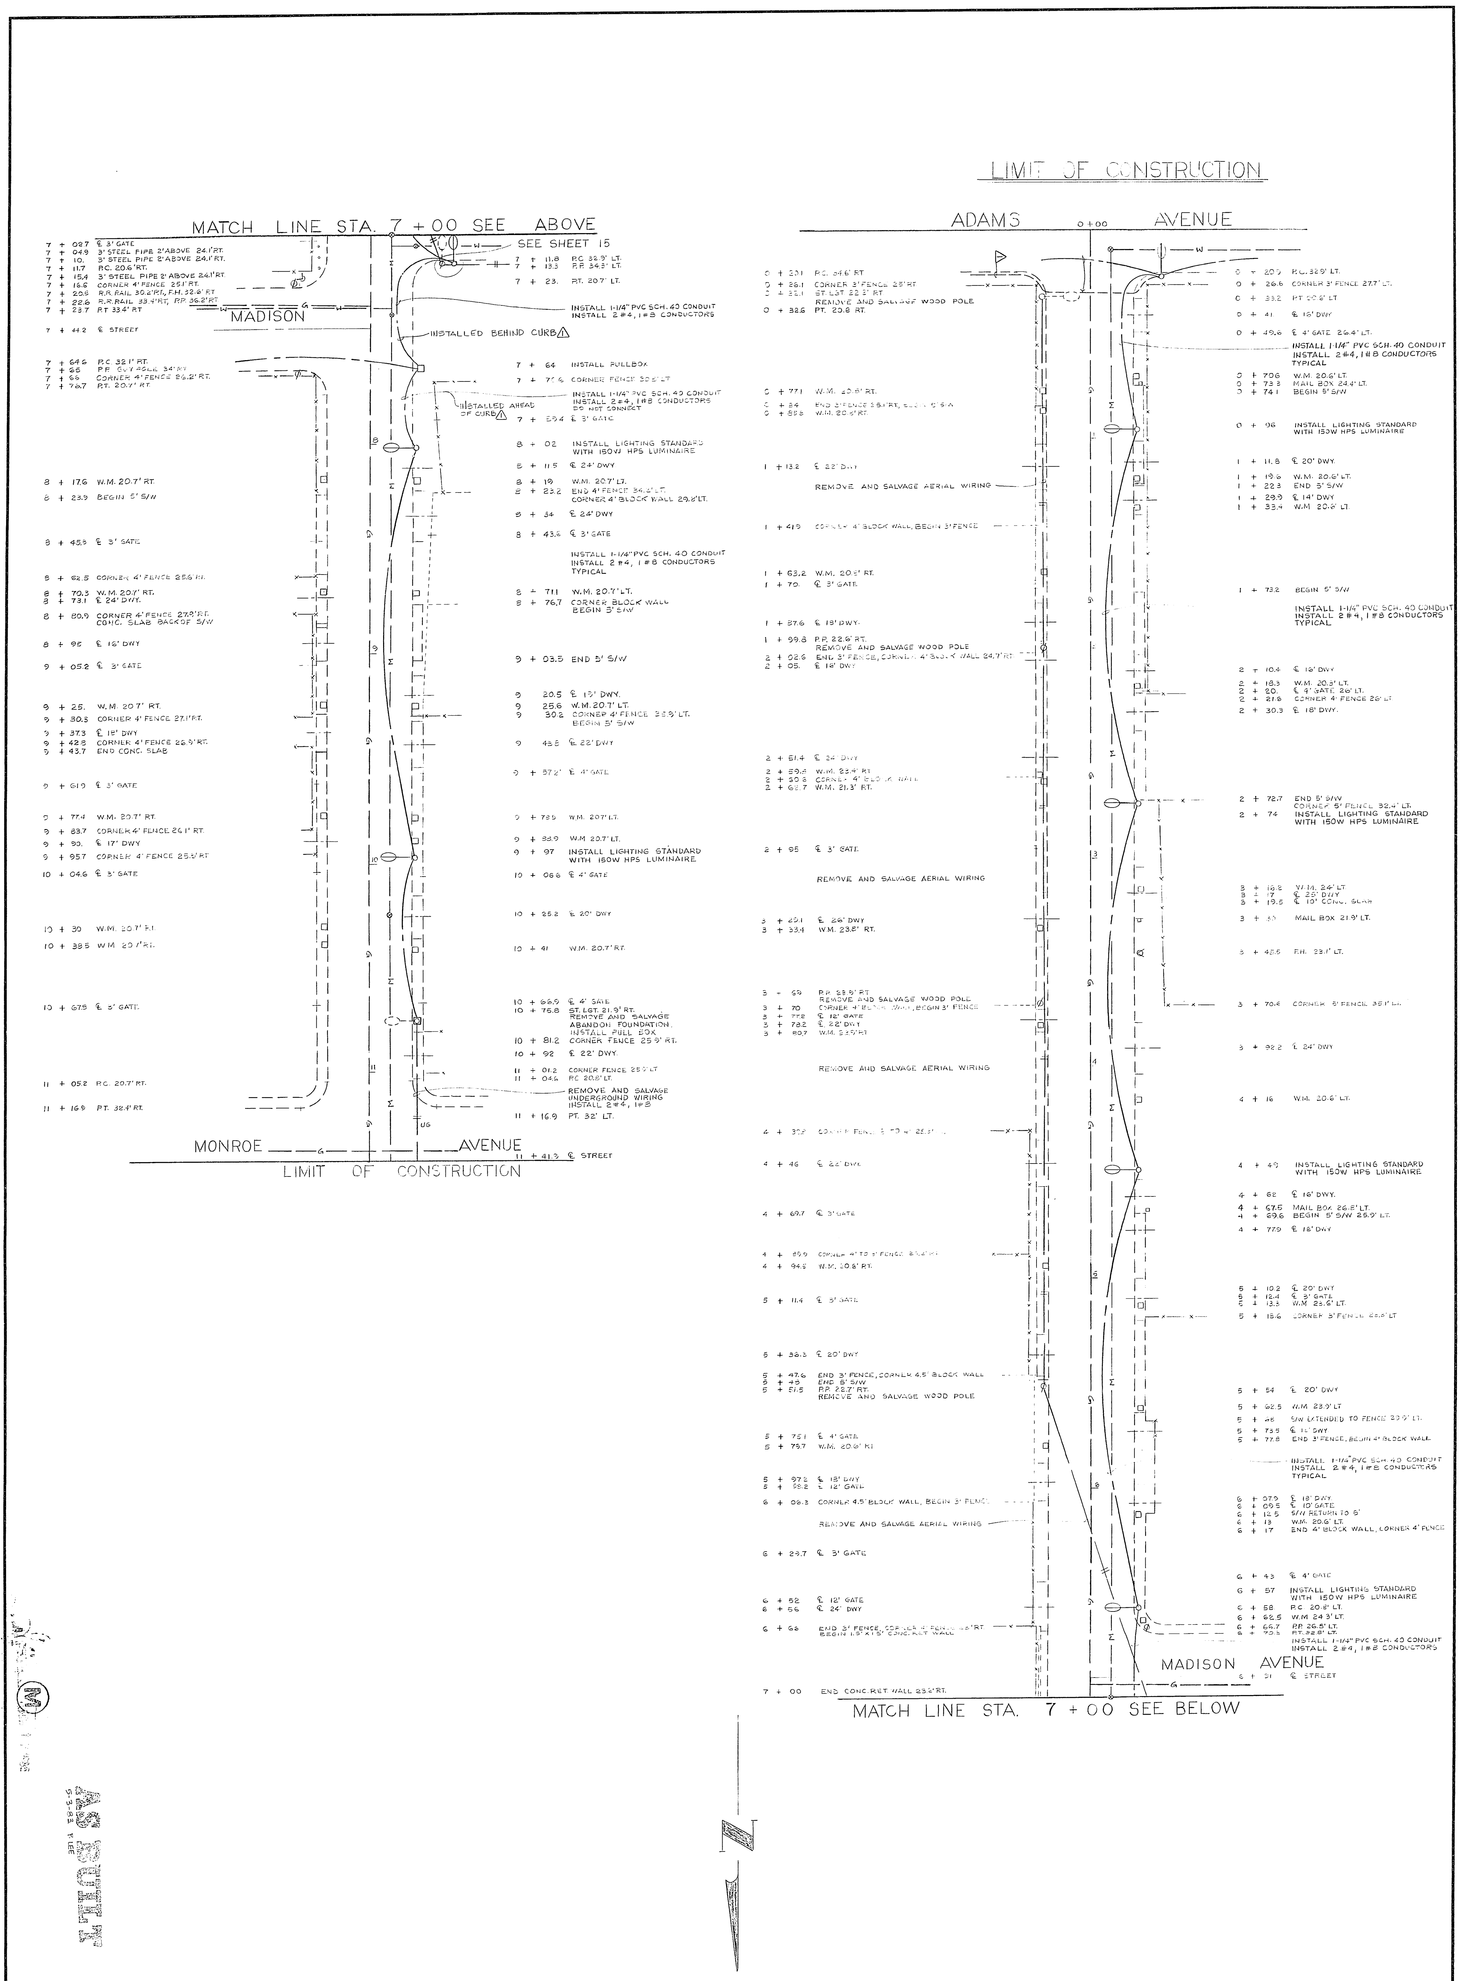

AS BUILT

Department of Public Services — Engineering Design Division	Scale (h) 1" = 30'	Scale (v) ———	W.A. 2115	AS-BUILT CONDITIONS SHOWN — S-3-03 FLEE
N.S.A. II STREET LIGHTING	Fld. bk. no.	Date SEPT, 1981		Revisions — Date
CUNNINGHAM DRIVE LIGHTING PLAN	Design by M. GOODMAN	Drawn by NORMA GOMEZ		

Drawing no. 207V-229 12/30

CITY OF LAS VEGAS — CLARK COUNTY, NEVADA

20-S-97