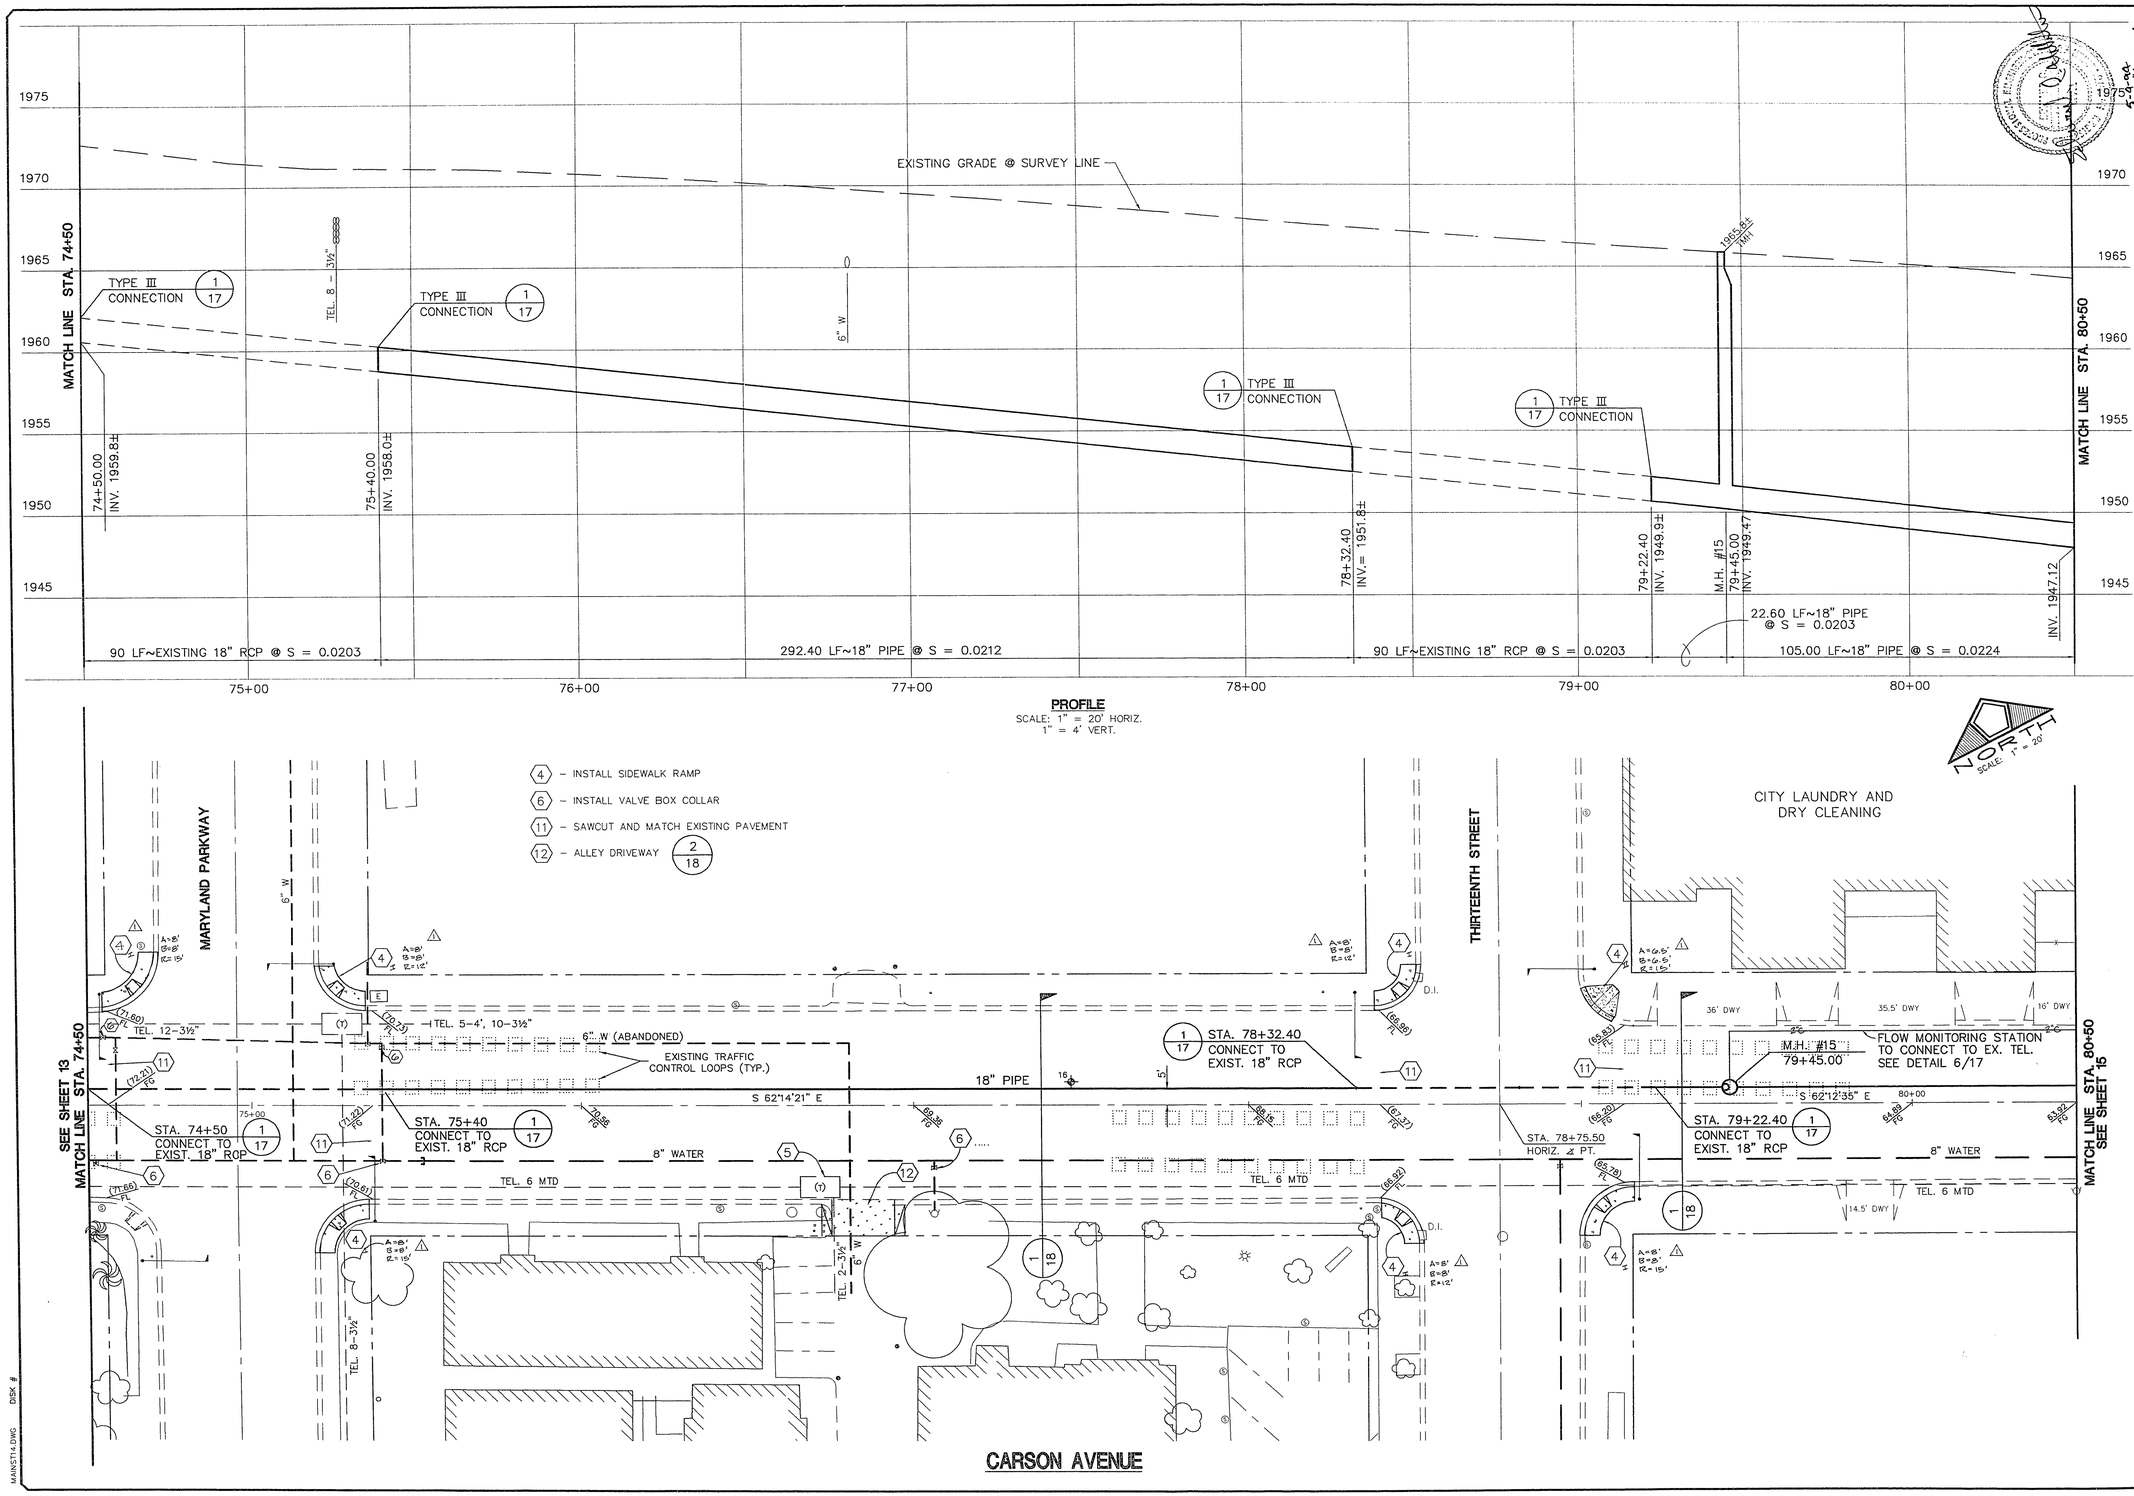

NO.	DESCRIPTION	DATE	APP'D
1	Revise Alignment	5-4-94	CGA

RECOMMENDED: M. FRONK, R. WELSH
R. E. 8708 DATE 5-6-94

DATE :	04/22/94
DRAWN BY :	M.C.
DESIGNED BY :	M.W.
CHECKED BY :	D.R.
JOB NO. :	133.0100
SCALE :	1" = 20'

PENTACORE Engineering, Inc.
6763 West Charleston Boulevard
Las Vegas, Nevada 89102
(702) 258-0115

CITY OF LAS VEGAS
MAIN STREET SEWER COLLECTOR
CARSON AVENUE
STA. 74+50 TO STA. 80+50

SHEET 14 OF 19
307-V704

MAINST14.DWG DISK #

D:\DWGS\LVSF\MAINST14 Fri Apr 22 06:32:51 1994

26-1-150