
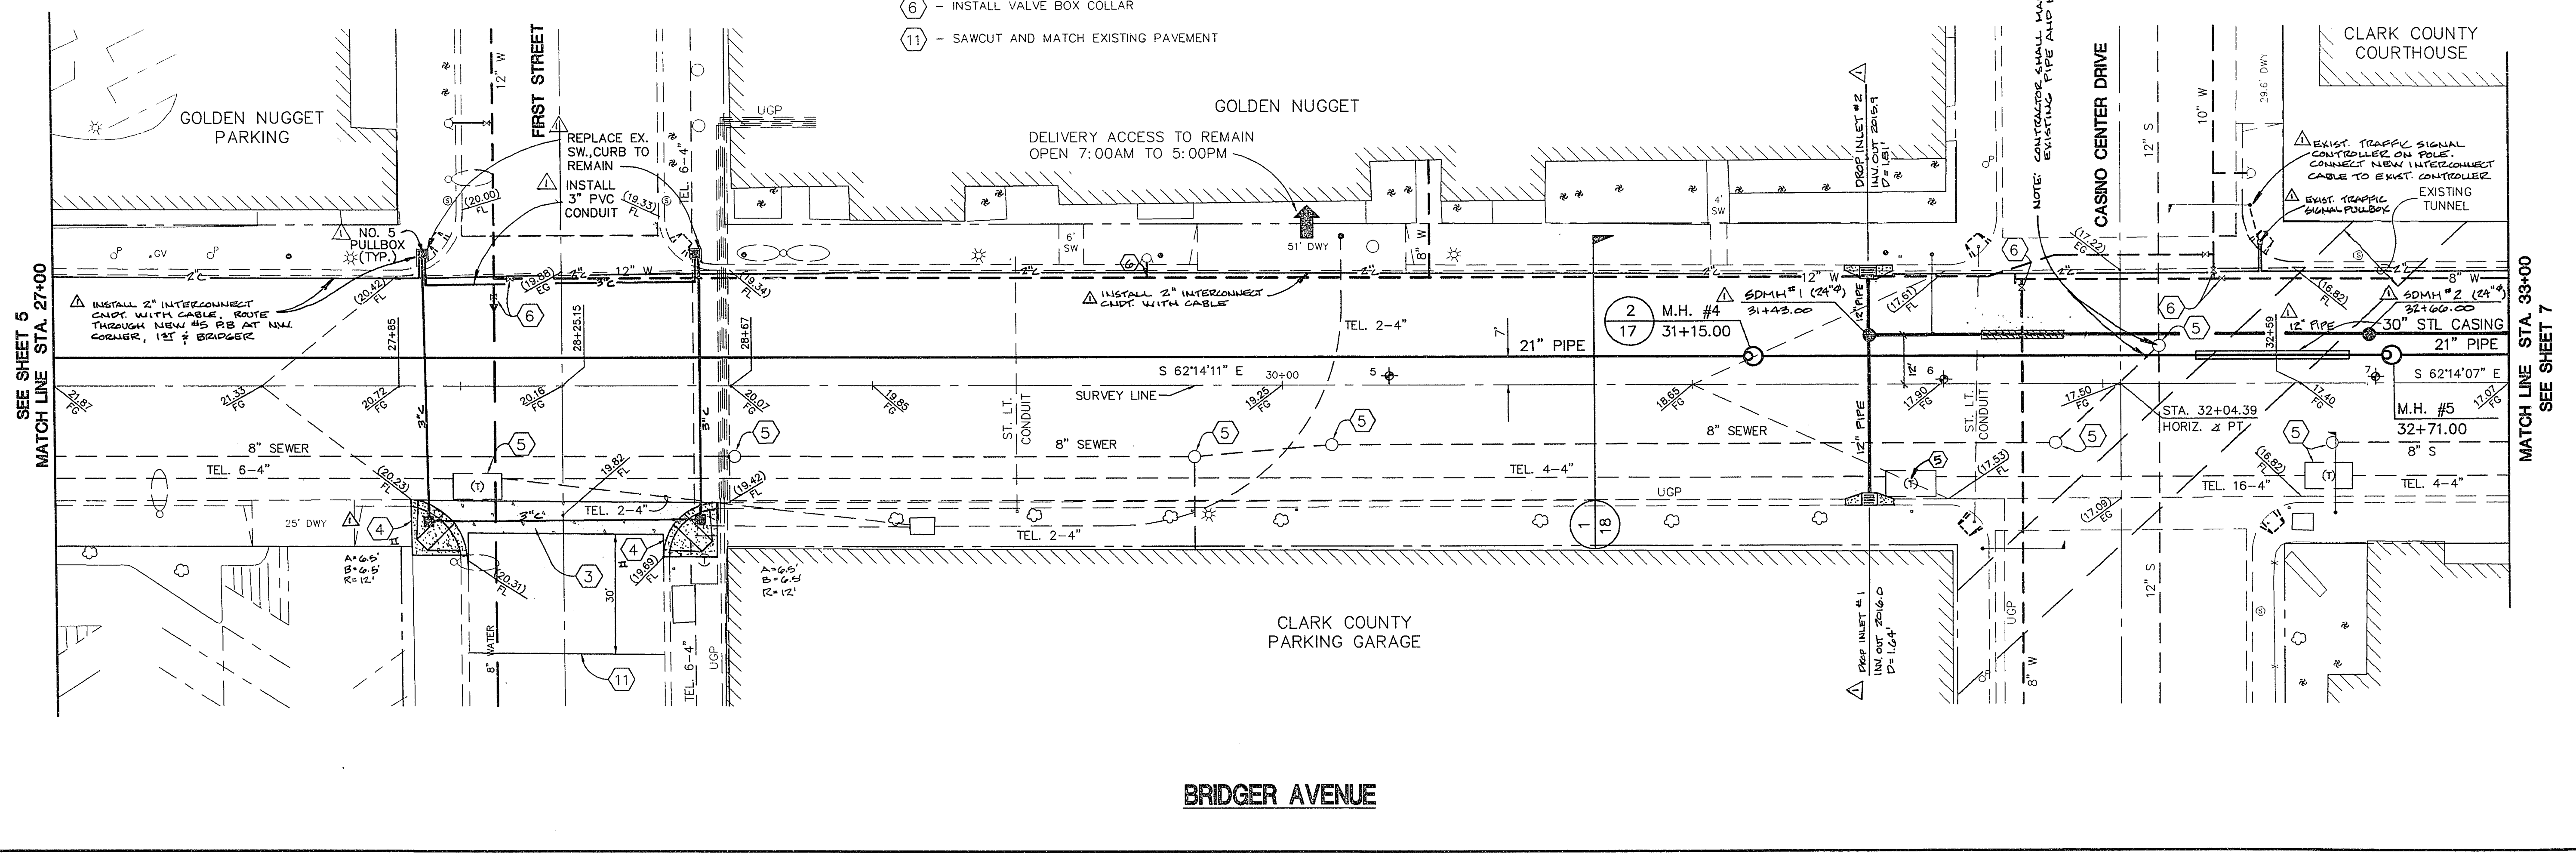


- 3 - INSTALL CROSS GUTTER
- 4 - INSTALL SIDEWALK RAMP
- 5 - INSTALL MANHOLE COLLAR
- 6 - INSTALL VALVE BOX COLLAR
- 11 - SAWCUT AND MATCH EXISTING PAVEMENT

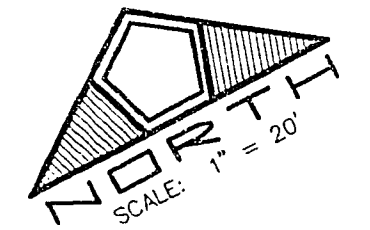

SEE SHEET 5
MATCH LINE STA. 27+00

MATCH LINE STA. 33+00
SEE SHEET 7

NO.	DESCRIPTION	DATE	APP'D.
1	REV. 5/10/04	5-10-04	REDA
2	ADD INTERCONNECT, ADD NOTES	5-10-04	REDA

RECOMMENDED

[Signature]

MARION F. WELSH
P.E. # 3060

DATE:	04/22/04
DRAWN BY:	M.W.
DESIGNED BY:	M.W.
CHECKED BY:	D.R.
JOB NO.:	133,0100
SCALE:	1" = 30'

PENTACORE
Engineering, Inc.
6763 West Charleston Boulevard
Las Vegas, Nevada 89102
(702) 258-0115

CITY OF LAS VEGAS
MAIN STREET SEWER COLLECTOR
BRIDGER AVENUE
STA. 27+00 TO STA. 33+00

CITY OF LAS VEGAS
NEVADA

SHEET
6 OF 19
307-V704

26-1-142