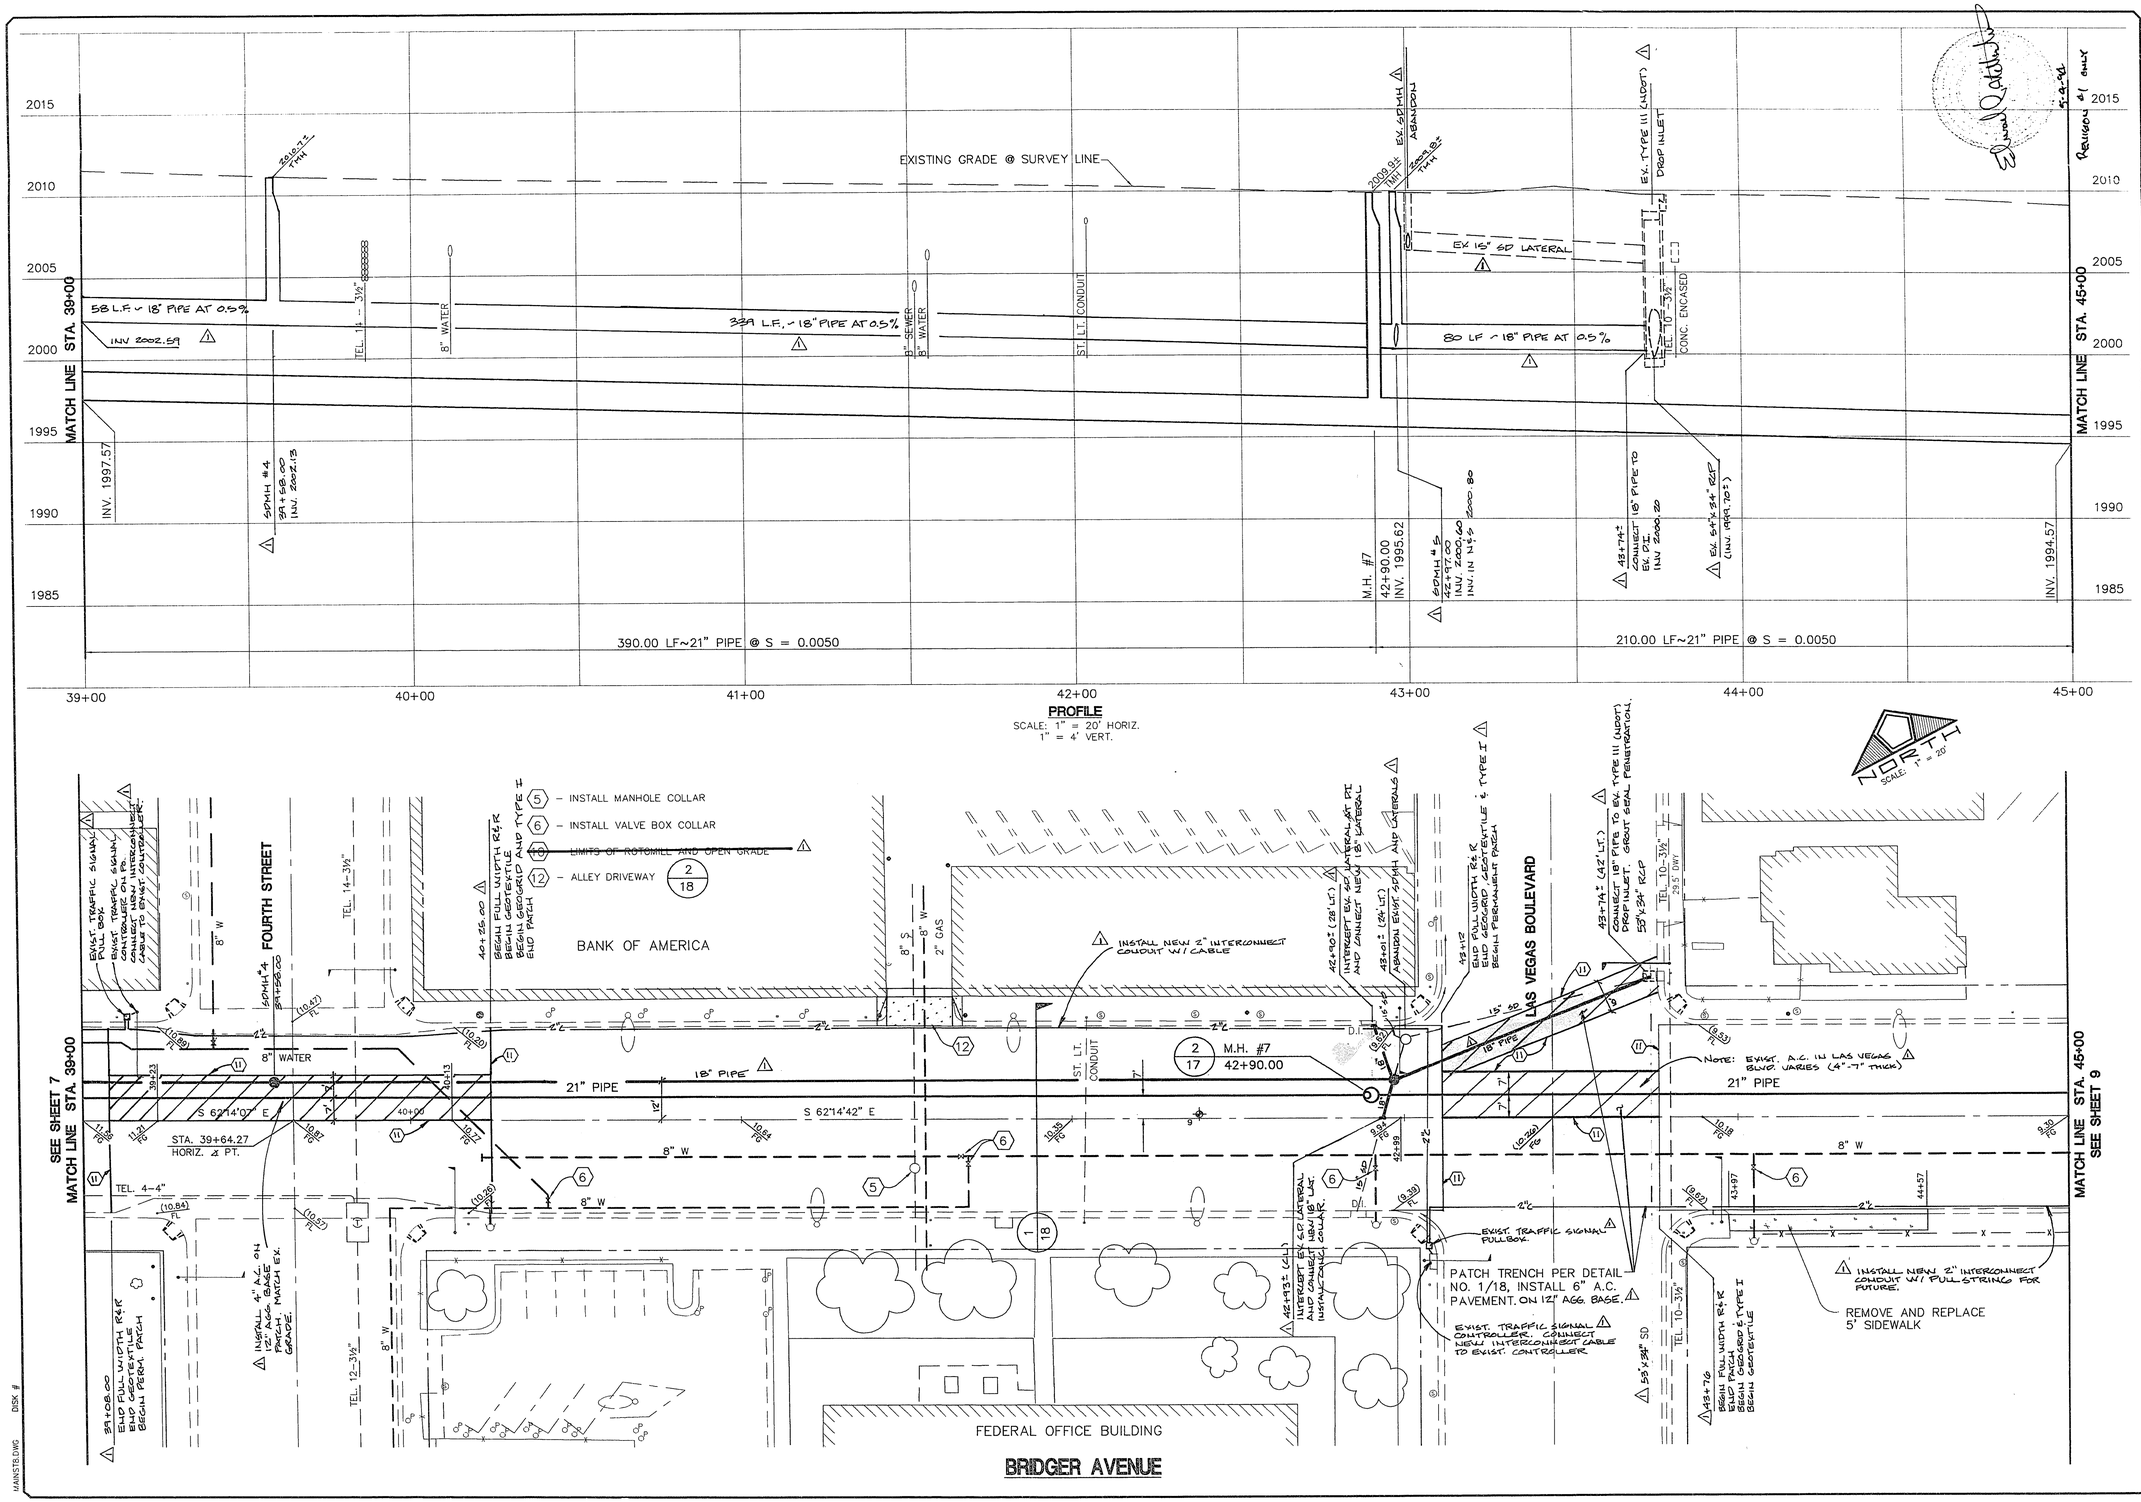

NO.	DESCRIPTION	DATE	APP'D
1	ADD STORM DRAIN, ADD NOTES, REVISED PER INTERFERENCE	5-6-96	

RECOMMENDED FOR CONSTRUCTION
MYRON R. WEBB
R. E. # 3641
STATE OF NEVADA

DATE: 04/22/94
DRAWN BY: M.G.
DESIGNED BY: M.W.
CHECKED BY: E.F.
JOB NO.: 133.0100
SCALE: 1" = 20'

PENTACORE Engineering, Inc.
6763 West Charleston Boulevard
Las Vegas, Nevada 89102
(702) 258-0115

CITY OF LAS VEGAS
MAIN STREET SEWER COLLECTOR
BRIDGER AVENUE
STA. 39+00 TO STA. 45+00

SHEET 8 OF 19
307-V704

D:\JOBS\LVSF\MAINSTB Thu Apr 21 15:41:42 1994
DISK #
MAINSTB.DWG

26-1-144