
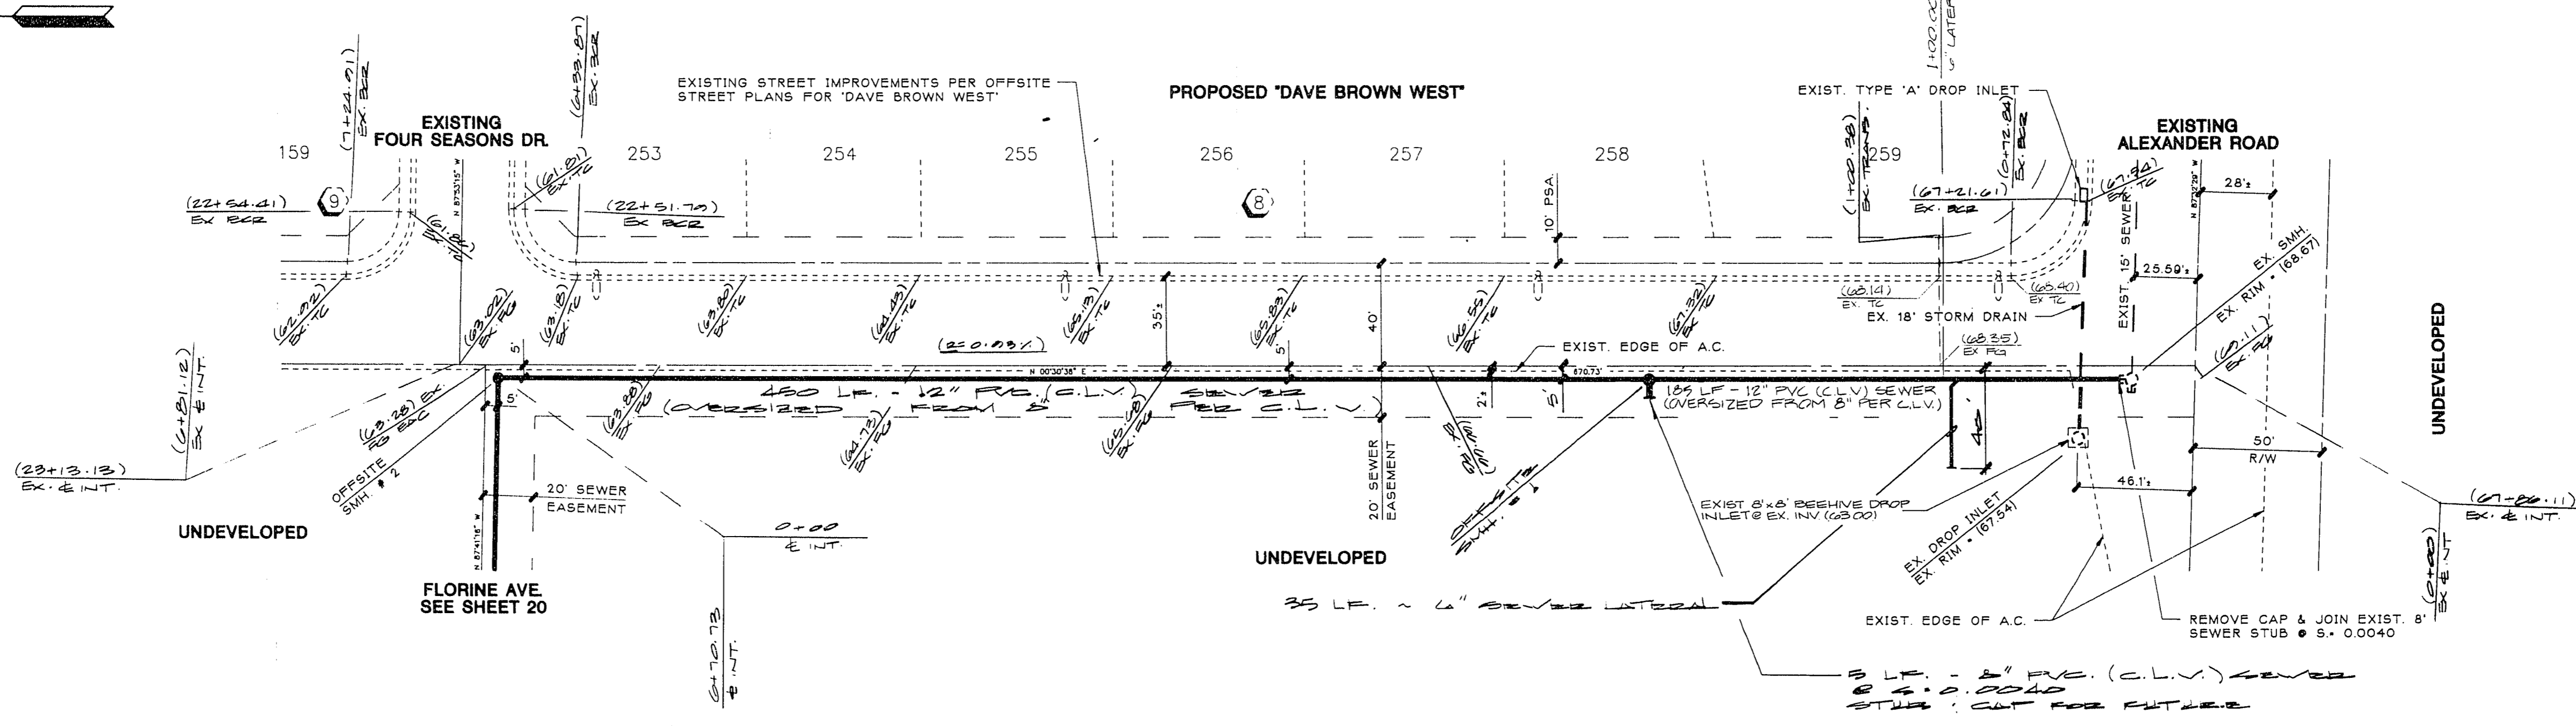


| | | | |
|------|----------|--|--|
| 2380 | REVISION | | |
| 2370 | BY | | |
| 2360 | DATE | | |
| 2350 | APPROVAL | | |

| | | | |
|---|----------|-----|-------------------------------|
| 1 | 11-29-92 | BYA | ADD LATERAL |
| 2 | 12-10-92 | USA | ADD SUB TO NORTH & SHOWN AND |
| 3 | 12-11-92 | BE | CHANGE PER MARK OVER 6 C.L.V. |

ESSEX ENGINEERS AND ARCHITECTS INC.
 CONSULTING ENGINEERS & ARCHITECTS
 708 W. CHAMBERLAIN BLVD.
 SAN JOSE, CA 95128
 CIVIL
 SUBMITTED BY: *[Signature]*

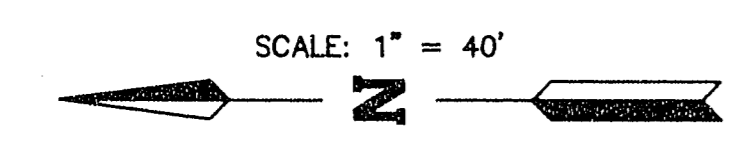

BENCHMARK
 B.M. = C.L.V. # 1LV04SES
 FOUND NAIL IN TAG IN TOP OF CURB AT THE
 NORTHWEST QUADRANT OF BUFFALO DRIVE & ALEXANDER
 ROAD.
 ELEVATION = 2339.57'

CIMARRON ROAD

NOTE:
 EXISTING UTILITY LOCATIONS SHOWN HEREON ARE APPROXIMATE ONLY.
 IT SHALL BE THE CONTRACTOR'S RESPONSIBILITY TO DETERMINE THE
 EXACT VERTICAL AND HORIZONTAL LOCATION OF ALL EXISTING UNDER-
 GROUND UTILITIES PRIOR TO COMMENCING CONSTRUCTION. NO
 REPRESENTATION IS MADE THAT ALL EXISTING UTILITIES ARE SHOWN
 HEREON. THE ENGINEER ASSUMES NO RESPONSIBILITY FOR UTILITIES
 NOT SHOWN OR UTILITIES NOT SHOWN IN THEIR PROPER LOCATION.
 CALL BEFORE YOU DIG: 1-800-227-2600.

Call
 before you
 Dig
 1-800-227-2600
 UNDERGROUND SERVICE (USA)

OFFSITE SEWER PLAN & PROFILE
 (CIMARRON ROAD)

MONTEREY ESTATES
 APN# 460-010-012

TITLE

PROJECT

W.O. #: 010 - A585

BY: B.L.G.

DATE: SEPT. 1992

SCALE: HORIZ. 1"=40'
 VERT. 1"=4'

SHEET

19

OF 28 SHEETS

10-26-54 3074-4243