
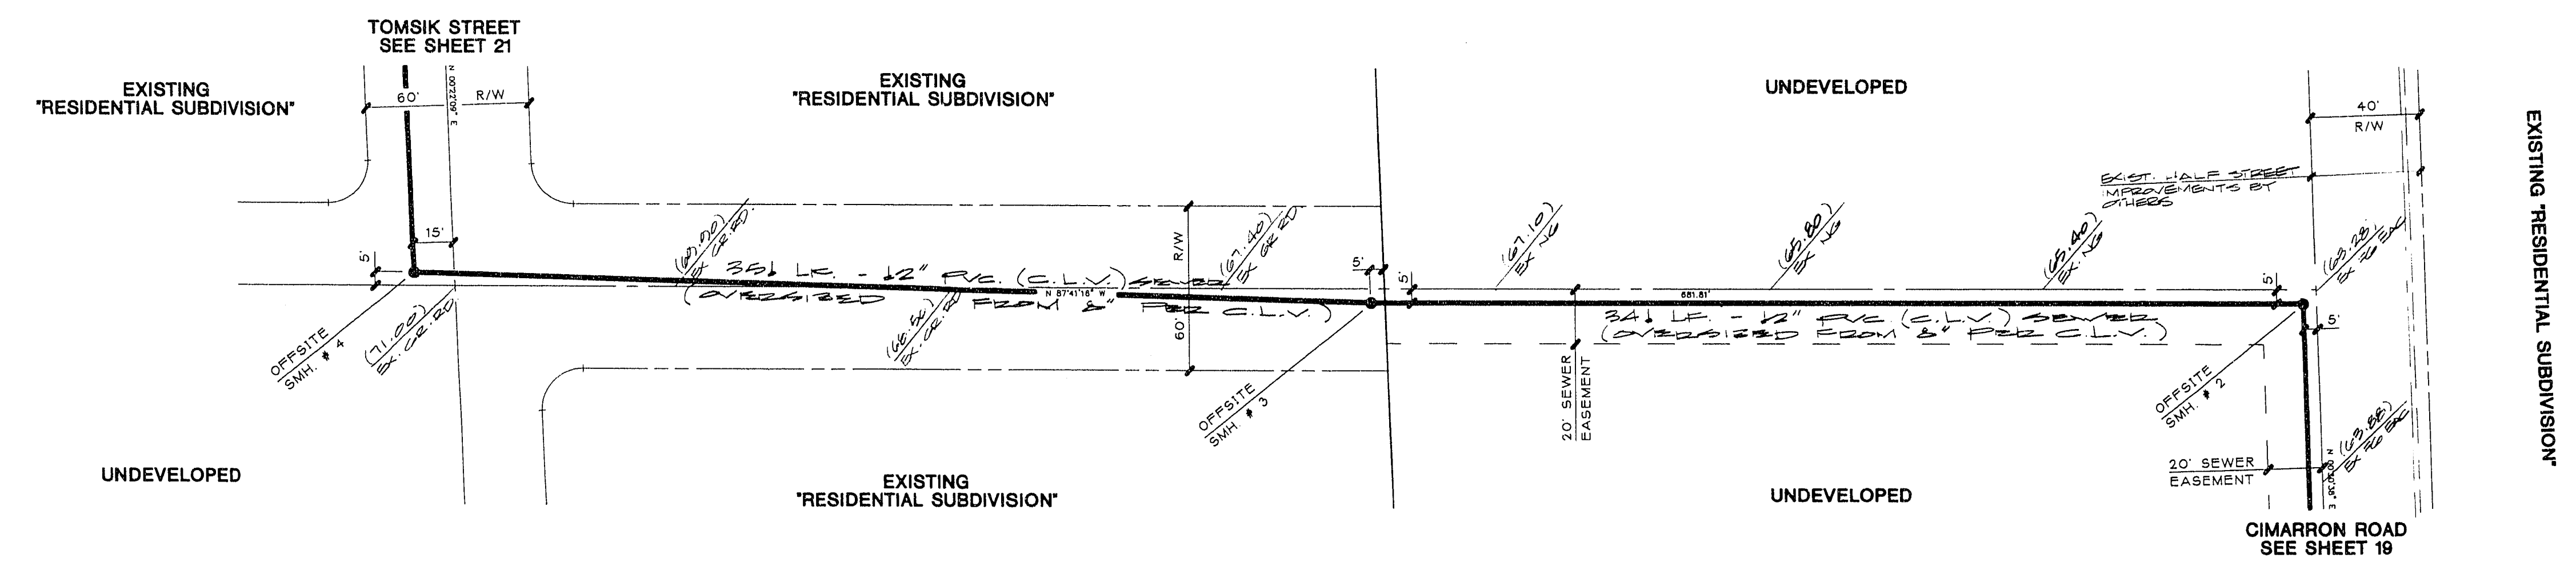


APPROVAL	REV	DATE	BY	REVISION
	1	11-28-92	BLG	DESIGN FOR CONSTRUCTION
	2	12-11-92	BLG	REVISIONS TO CONSTRUCTION AND SUPPLEMENTAL NOTES

--	---

SUBMITTED BY: *[Signature]* 9-21-92

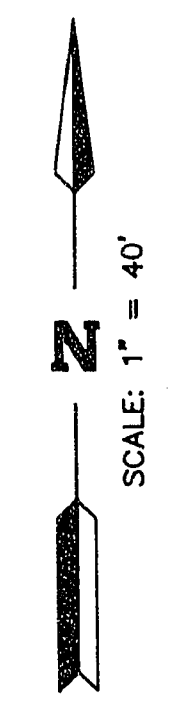

**BENCHMARK**  
 B.M. = C.L.V. # 1L004SES  
 FOUND NAIL IN TAG IN TOP OF CURB AT THE  
 NORTHWEST QUADRANT OF BUFFALO DRIVE & ALEXANDER  
 ROAD.  
 ELEVATION = 2339.57

## FLORINE AVENUE

**NOTE:**  
 EXISTING UTILITY LOCATIONS SHOWN HEREON ARE APPROXIMATE ONLY. IT SHALL BE THE CONTRACTOR'S RESPONSIBILITY TO DETERMINE THE EXACT VERTICAL AND HORIZONTAL LOCATION OF ALL EXISTING UNDERGROUND UTILITIES PRIOR TO COMMENCING CONSTRUCTION. NO REPRESENTATION IS MADE THAT ALL EXISTING UTILITIES ARE SHOWN HEREON. THE ENGINEER ASSUMES NO RESPONSIBILITY FOR UTILITIES NOT SHOWN OR UTILITIES NOT SHOWN IN THEIR PROPER LOCATION. CALL BEFORE YOU DIG: 1-800-227-2600.

Call  
before you  
Dig.  
1-800-227-2600  
UNDERGROUND SERVICE (USA)

**OFFSITE SEWER PLAN & PROFILE**  
 (FLORINE AVENUE)  
**MONTEREY ESTATES**  
 APN# 450-010-012

W.O. #: 010 - A585  
 BY: B.L.G.  
 DATE: SEPT. 1992  
 SCALE: HORIZ. 1"=40'  
 VERT. 1"=4'

SHEET  
**20**  
 OF 22 SHEETS

10-26-55 307Y-4243