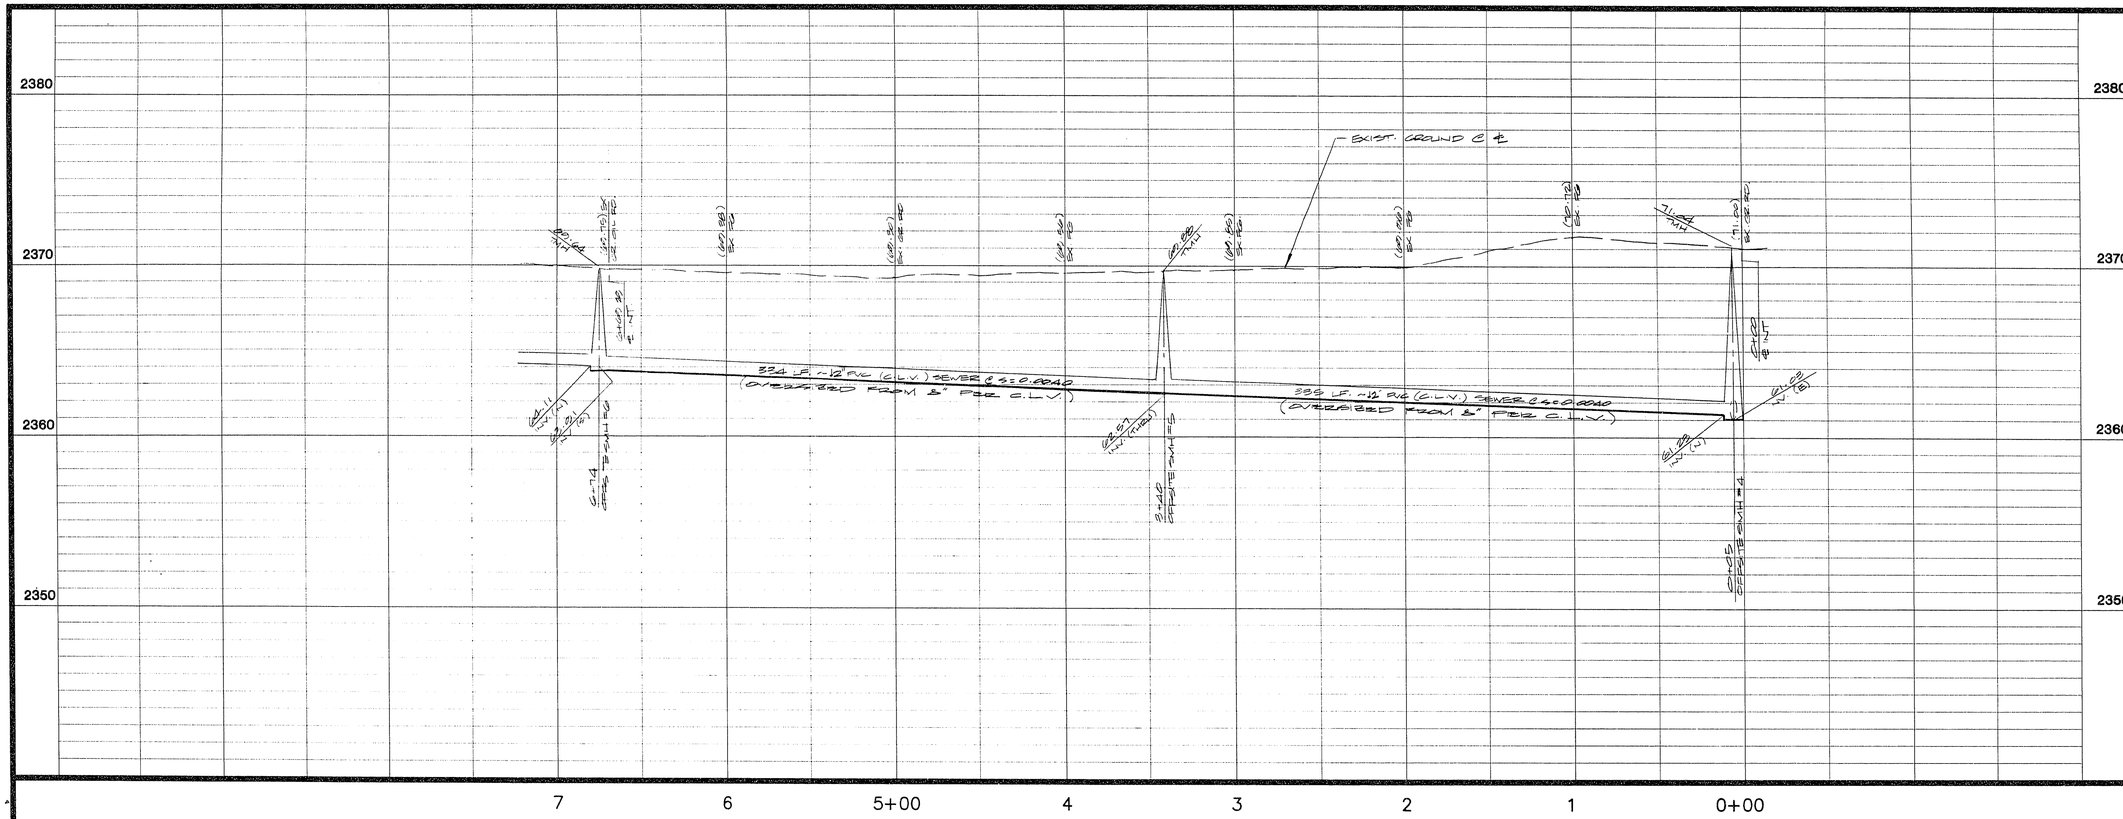

SCALE: 1" = 40'

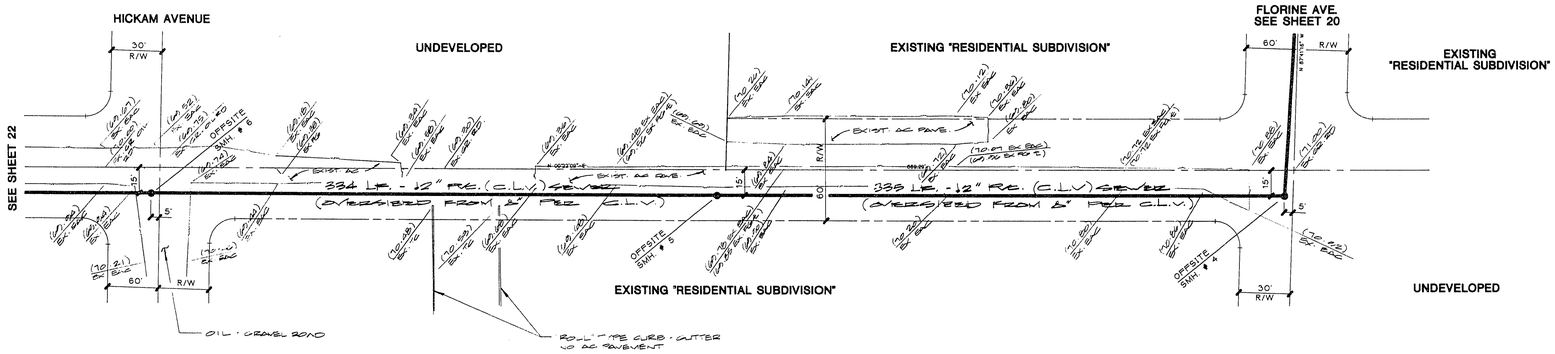

BENCHMARK

B.M. = C.L.V. # 1LV004SES
FOUND NAIL IN TAG IN TOP OF CURB AT THE NORTHWEST QUADRANT OF BUFFALO DRIVE & ALEXANDER ROAD.

ELEVATION = 2339.57'

TOMSIK STREET

NOTE:

EXISTING UTILITY LOCATIONS SHOWN HEREON ARE APPROXIMATE ONLY. IT SHALL BE THE CONTRACTOR'S RESPONSIBILITY TO DETERMINE THE EXACT VERTICAL AND HORIZONTAL LOCATION OF ALL EXISTING UNDERGROUND UTILITIES PRIOR TO COMMENCING CONSTRUCTION. NO REPRESENTATION IS MADE THAT ALL EXISTING UTILITIES ARE SHOWN HEREON. THE ENGINEER ASSUMES NO RESPONSIBILITY FOR UTILITIES NOT SHOWN OR UTILITIES NOT SHOWN IN THEIR PROPER LOCATION. CALL BEFORE YOU DIG: 1-800-227-2600.

Call before you Dig.
1-800-227-2600
UNDERGROUND SERVICE (USA)

APRVL	REV	DATE	BY	REVISION
	1	11-23-92	BLG	OVERSIZED SEWER TO 12" PER C.L.V.

ESI ENGINEERS AND SURVEYORS INC.
PROFESSIONAL ENGINEERS • SURVEYORS
7018 W. CHARLESTON BLVD. • VEGAS, NEVADA 89128 • (702) 363-6415

SUBMITTED BY: Dan Dodge
REGISTERED PROFESSIONAL ENGINEER STATE OF NEVADA
WILLIAMS CIVIL No. 6650
9-21-92

TITLE: OFFSITE SEWER PLAN & PROFILE (TOMSIK STREET)

PROJECT: MONTEREY ESTATES
APN.# 450-010-012

W.O. # :	010 - A585
BY :	B.L.G.
DATE :	SEPT. 1992
SCALE :	HORIZ. 1"=40' VERT. 1"=4'

SHEET 21 OF 28 SHEETS

10-25-96 3074-4243