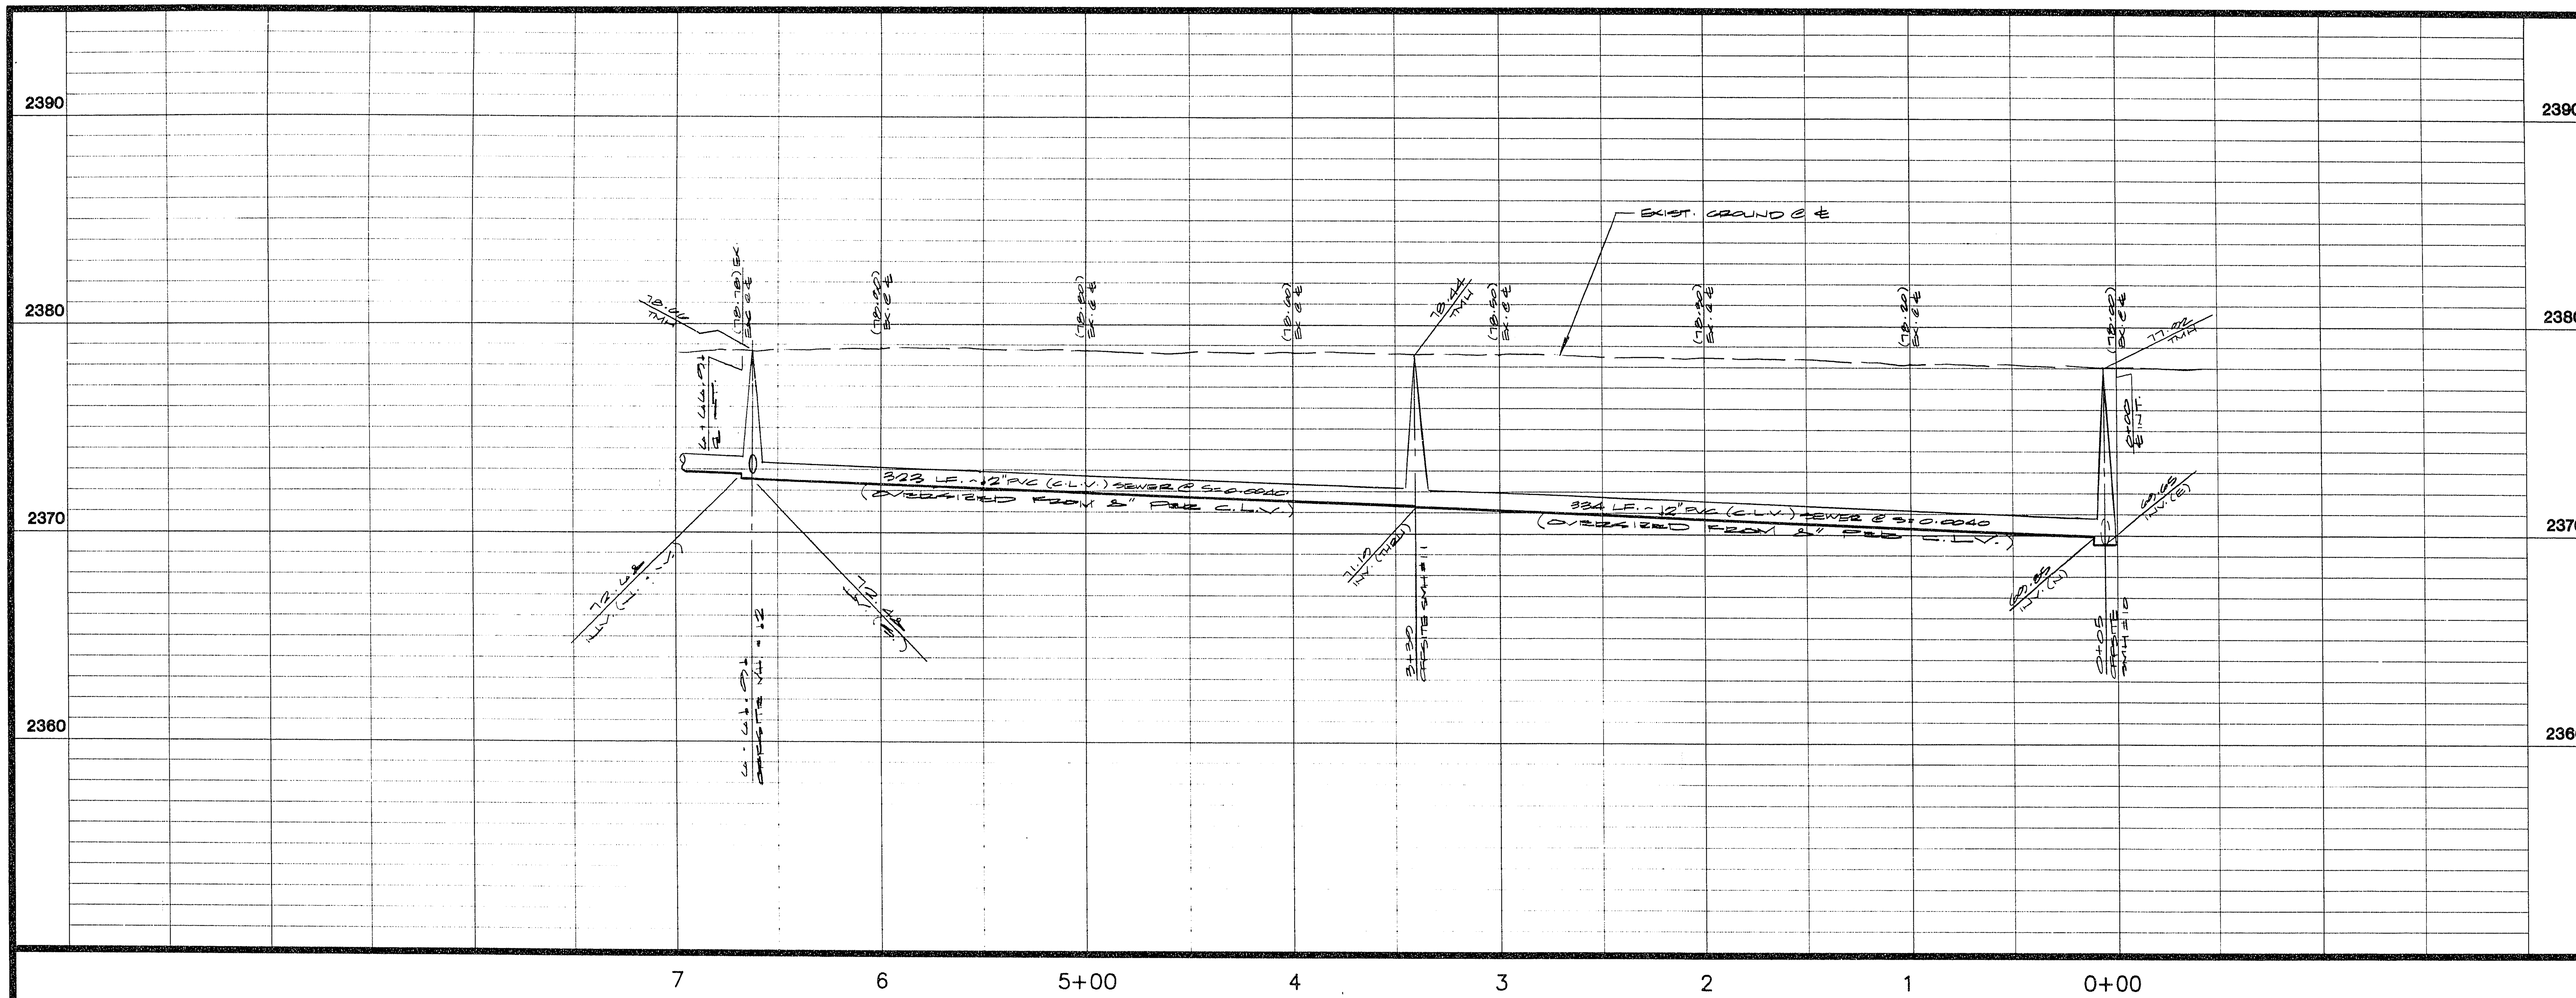

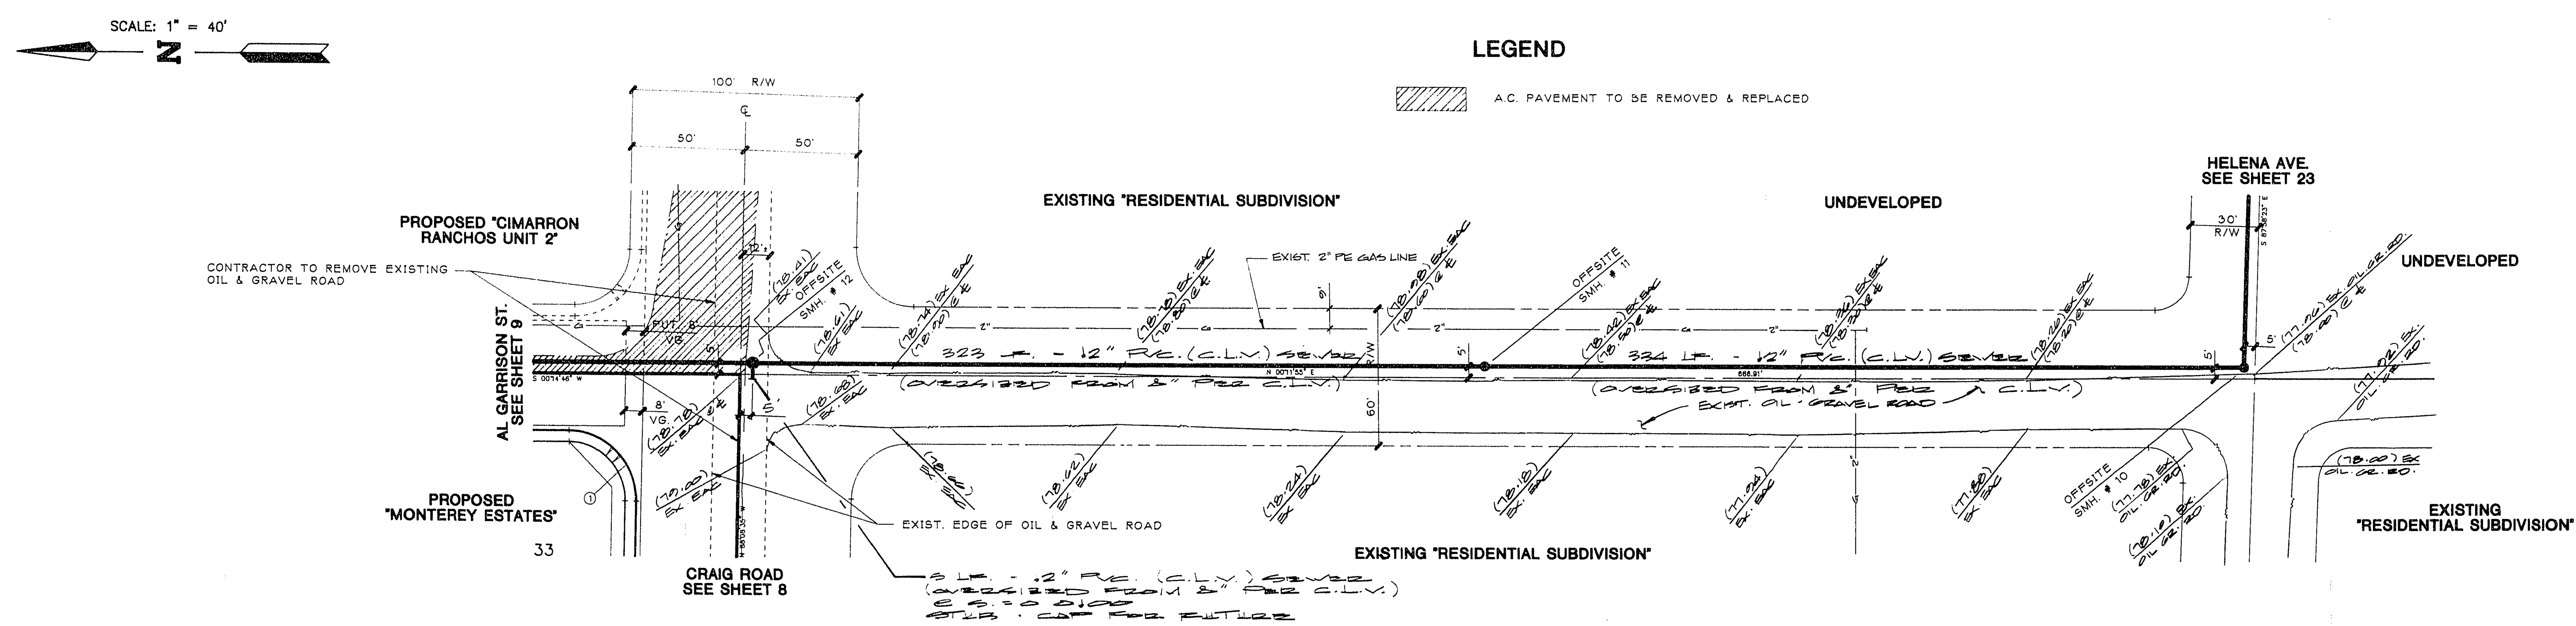

BENCHMARK

B.M. = C.L.V. # 1LV004SES
FOUND NAIL IN TAG IN TOP OF CURB AT THE NORTHWEST QUADRANT OF BUFFALO DRIVE & ALEXANDER ROAD.

ELEVATION = 2339.57'

CURVE DATA TABLE

No.	RADIUS	DELTA	LENGTH	TANGENT
1	30.00'	91°36'39"	47.97'	30.86'

AL GARRISON STREET

NOTE:

EXISTING UTILITY LOCATIONS SHOWN HEREON ARE APPROXIMATE ONLY. IT SHALL BE THE CONTRACTOR'S RESPONSIBILITY TO DETERMINE THE EXACT VERTICAL AND HORIZONTAL LOCATION OF ALL EXISTING UNDERGROUND UTILITIES PRIOR TO COMMENCING CONSTRUCTION. NO REPRESENTATION IS MADE THAT ALL EXISTING UTILITIES ARE SHOWN HEREON. THE ENGINEER ASSUMES NO RESPONSIBILITY FOR UTILITIES NOT SHOWN OR UTILITIES NOT SHOWN IN THEIR PROPER LOCATION. CALL BEFORE YOU DIG: 1-800-227-2600.

Call before you Dig.
1-800-227-2600
UNDERGROUND SERVICE (USA)

APRVL	REV	DATE	BY	REVISION
	1	11-23-92	BG	REV'D. MH. LOCATION, ADDED STUB, OVERSIZED PER CLV, REV'D. SHT. TOTAL

ESI ENGINEERS AND SURVEYORS INC.
PLANNERS, CONSULTING ENGINEERS, SURVEYORS
7018 W. CHARLESTON BLVD. LAS VEGAS, NEVADA 89117 (702) 363-6415

SUBMITTED BY: 9.21.92
PROFESSIONAL ENGINEER - STATE OF NEVADA - DANIEL J. WINDERS - CIVIL - REGISTERED

TITLE: OFFSITE SEWER PLAN & PROFILE (AL GARRISON STREET)

PROJECT: MONTEREY ESTATES
APN# 450-010-012

W.O. # : 010 – A585
BY : B.L.G.
DATE : SEPT. 1992
SCALE : HORIZ. 1"=40' VERT. 1"=4'

SHEET 24 OF 28 SHEETS

10-26-59. 3074-4243