


16-5-108

CALL BEFORE YOU DIG
1-800-227-2600

Richfield Village Unit 4-A

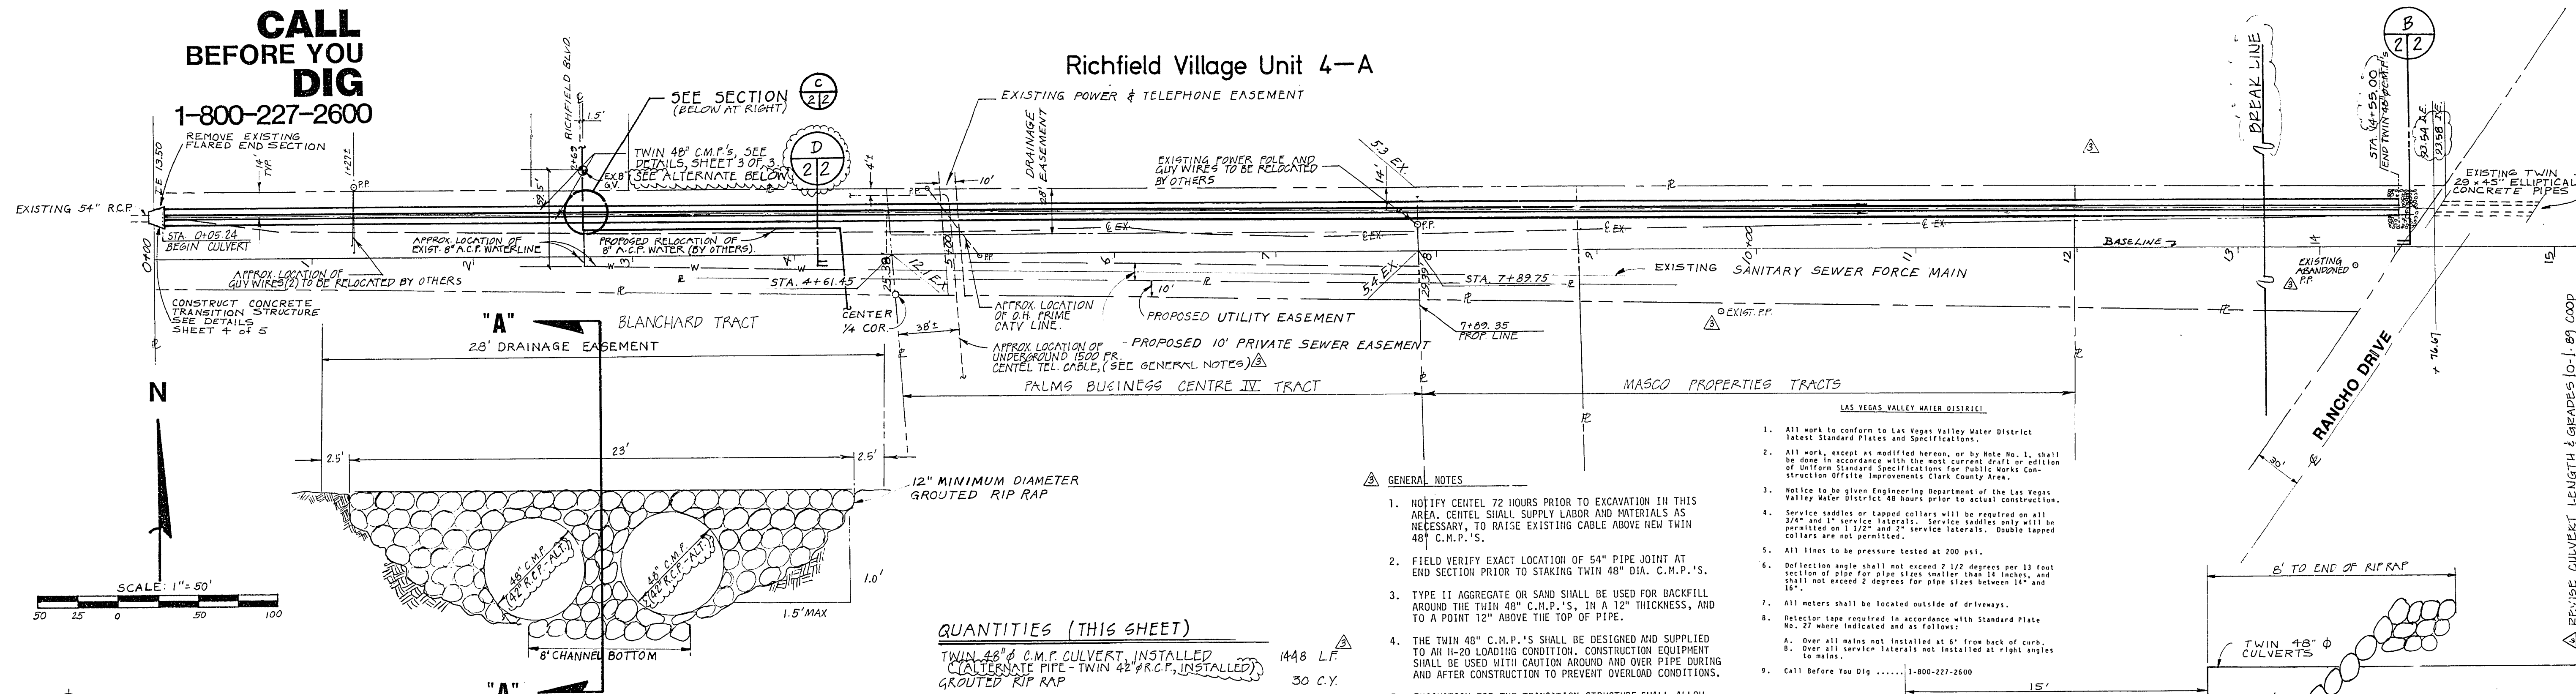

QUANTITIES (THIS SHEET)	
TWIN 48\"/>	1448 LF.
CONCRETE TRANSITION STRUCTURE	1 EA.
TYPE II GRAVEL OR SAND (C.I.P.)	850 CY.
* ADJUST EXIST. 8\"/>	1 EA.
* RELOCATE EXIST. NEVADA POWER CO. POLES AND GUYS (SEE NEVADA POWER CO. SPECIFICATIONS AND COSTS.)	2 EA.
SWALE GRADING	1445 LF.
Plain Riprap	25 CY.

*Note: This work is to be performed by others but will be paid for out of project funds.

- GENERAL NOTES**
1. NOTIFY CEHTEL 72 HOURS PRIOR TO EXCAVATION IN THIS AREA. CEHTEL SHALL SUPPLY LABOR AND MATERIALS AS NECESSARY, TO RAISE EXISTING CABLE ABOVE NEW TWIN 48\"/>
 2. FIELD VERIFY EXACT LOCATION OF 54\"/>
 3. TYPE II AGGREGATE OR SAND SHALL BE USED FOR BACKFILL AROUND THE TWIN 48\"/>
 4. THE TWIN 48\"/>
 5. EXCAVATION FOR THE TRANSITION STRUCTURE SHALL ALLOW FOR AN 8\"/>
 6. ALL EXISTING AND DESIGN ELEVATIONS ARE SHOWN ON THE PROFILE BELOW.
 7. QUANTITY FOR TWIN 48\"/>
8. ALL WORK SHALL BE DONE IN ACCORDANCE WITH THE LATEST STANDARD SPECIFICATIONS FOR PUBLIC WORKS, CLARK COUNTY, NEVADA.
9. Contract does not include asphalt paving.

1. All work to conform to Las Vegas Valley Water District latest Standard Plates and Specifications.
2. All work, except as modified hereon, or by Note No. 1, shall be done in accordance with the most current draft or edition of Uniform Standard Specifications for Public Works Construction Office, Clark County Area.
3. Notice to be given Engineering Department of the Las Vegas Valley Water District 48 hours prior to actual construction.
4. Service saddles or tapped collars will be required on all 3/4\"/>
5. All lines to be pressure tested at 200 psi.
6. Deflection angle shall not exceed 1/2 degrees per 13 foot section of pipe for pipe sizes smaller than 18 inches, and shall not exceed 2 degrees for pipe sizes between 18\"/>
7. All meters shall be located outside of driveways.
8. Detector tape required in accordance with Standard Plate No. 27 where indicated and as follows:
a. Over all mains not installed at 90° from back of curb.
b. Over all service laterals not installed at right angles to mains.
9. Call Before You Dig 1-800-227-2600






SECTION "A" -- SIDE VIEW

Not To Scale

SWALE CROSS SECTION

(Typical, Sta. 0+00 to 4+00, 7+90 to 14+00)
NOT TO SCALE

BENCHMARK
A RIVET AND PLATE, 1618 A TO A, CITY OF LAS VEGAS, S.E. CORNER OF MILO AND RICHFIELD. ELEV. = 2112.902

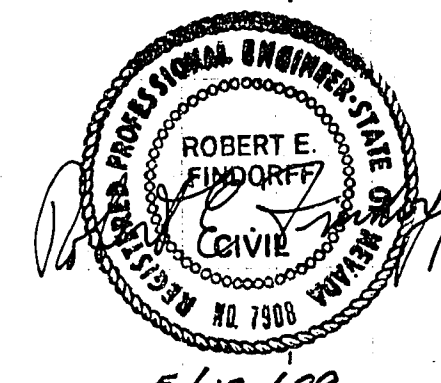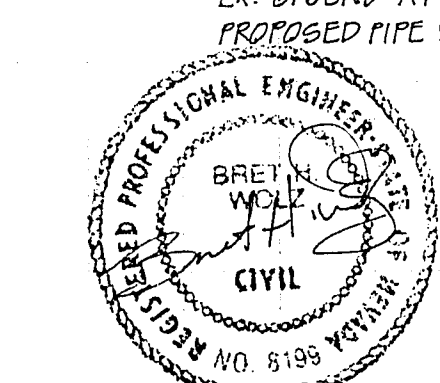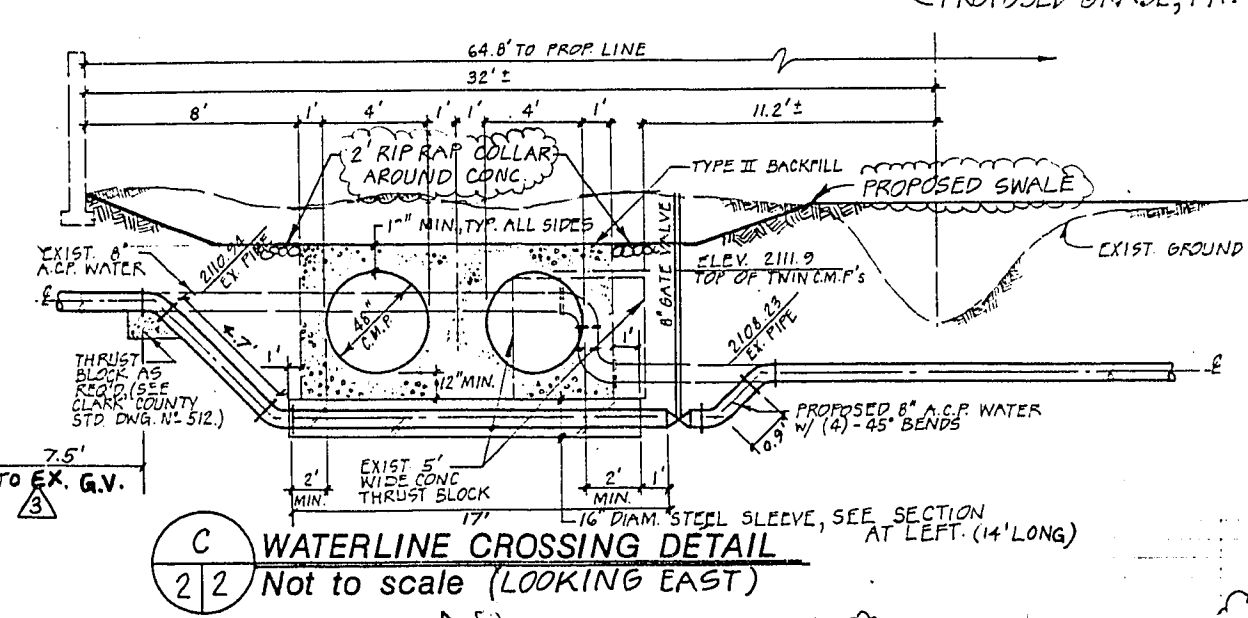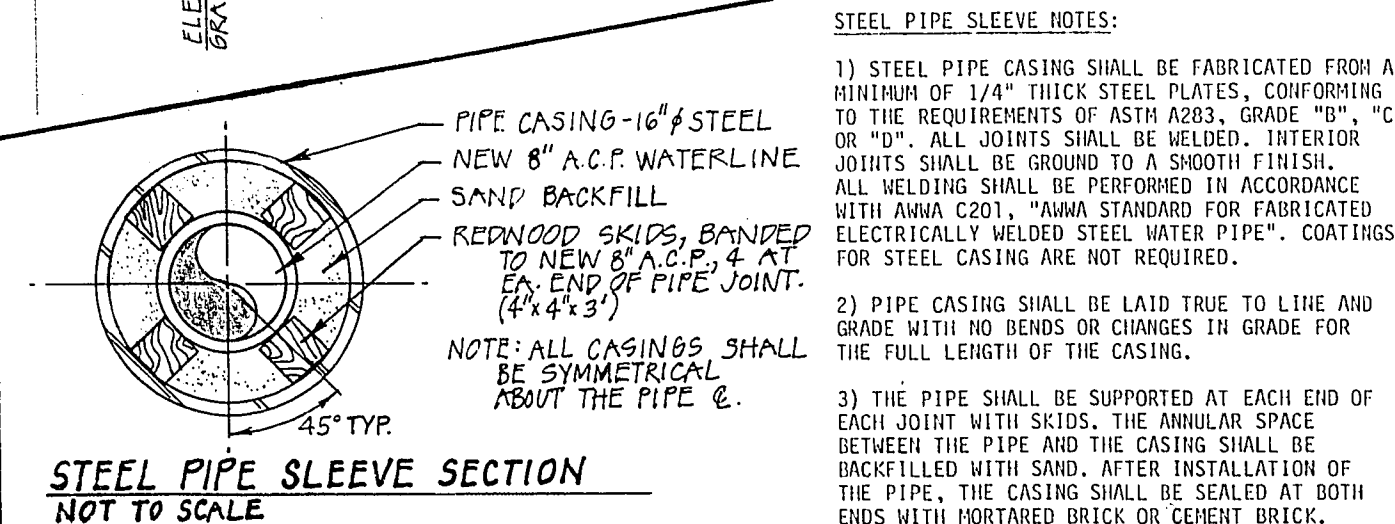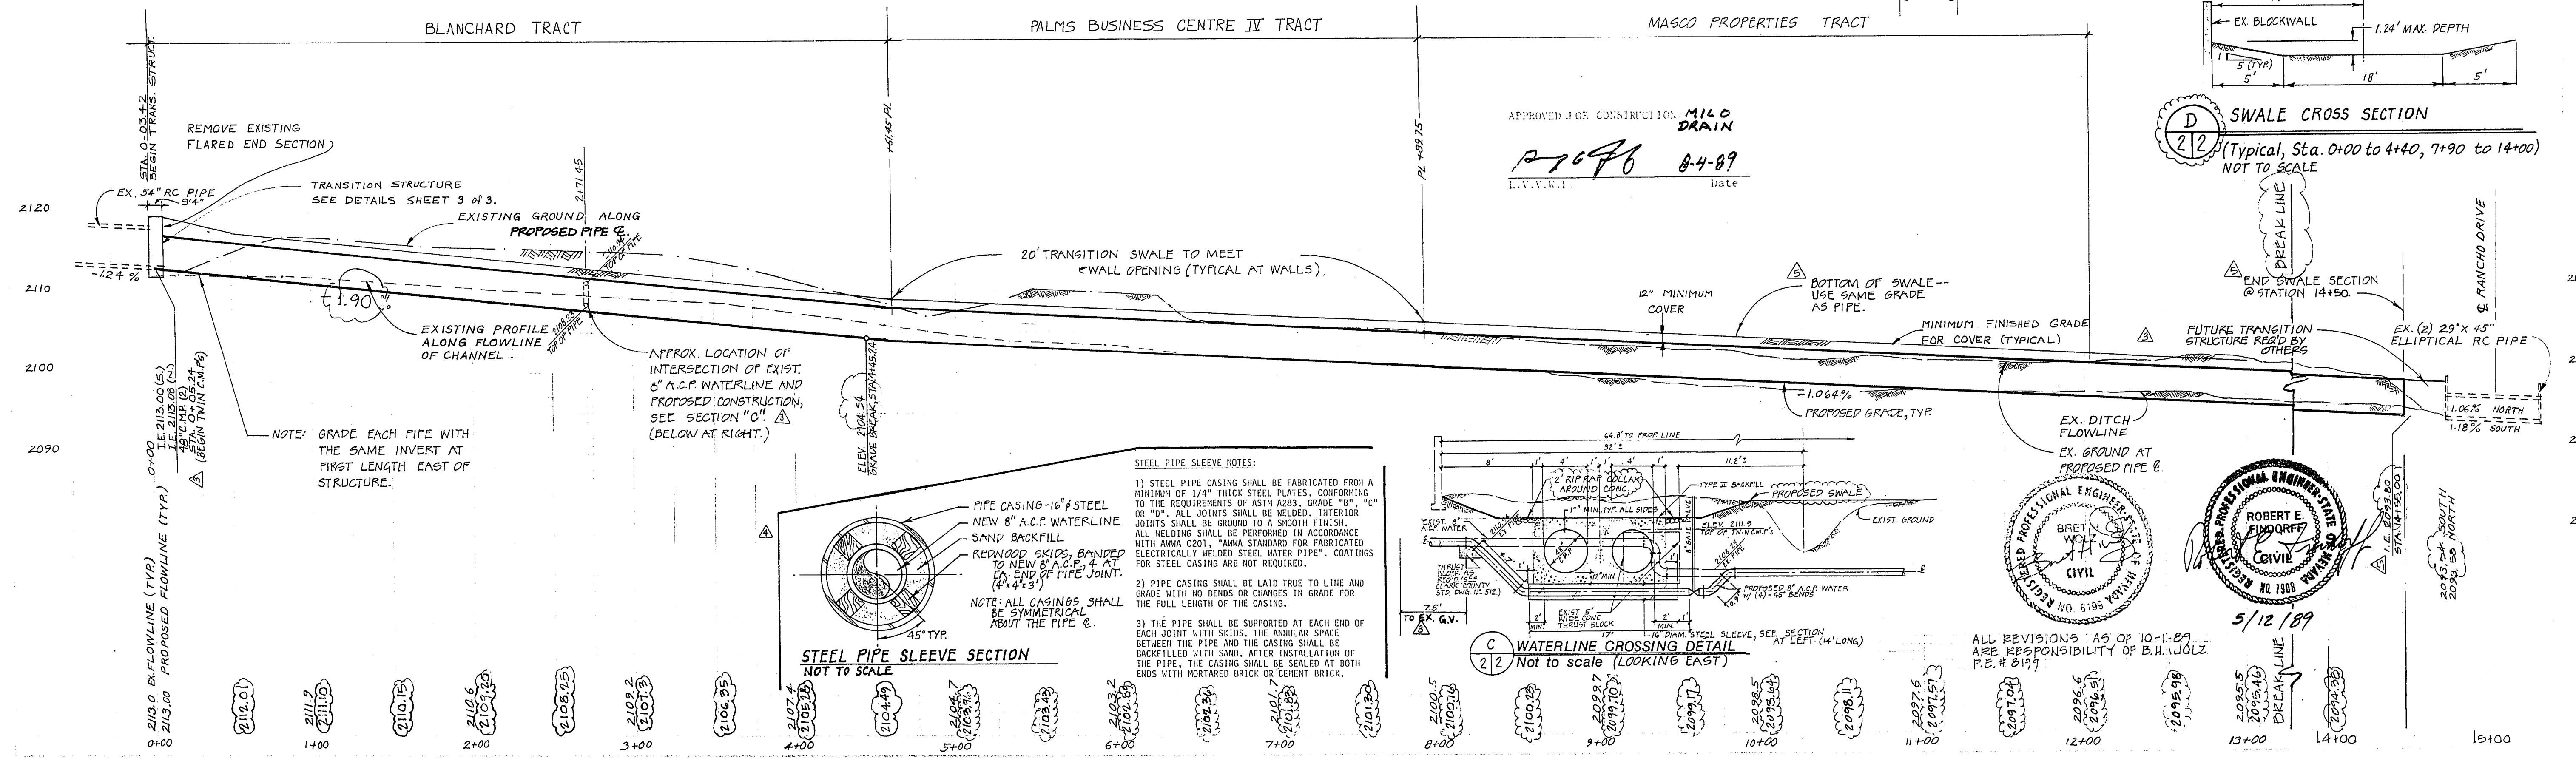

Job No.	7068.111
Scale	H:1"=50'
Sheet	2 of 3
Date	5-15-89
Drawn by	FMZ
Checked by	FMZ
Reviewed by	FMZ
Approved by	FMZ

RENE BLANCHARD
RANCHO RD. ASSOCIATES II
MIKE STOKELY

Prepared in the office of
Church Engineering, Inc.
2811 Meade Ave.
Las Vegas
Consulting Engineers
Planners
Surveyors
PHS 875-8020