



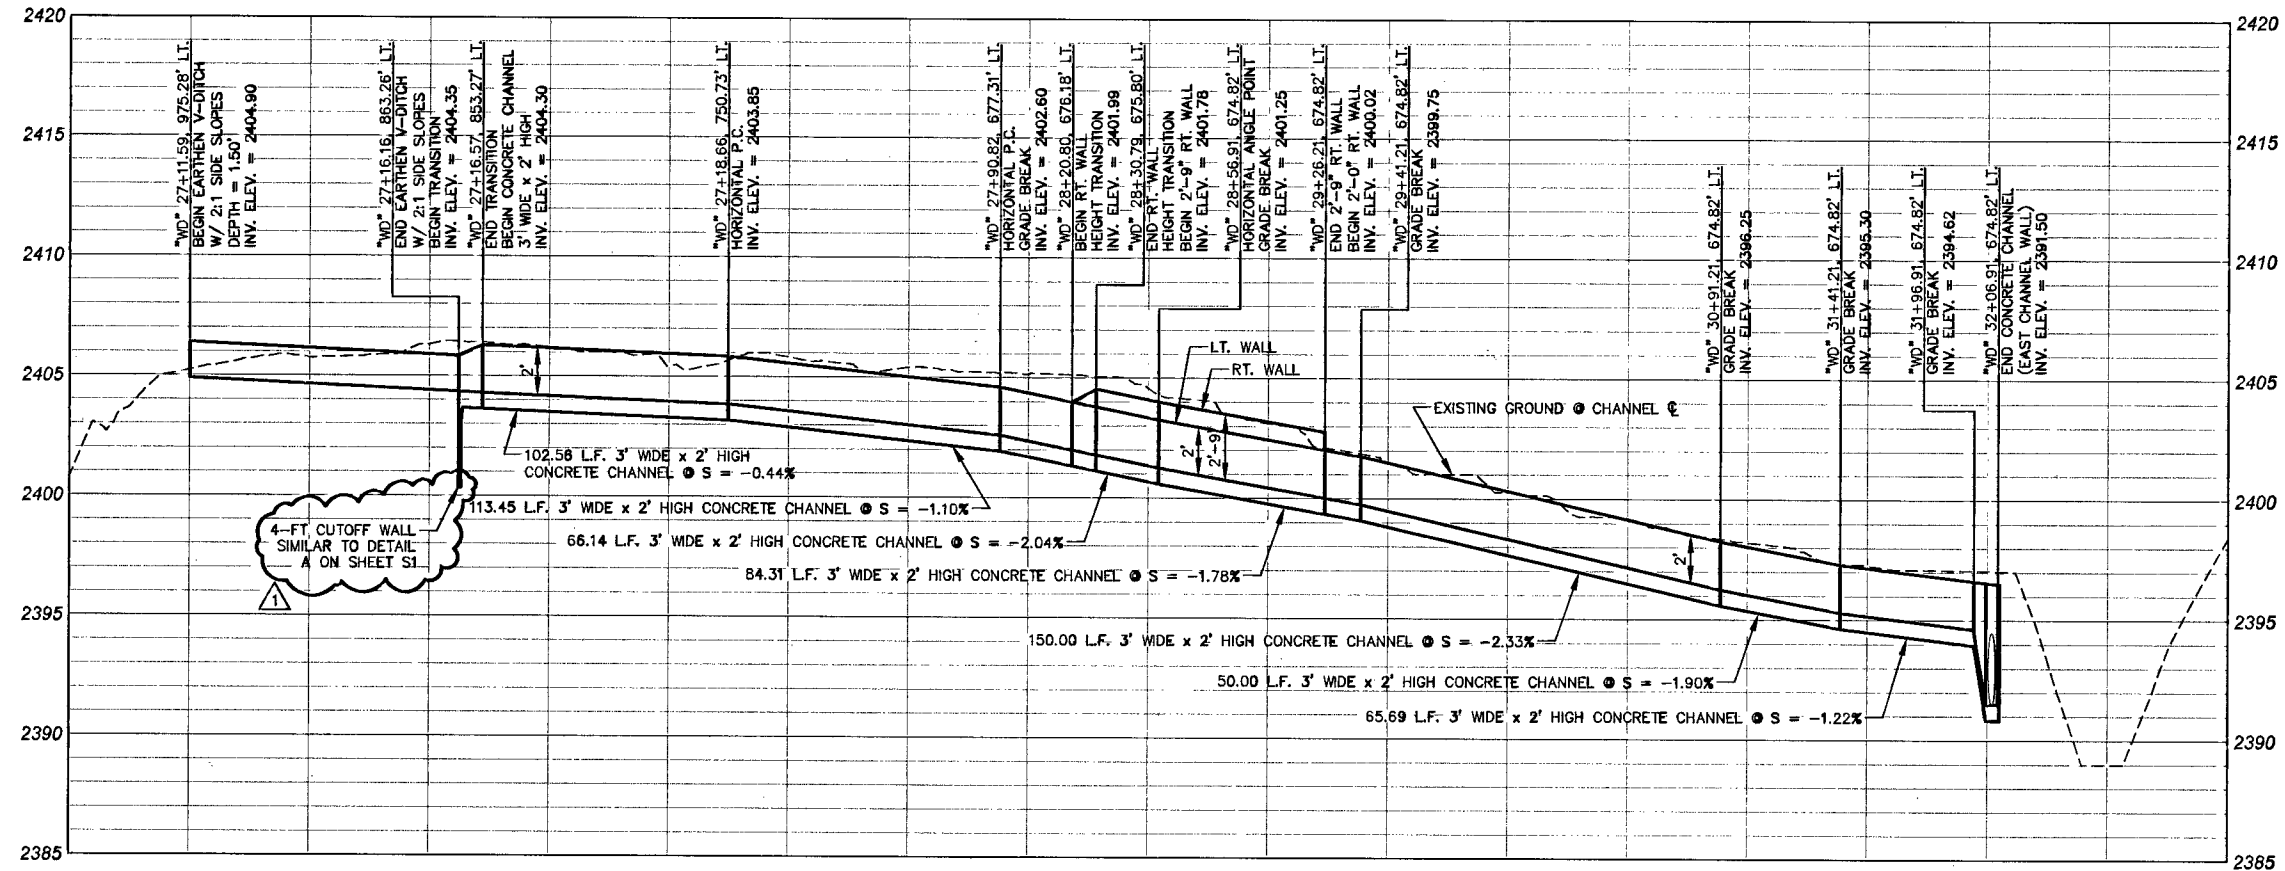

LATERAL #29 - WEST BASIN CHANNEL @ WEST & SOUTH PROPERTY LINE
(SEE SHEET G3)

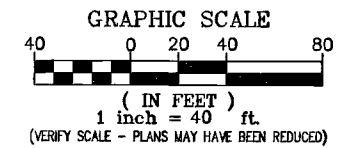

SHEET NOTES

1. REFER TO SHEETS R1 TO R8 FOR ROADWAY & UTILITY PLANS.
2. REFER TO SHEET D10 FOR "DM2A" & "DM2B" DROP INLET DETAILS.
3. REFER TO SHEET G14 FOR TRENCH DRAIN INLET LAYOUT DETAILS.
4. ALL PIPE SHALL BE GLASS III UNLESS NOTED OTHERWISE.

CONTRACTOR TO VERIFY ALL EXISTING UTILITY LOCATIONS BOTH HORIZONTALLY & VERTICALLY PRIOR TO COMMENCEMENT OF CONSTRUCTION

Call before you Overhead
1-702-227-2929
NEVADA POWER ENVIRONMENT AND SAFETY SERVICES DEPARTMENT

Call before you Dig
1-800-227-2008
1-702-456-7544

DEPARTMENT OF PUBLIC WORKS
400 E. STEWART AVE.
LAS VEGAS, NEVADA 89101
702-228-8272

STORM DRAIN LATERAL PROFILES

**MEADOWS ALTA PARALLEL PROJECT
PHASE II**

DRAWN BY: NOV 10, 2008
DESIGNED BY: NOV 10, 2008
CHECKED BY: NOV 10, 2008
PROJECT NO: 8812
SCALE: HORIZ. 1"=40'
VERT. 1"=4'

JEFFREY N. GRIEST
CIVIL
No. 17158
SHEET
SD21
33 OF 120 SHEETS
DRAWING NO.
327V281

HF11545