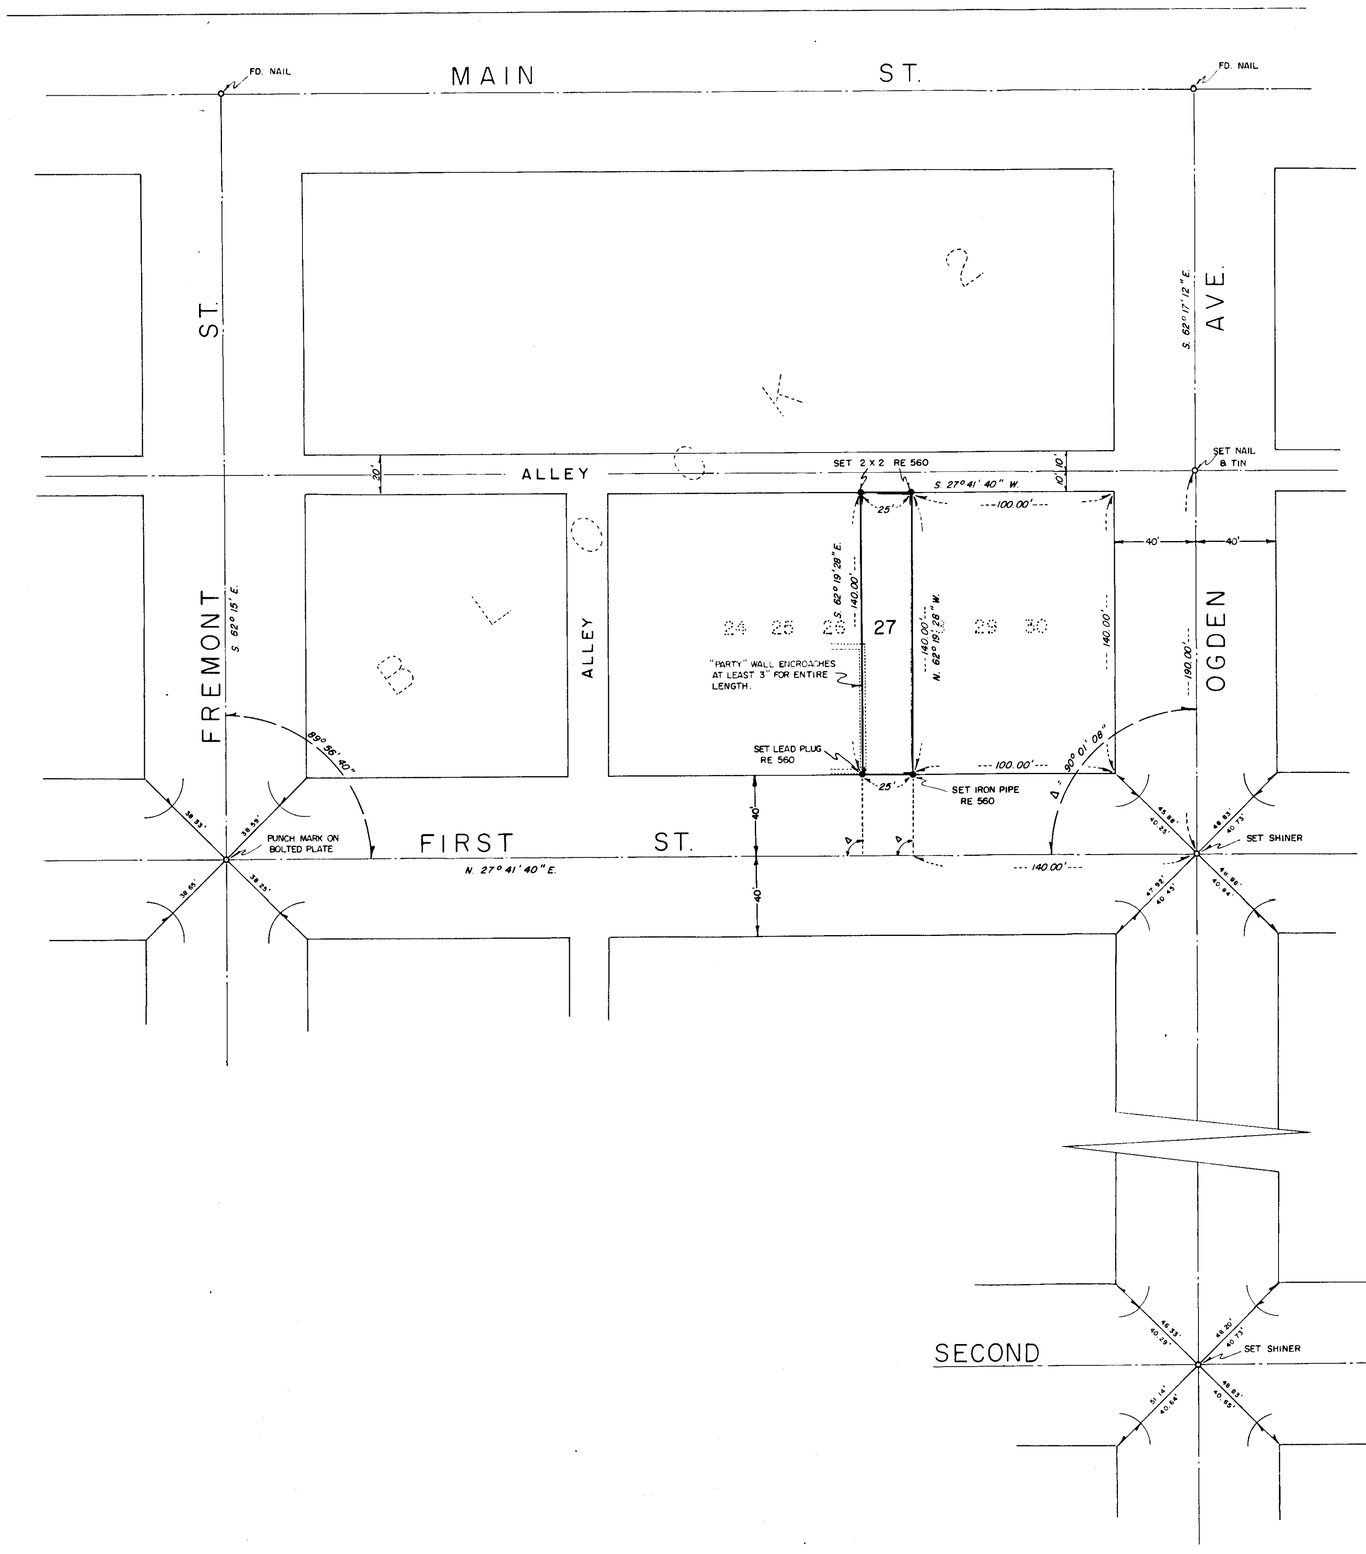

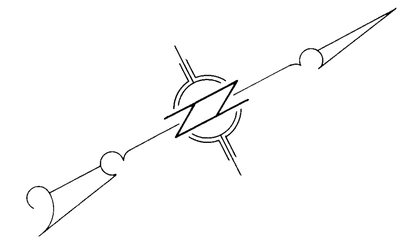

SCALE IN FEET

0 40 80 120 160 200

— LEGEND —

BASIS OF BEARING CENTER LINE OF FREMONT STREET, S. 62°15' E.

ENGINEER'S CERTIFICATE

I, L. E. TYSON, REGISTERED CIVIL ENGINEER AND LAND SURVEYOR, NEVADA Nº 560, DO HEREBY CERTIFY THAT THIS MAP IS A TRUE AND CORRECT PLAT OF THE LAND SURVEYED BY ME AT THE INSTANCE OF DENA GOLDRING, AND IS FURTHER DESCRIBED AS LOT 27, BLOCK 2, CLARK'S LAS VEGAS TOWNSITE, CITY OF LAS VEGAS, COUNTY OF CLARK, STATE OF NEVADA. THIS SURVEY WAS COMPLETED MAR 28, 1956.

L. E. Tyson

L. E. TYSON, REG. CIVIL ENG. & LAND SURVEYOR NEV. 560

80403

L. E. Tyson
6-12-56 2:53 p.m.
6 21

L. E. Tyson

97

MAP FOR RECORD OF SURVEY
FOR
DENA GOLDRING
LOT 27, BLOCK 2, CLARK'S LAS VEGAS TOWNSITE
M.D.B. & M.
CLARK COUNTY, NEVADA

055-126

File 6 PAGE 21

99-6