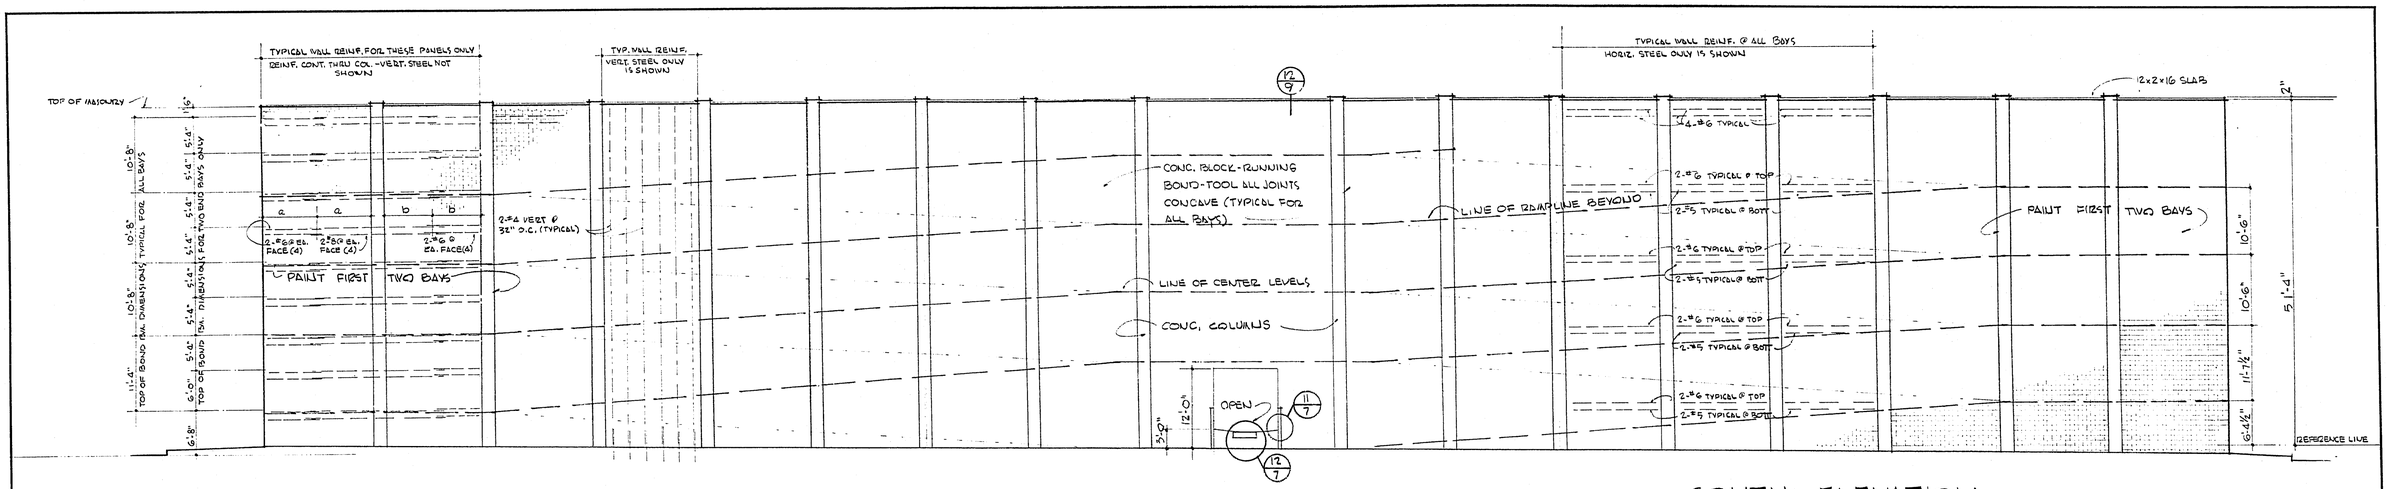

SOUTH ELEVATION

3/32" = 1'-0"

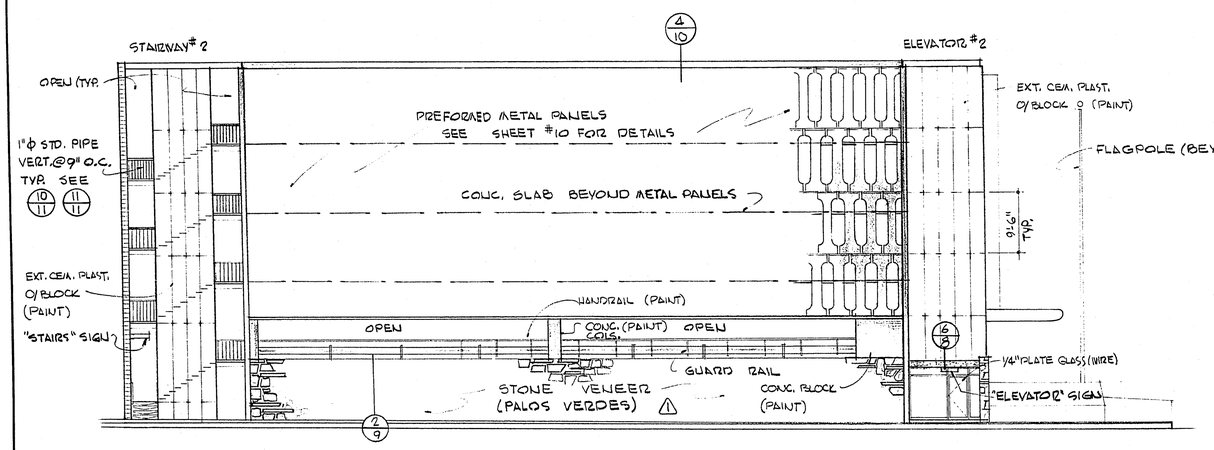

EAST ELEVATION

3/32" = 1'-0"

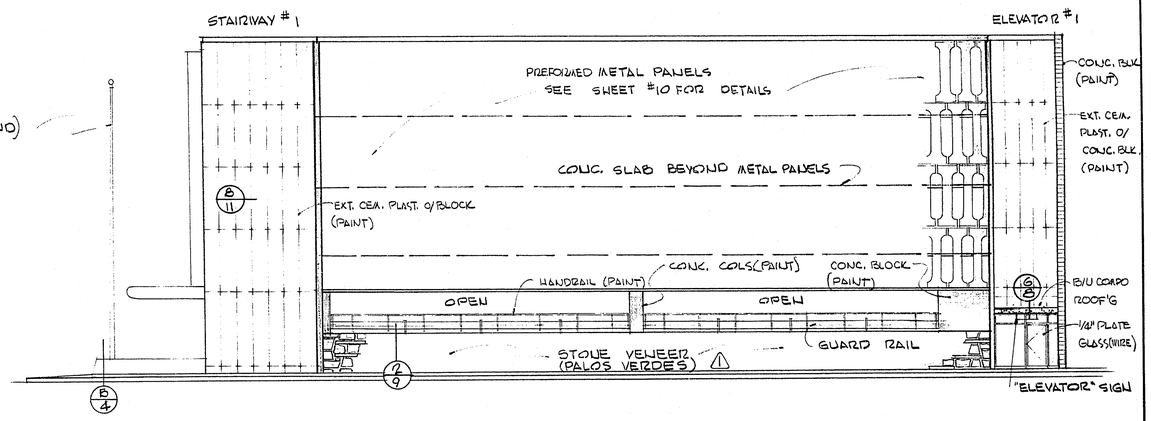

WEST ELEVATION

3/32" = 1'-0"

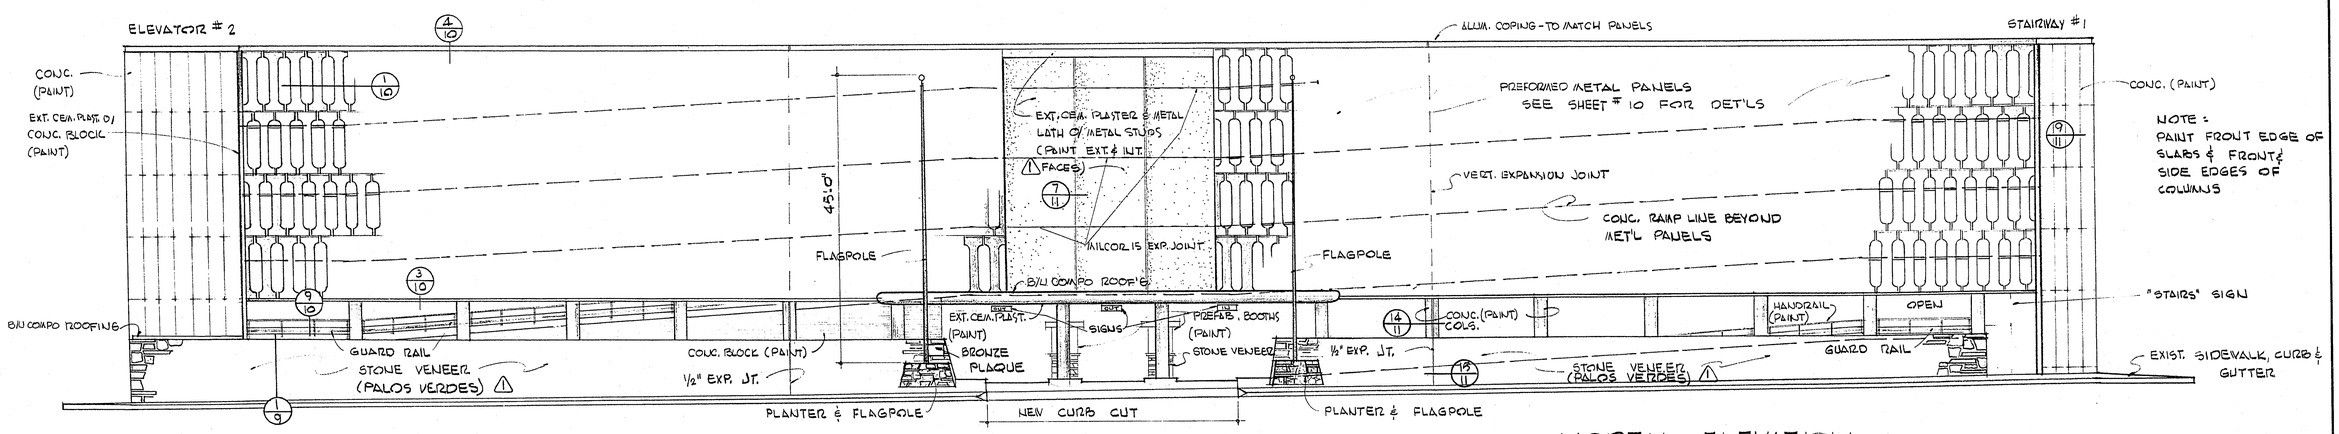

NORTH ELEVATION

3/32" = 1'-0"

THE DESIGNS AND IDEAS INDICATED BY THESE DRAWINGS WERE CREATED FOR USE ON THIS PROJECT ONLY AND ARE THE PROPERTY OF EDWARD B. HENDRICKS ASSOC. THEY MAY NOT BE USED FOR ANY OTHER PURPOSE WHATSOEVER WITHOUT THE WRITTEN PERMISSION OF THE OFFICE OF EDWARD B. HENDRICKS ASSOCIATES.

EDWARD B. HENDRICKS ASSOCIATES
ARCHITECTURE • PLANNING • ENGINEERING
E. B. HENDRICKS A.I.A.
FRED L. KENNEDY
G. L. JACOBSON
537 E. SAHARA AVE.
LAS VEGAS, NEVADA
PHONE • 735-0902

MUNICIPAL PARKING GARAGES
CITY OF LAS VEGAS NEVADA
OGDEN SITE
DIRECTOR OF PUBLIC WORKS

EXTERIOR ELEVATIONS

DATE	SHEET	OF
9-8-66	3	12
JOB NO.		I.D. 14
DRAWN BY CLARK		

DATE	BY	REVISIONS
	J.C.	⚠ CLARIFICATION REVISION

6/66 DIETERICH-POST CLEARPRINT 1020-B

2-74

512-V38