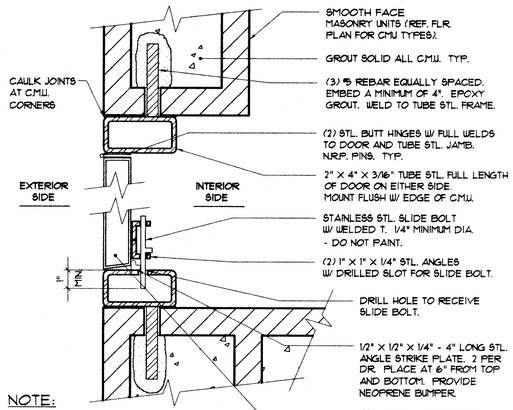

NOTE:
- GRIND SMOOTH AND ROUND ALL WELDS PAINT TO MATCH FRAME AND DOOR. TYP.
- PAINT ALL HARDWARE U.N.O. TO MATCH FRAME AND DOOR. TYP.
- EDGES OF ALL MTL. TO RADIUSED 1/16" ¢ GROUND SMOOTH.

1 Jambs - Hinge and Latch Sides

Scale: 3"=1'-0" 08100-22 A6-01

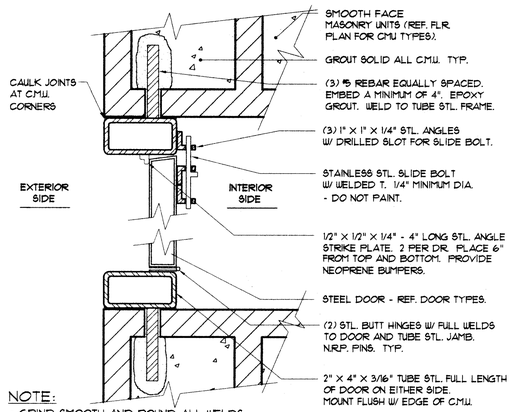

NOTE:
- GRIND SMOOTH AND ROUND ALL WELDS PAINT TO MATCH FRAME AND DOOR. TYP.
- PAINT ALL HARDWARE U.N.O. TO MATCH FRAME AND DOOR. TYP.
- EDGES OF ALL MTL. TO BE RADIUSED 1/16" ¢ GROUND SMOOTH.

2 Jambs - Hinge and Latch Sides

Scale: 3"=1'-0" 08100-23 A6-02

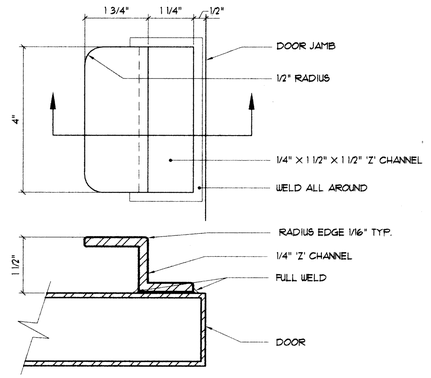

NOTE:
- GRIND SMOOTH AND ROUND ALL WELDS PAINT TO MATCH FRAME AND DOOR. TYP.
- PAINT ALL HARDWARE U.N.O. TO MATCH FRAME AND DOOR. TYP.
- EDGES OF ALL MTL. TO BE RADIUSED 1/16" ¢ GROUND SMOOTH.

3 Pull Handle

Scale: 6"=1'-0" 08100-24 A6-03

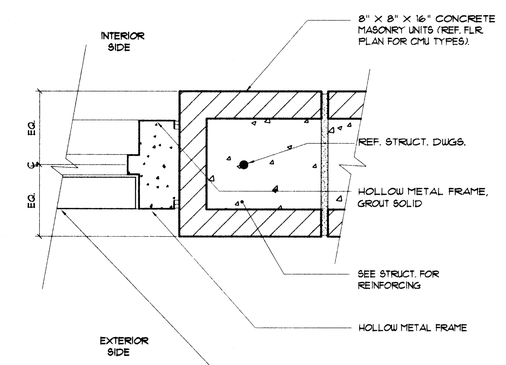

NOTE:
PROVIDE ANCHORS PER MFR. SPECS.
4" HEAD / 2" JAMB @ MASONRY (TYP.).

4 Jamb

LATCH SIDE

Scale: 3"=1'-0" 08100-XX A6-04

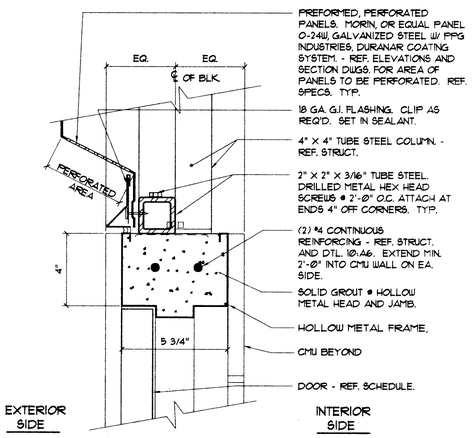

5 Head @ H.M. Frame

Scale: 3"=1'-0" XXXXX-XX A6-05

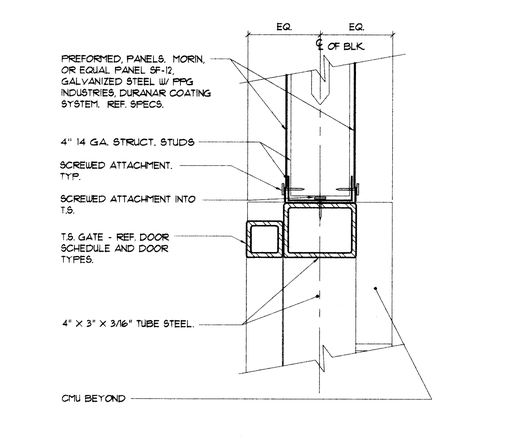

6 Head @ T.S. Gate

Scale: 3"=1'-0" XXXXX-XX A6-06

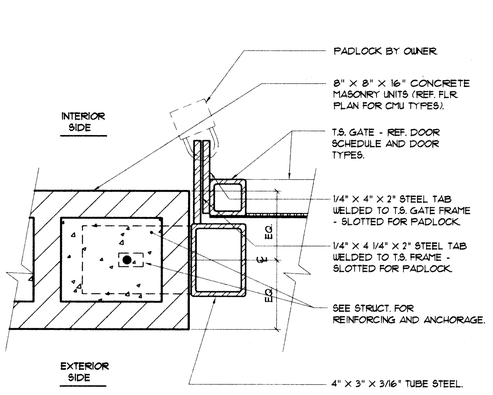

7 Jamb Det. @ Gate

LATCH SIDE

Scale: 3"=1'-0" 08100-XX A6-07

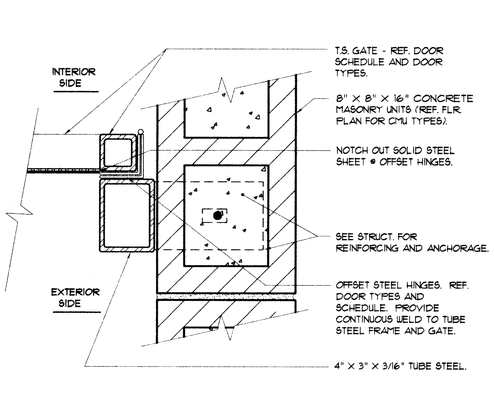

8 Jamb Det. @ Gate Hinge

LATCH SIDE

Scale: 3"=1'-0" 08100-XX A6-08

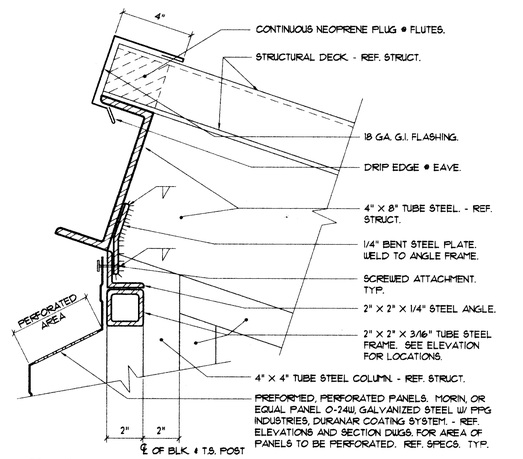

67599

9 Top @ End Wall

Scale: 3"=1'-0" 05100-XX A6-09

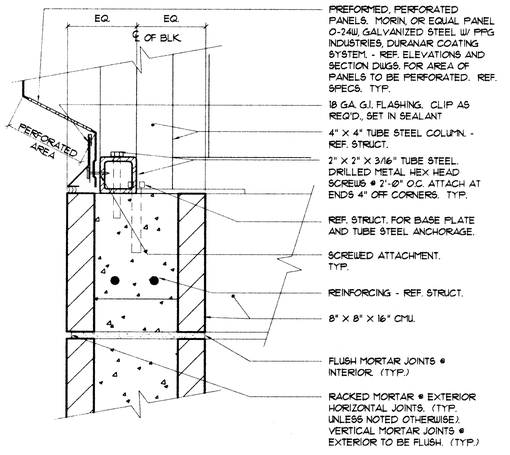

10 End Wall

Scale: 3"=1'-0" 05100-XX A6-10

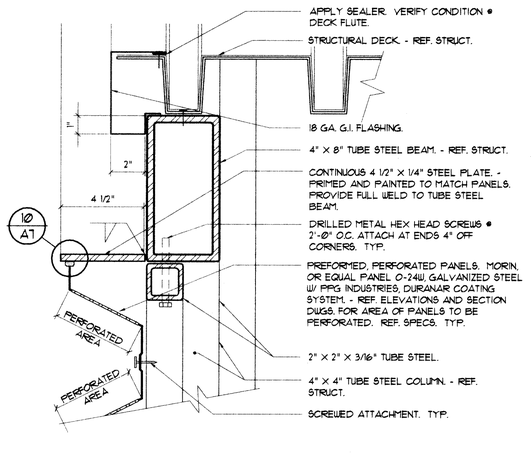

11 Detail @ Side Wall

Scale: 3"=1'-0" 05100-XX A6-11

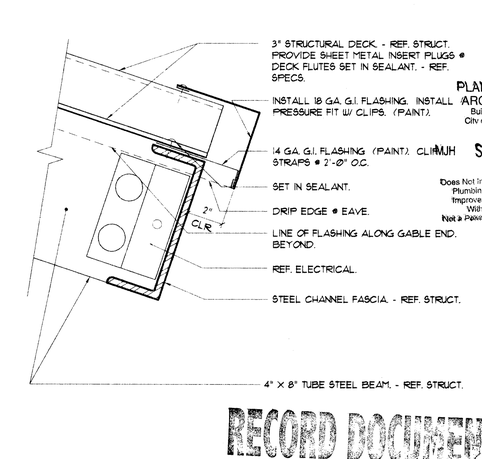

PLANS APPROVED
ARCHITECTURAL
Building & Safety Dept.
City of Las Vegas, Nevada

MJH SEP 12 2000

Does Not Include Structural, Electrical, Plumbing/Mechanical or Off-Site Improvements Make No Changes Without Approval Plans is Not a Permit to Violate Any Ordinance

RECORD DOCUMENTS

12 Detail @ Cantilever Fascia

Scale: 3"=1'-0" 05100-XX A6-12

CITY OF LAS VEGAS NEVADA

REVISIONS

CONSULTANT

DEPARTMENT OF PUBLIC WORKS

City of Las Vegas
Metro Park
3250 Academy Way, Las Vegas, NV 89129
- Restroom Facility (Prototype One) -
Miscellaneous Details

RICHARD D. DANIELSON REGISTERED No. 1757 ARCHITECT STATE OF NEVADA
5 SEPT 00

DEPARTMENT OF PUBLIC WORKS
ARCHITECTURAL SERVICES
400 EAST STEWART AVENUE
LAS VEGAS, NEVADA 89101
PHONE: (702) 229-6535
FAX: (702) 382-3232
TDD: (702) 386-9108

ARCHITECT
RICHARD DANIELSON, AIA, NCARB

DRAWN: BBREED
FILE: parks/metro/met06a6
DATE: 9-1-00
SCALE: Full Scale
PROJECT: metro park
SHT NO: 28

A6
55 of 64

650.58

DRAWINGS AS INSTRUMENTS OF SERVICE ARE THE PROPERTY OF THE DESIGN PROFESSIONAL WHETHER THE PROJECT FOR WHICH THEY ARE MADE IS EXECUTED OR NOT. THE REUSE OF THESE DRAWINGS AND SPECIFICATIONS ON ANY OTHER PROJECT IS PROHIBITED AND IS UNLAWFUL WITHOUT THE EXPRESS WRITTEN PERMISSION OF THE DESIGN PROFESSIONAL. VISUAL CONTACT WITH THESE DRAWINGS AND SPECIFICATIONS SHALL CONSTITUTE PRIMA FACIE EVIDENCE OF ACCEPTANCE OF THESE RESTRICTIONS. ANY UNAUTHORIZED USE, REPRODUCTION OR PUBLICATION BY ANY METHOD, IN WHOLE OR IN PART, IS PROHIBITED. TITLE TO THESE DRAWINGS AND SPECIFICATIONS SHALL NOT PASS TO THE OWNER UNTIL FINAL PAYMENT HAS BEEN MADE.