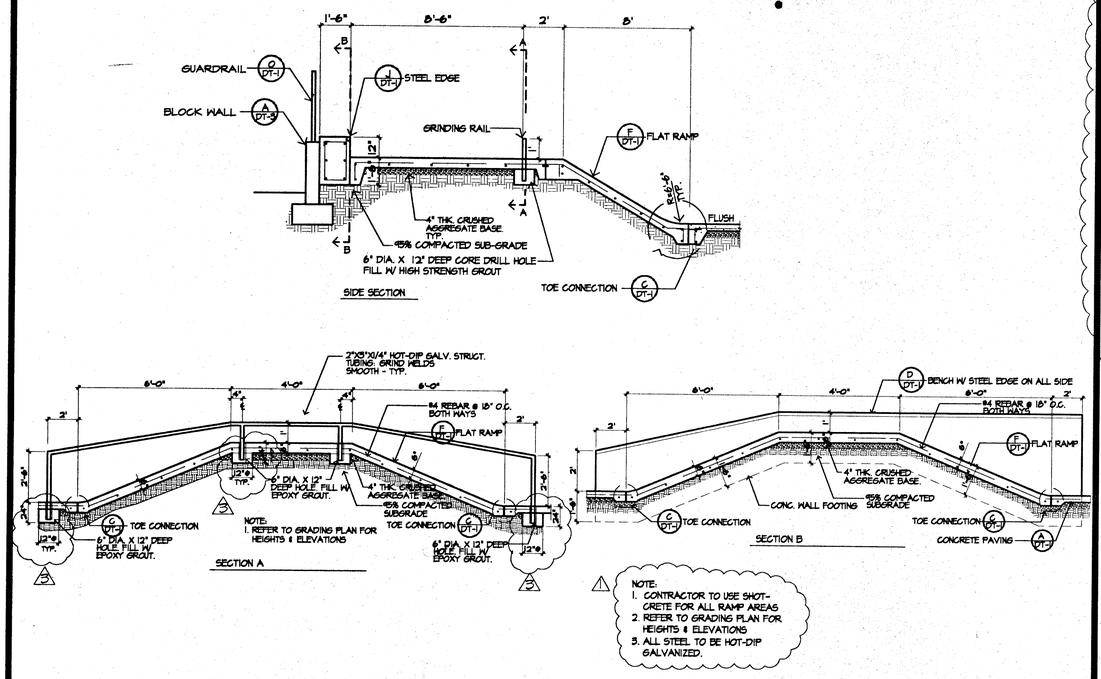

E FUNBOX WITH LEDGE AND RAIL — NO SCALE

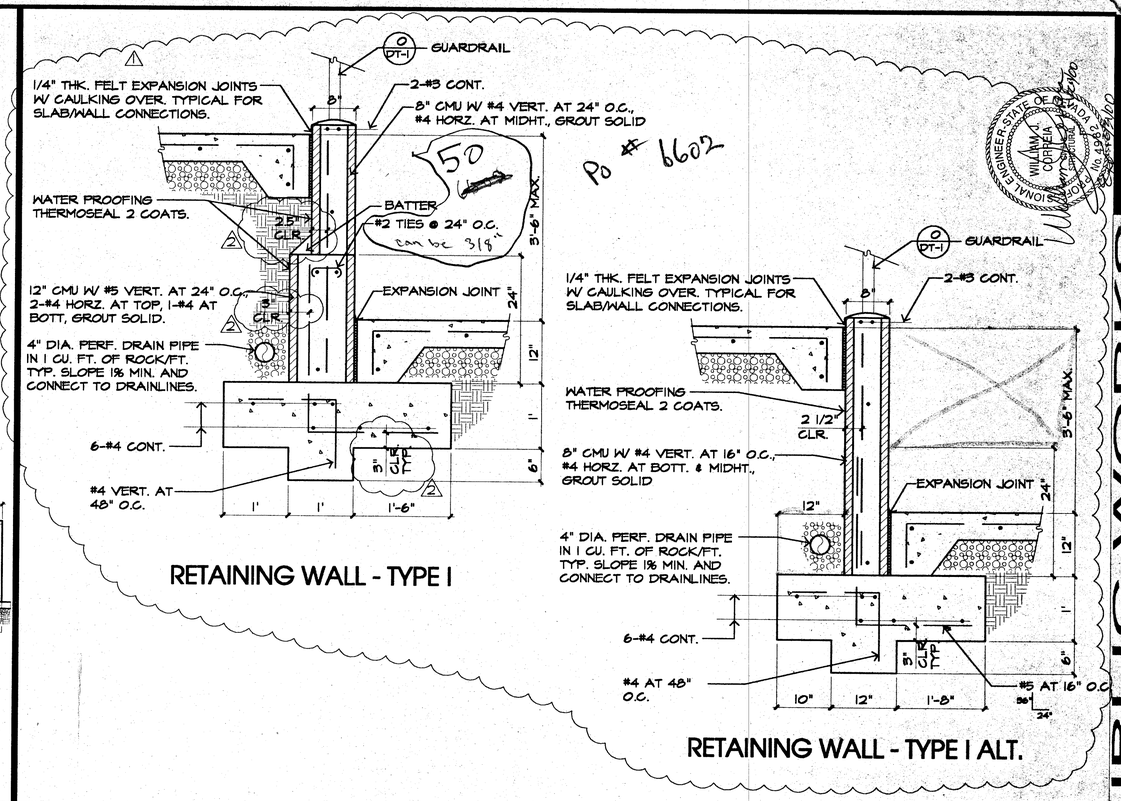

A BLOCK RETAINING WALL — NO SCALE

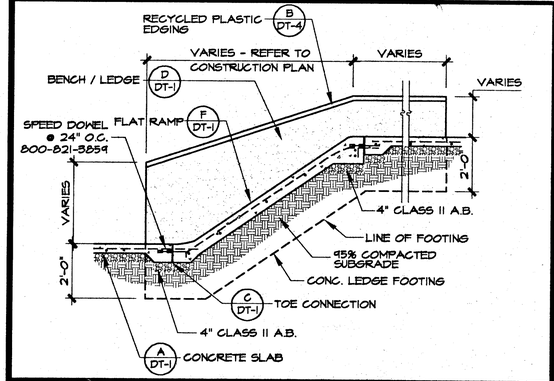

H SLOPED LEDGE — NO SCALE

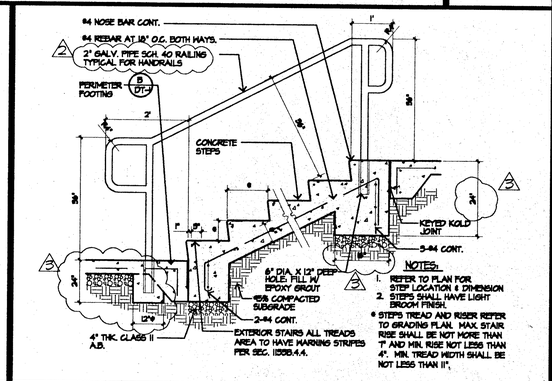

F HANDRAIL AT STEPS — NO SCALE

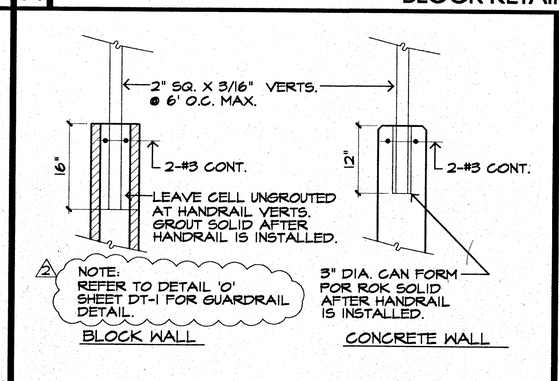

C RAIL TO WALL CONNECTION — NO SCALE

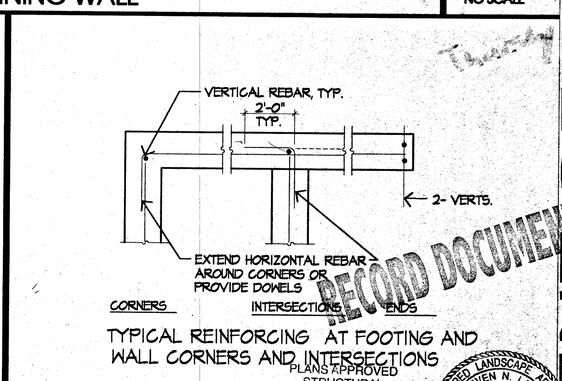

B TYPICAL REINFORCING DETAIL — NO SCALE

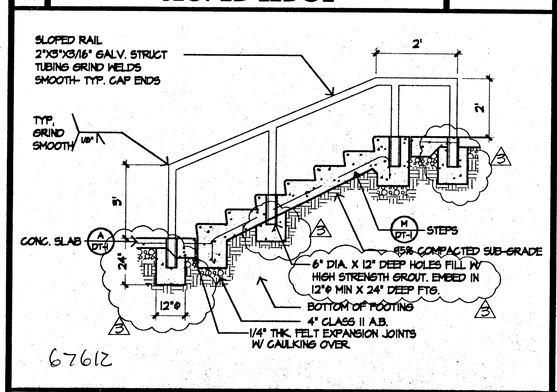

I SLOPED RAIL @ STEPS — NO SCALE

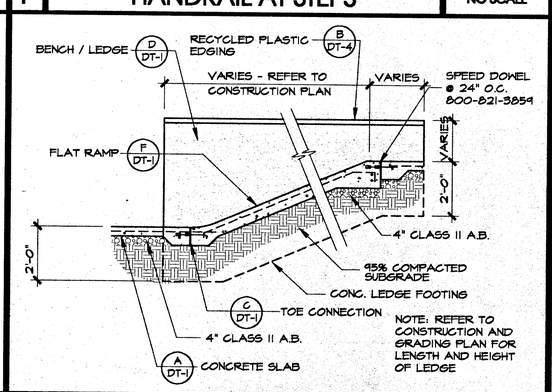

G STRAIGHT LEDGE — NO SCALE

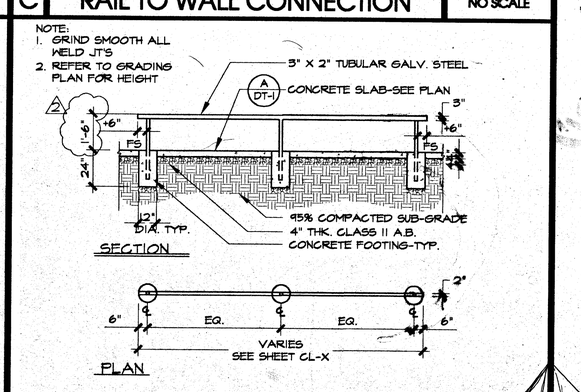

D FLAT RAIL — NO SCALE

PUBLIC WORKS

DEPARTMENT OF PUBLIC WORKS

CITY OF LAS VEGAS
METRO PARK
3250 ACADEMY WAY
LAS VEGAS, NEVADA 89129

CONSTRUCTION DETAILS

CONSULTANT
PBSJ
801 N. Green Valley Parkway, Suite 2014
Henderson, Nevada 89074
Telephone (702) 562-8820
Fax (702) 562-8821
ENGINEERING - PLANNING - SURVEYING
CONSTRUCTION SERVICES

DEPARTMENT OF PUBLIC WORKS
ARCHITECTURAL SERVICES
400 EAST STEWART AVENUE
LAS VEGAS, NEVADA 89101
PHONE: (702) 229-6535
FAX: (702) 382-3232
TDD: (702) 386-9108

PROJECT MANAGER	CLAIR M. LEWIS, ASLA
DRAWN	J.S.K.
FILE	00-106
DATE	11-28-00
SCALE	AS NOTED
PROJECT	METRO PARK
SHEET NO	41

DT-3