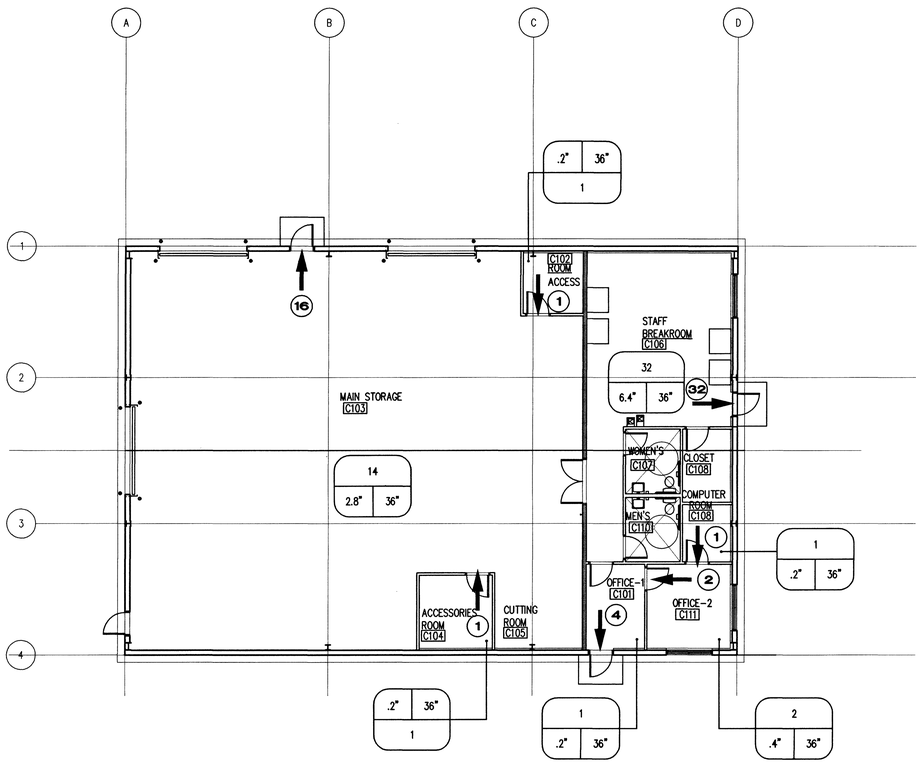

EXITING PLAN - MAINTENANCE BUILDING 'C'

SCALE: 1/8"=1'-0"

F.F. ELEVATION = 100'-0"

GENERAL NOTES

1. 36" DOORS = 33.5" CLEAR
2. (2) 36" DOOR = 67.0" CLEAR

SYMBOL LEGEND

(X) → TOTAL NUMBER EXITING ROOM

NUMBER OF OCCUPANTS

XX

XX | XX

DOOR WIDTH PROVIDED IN INCHES (PER UBC TABLE 10-B)

DOOR WIDTH REQUIRED IN INCHES (32" MIN.) (PER UBC TABLE 10-B)

ROOM NAME
XXX

ROOM NAME

ROOM NUMBER

AREA (S.F.) / S.F. / PERSON= TOTAL NUMBER OF OCC. (ROUNDED UP)

P.H. PANIC HARDWARE

EXITING ROUTE

AS-BUILT RECORD DRAWING

CONSTRUCTION CHANGES SHOWN HEREON ARE BASED ON DATA FURNISHED BY THE CONTRACTOR

CITY OF LAS VEGAS NEVADA

PUBLIC WORKS

REVISIONS

All designs, arrangements and plans indicated or presented by this drawing or instrument of service, are owned by and the property of DOMINGO CAMBEIRO CORP. - ARCHITECTS. To alter these documents for any project by anyone other than DOMINGO CAMBEIRO CORP. - ARCHITECTS is a violation. The plans and/or specifications shall be restricted to the original site for which they were prepared and publication thereof is expressly limited to such use. Reproduction, publication, or re-use by any method in whole or in part, is prohibited. Title to existing information and drawings shall be used by or disclosed to any person, firm, agency, company or corporation without the written permission of DOMINGO CAMBEIRO CORP. - ARCHITECTS. Visual contact with these drawings or specifications constitute prima facie evidence of acceptance of these restrictions.

© DOMINGO CAMBEIRO CORP. - ARCHITECTS 2001

CONSULTANT

Domingo Cambeiro Corp. - ARCHITECTS
3555 RECOS-McLEOD IC.
LAS VEGAS, NEVADA 89121-3805
(702) 732-0084 FAX: 732-9402

NORTHWEST FAMILY GOLF COURSE AND PARK

MAINTENANCE BLDG. "C" FLOOR PLANS

DURANGO/GOWAN ROAD

LAS VEGAS, NEVADA

STAMP

OWNER: CITY OF LAS VEGAS
DEPARTMENT OF PUBLIC WORKS
ARCHITECTURAL SERVICES

400 EAST STEWART AVENUE
LAS VEGAS, NEVADA 89101
PHONE: (702) 229-6535
FAX: (702) 382-3232
TDD: (702) 386-9108

DRAWN

FILE 469X101C.DWG

DATE 05-18-01

SCALE

BND NO.

JOB NO. 01469

SHEET NO. AX1.01C

650.66 %

DRAWINGS AS INSTRUMENTS OF SERVICE ARE THE PROPERTY OF THE DESIGN PROFESSIONAL WHOSE STAMP OF CERTIFICATION APPEARS ON THE DRAWINGS AND SPECIFICATIONS AND MUST BE UTILIZED WITH CONSENT OF THE CLIENT AND BE UTILIZED WITH CONSENT OF THE DESIGN PROFESSIONAL. ANY USE OR REPRODUCTION IN WHOLE OR IN PART WITHOUT WRITTEN CONSENT IS STRICTLY PROHIBITED. COPIES OF THE DRAWINGS AND SPECIFICATIONS MAY BE OBTAINED FOR BIDDING, THE CONSENT FOR BIDDING USE DOES NOT CONSTITUTE THE CONSENT FOR CONSTRUCTION AND NOT FOR THE CONSTRUCTION OF ANY OTHER PROJECT. R.S. 623.190

50078

02/18/03 03:29PM